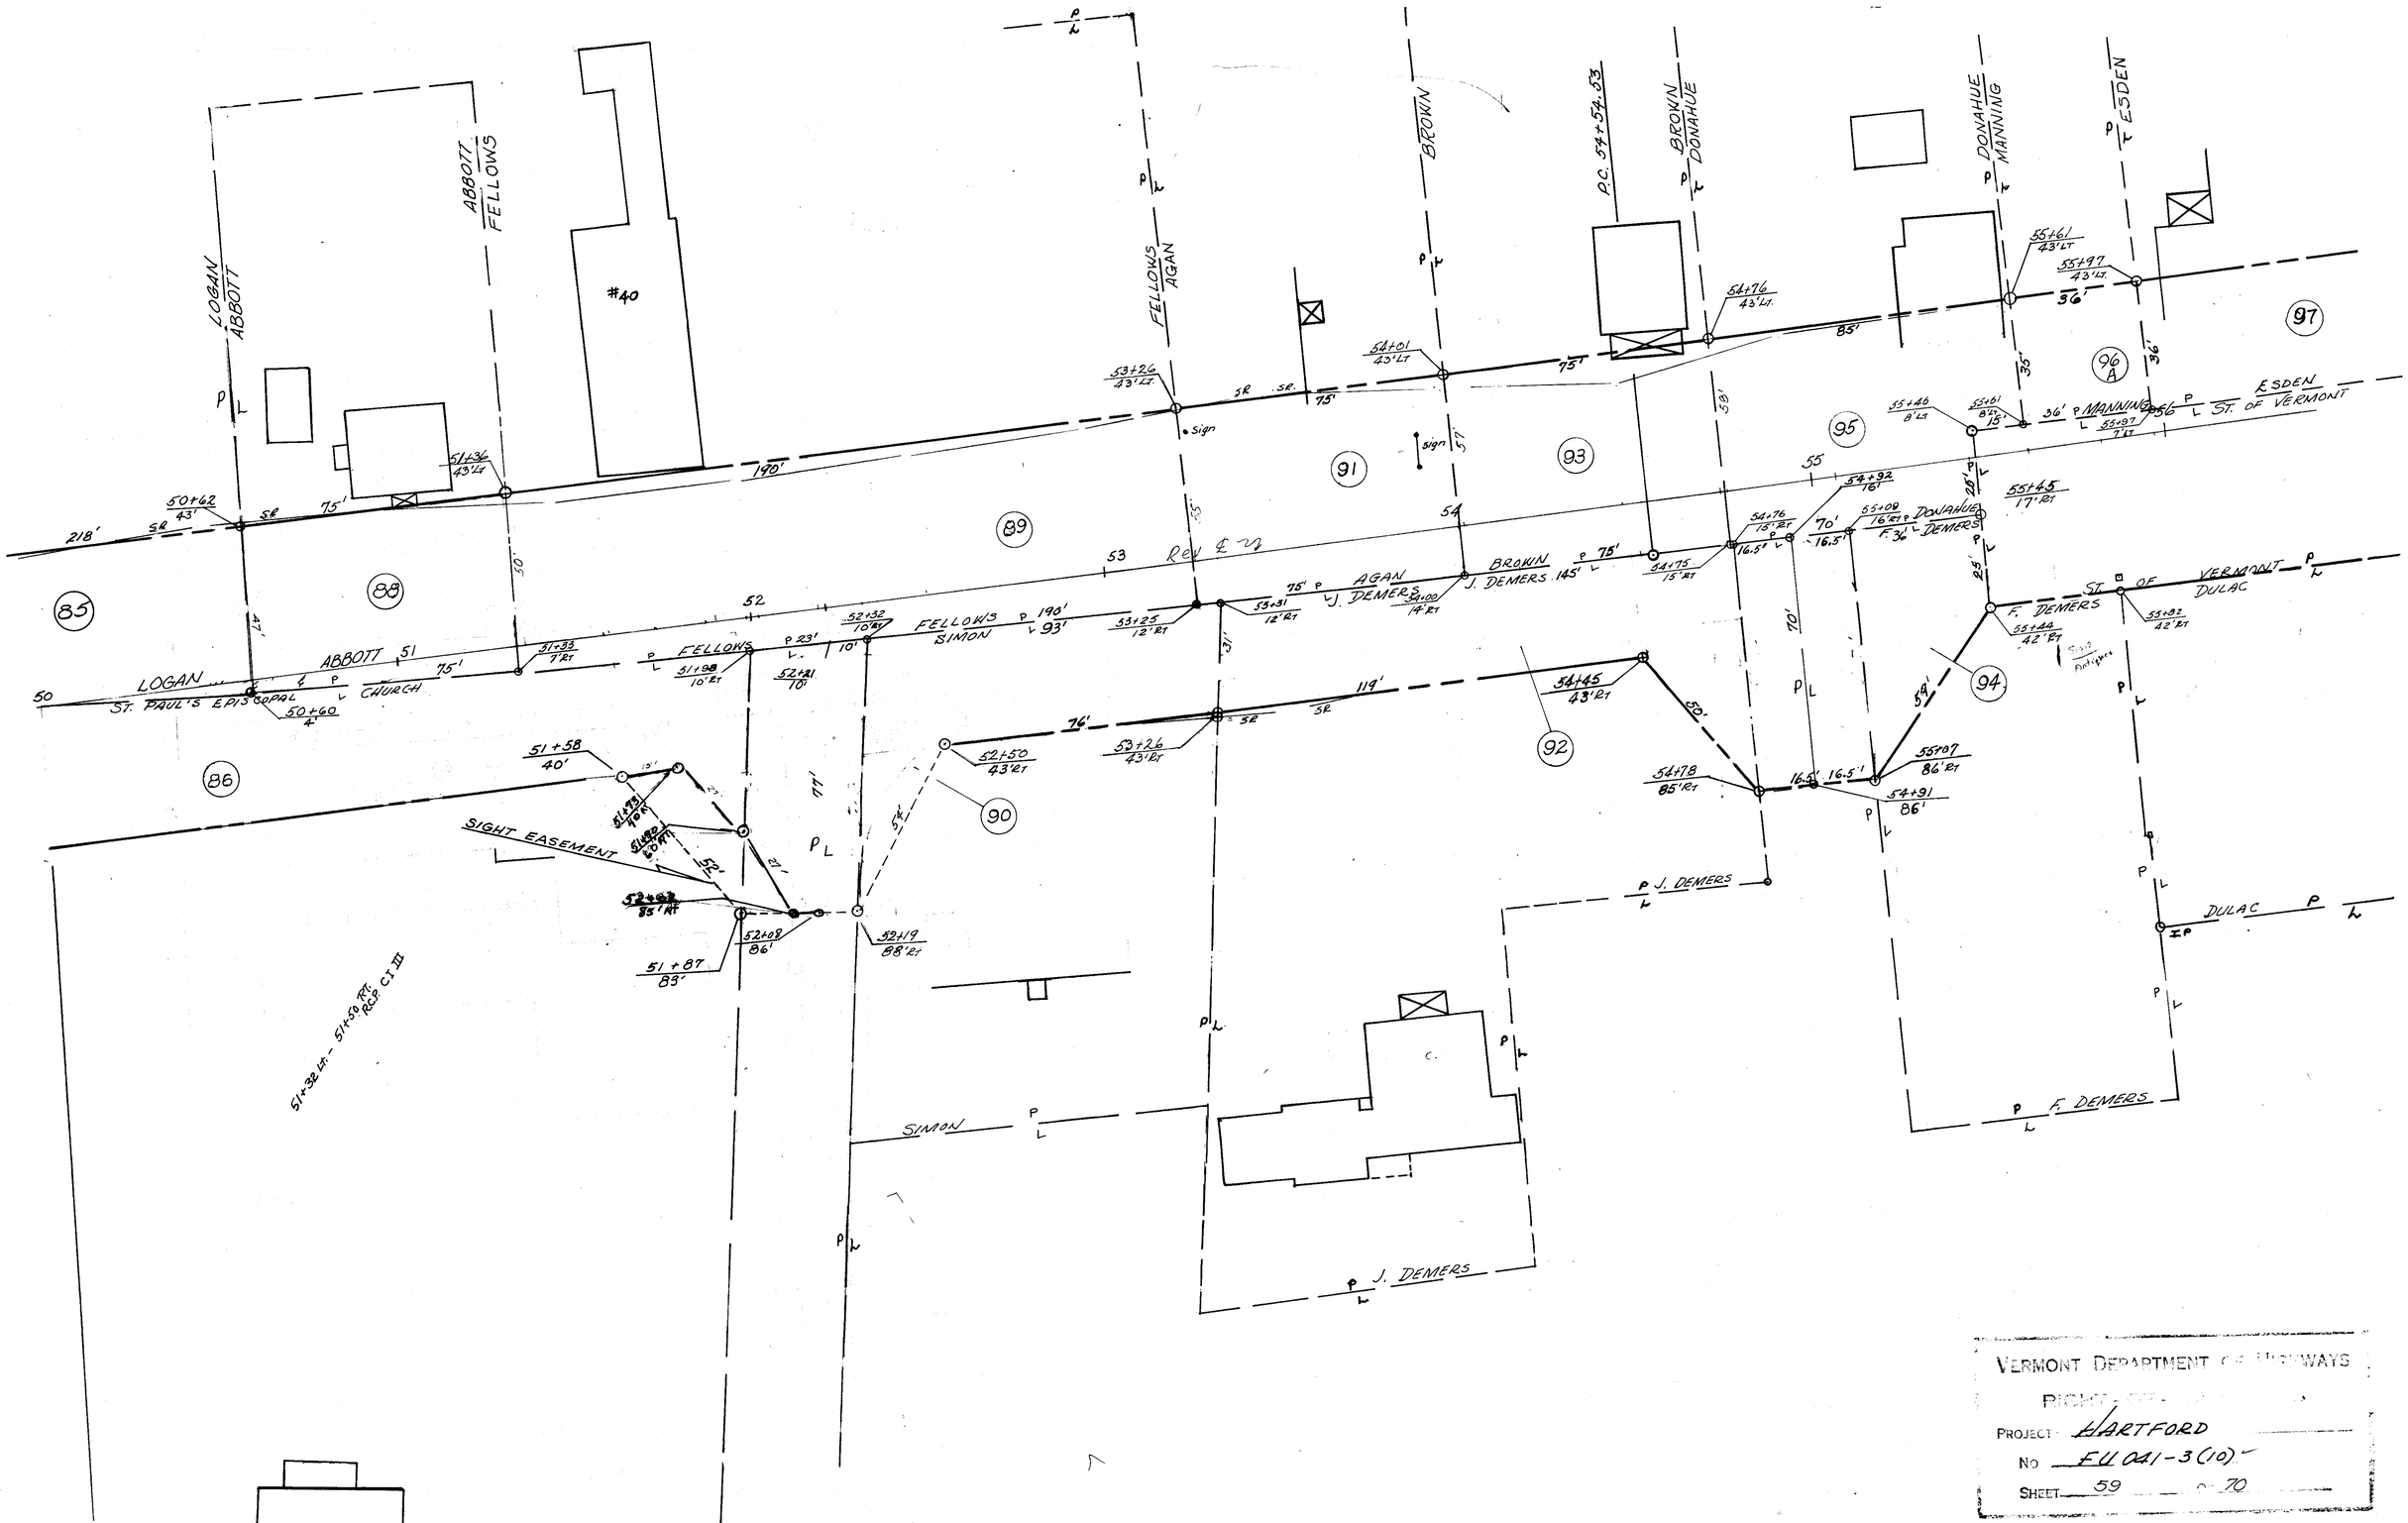

VERMONT DEPARTMENT OF HIGHWAYS
RIGHT OF WAY
PROJECT: HARTFORD
NO. FU 041-3(10)
SHEET 59 OF 70

12