METRIC

1. ALL DIMENSIONS ARE IN MILLIMETERS UNLESS OTHERWISE NOTED.
2. ALL WEIGHTS ARE IN KILOGRAMS.

FED. ROAD DIV. NO.	STATE	FED. AID PROJ. NO.
	VT	

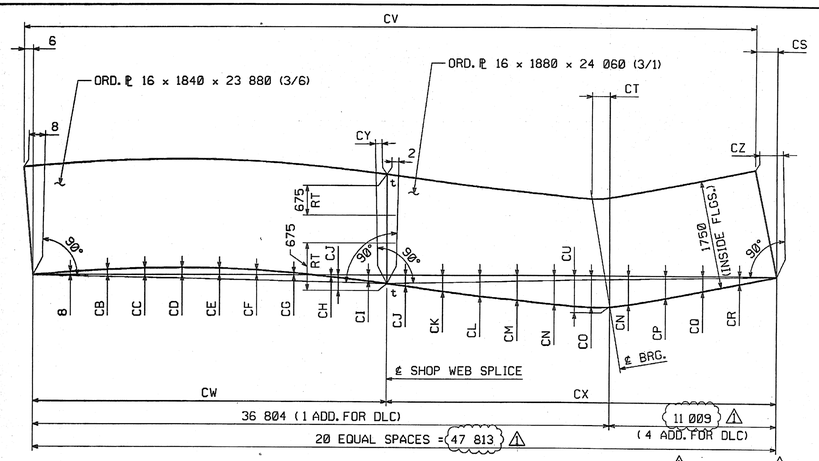

MARK	CB	CC	CD	CE	CF	CG	CH	CI	CJ	CK	CL	CM	CN	CO	CP	CQ	CR	CS	CT	CU	CV	CW	CX	CY	CZ
G5P THRU G8P	15	18	20	18	13	5	-5	-16	-29	-43	-55	-66	-77	-85	-59	-40	-21	15	33	-84	47 804	23 803	24 010	2	13
G9Y THRU G12Y	14	17	18	16	11	3	-8	-20	-33	-47	-60	-71	-83	-91	-63	-43	-22	16	34	-90	47 803	23 804	24 009	3	14

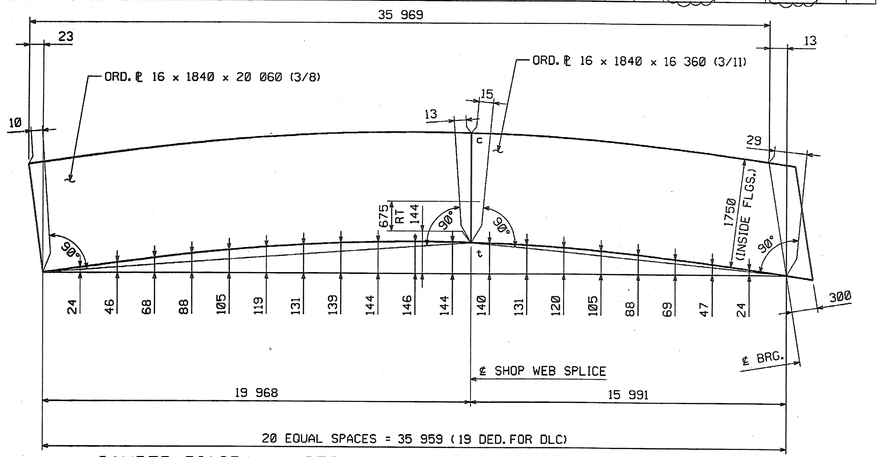

CAMBER DIAGRAM - G5Q, G6Q, G7Q, G8Q, G9Z, G10Z, G11Z, & G12Z

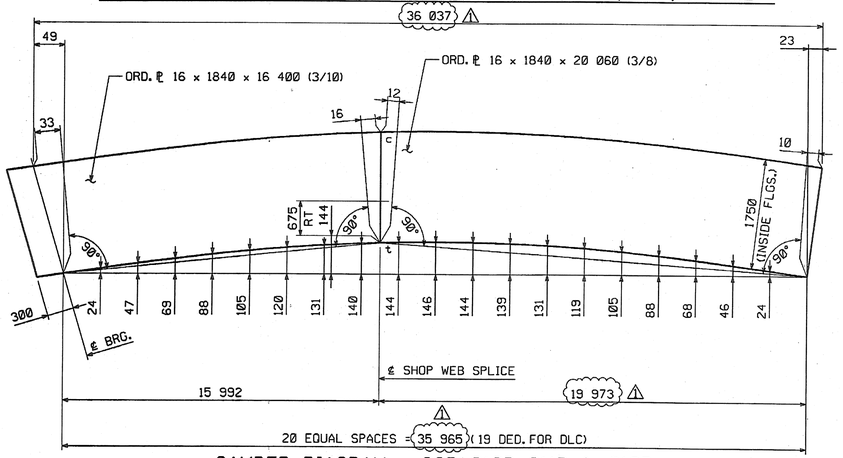

CAMBER DIAGRAM - G9R, G10R, G11R, & G12R

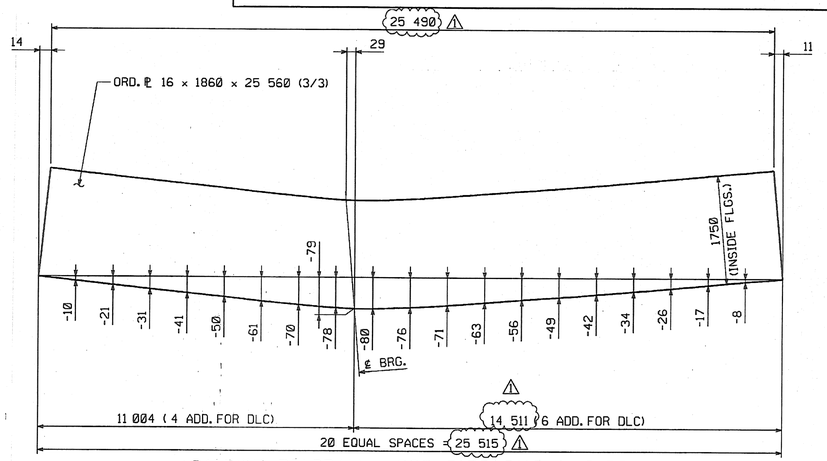

CAMBER DIAGRAM - G9S, G10S, G11S, & G12S

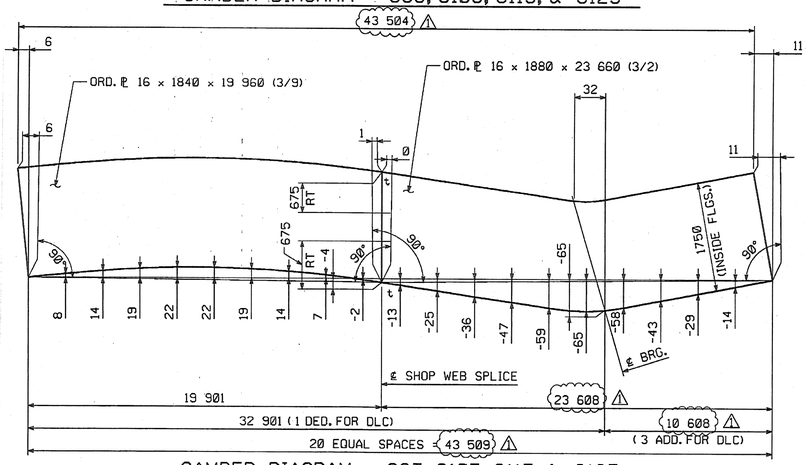

CAMBER DIAGRAM - G9T, G10T, G11T, & G12T

NOTES:

FOR WELDING DETAILS AND OTHER NOTES, SEE DWG. WC1.

SHOP DRAWING REVIEW

☒ REVIEWED AS REQUIRED BY THE CONSTRUCTION CONTRACT DOCUMENTS AND APPROVED, BUT ONLY FOR CONFORMANCE TO THE DESIGN CONCEPT OF THE WORK, AND SUBJECT TO FURTHER LIMITATIONS AND REQUIREMENTS CONTAINED IN THE CONSTRUCTION CONTRACT DOCUMENTS.

☐ REJECTED ☐ REVISE AND RESUBMIT ☐ FURNISH AS CORRECTED

CORRECTIONS OR COMMENTS MADE ON THE SHOP DRAWINGS DURING THIS REVIEW DO NOT RELIEVE CONTRACTOR FROM COMPLIANCE WITH REQUIREMENTS OF THE DRAWINGS AND SPECIFICATIONS. THIS CHECK IS ONLY FOR REVIEW OF GENERAL CONFORMANCE WITH THE DESIGN CONCEPT OF THE PROJECT AND GENERAL COMPLIANCE WITH THE INFORMATION GIVEN IN THE CONTRACT DOCUMENTS. THE CONTRACTOR IS RESPONSIBLE FOR CONFIRMING AND CORRELATING ALL QUANTITIES AND DIMENSIONS; SELECTING FABRICATION PROCESSES AND TECHNIQUES OF CONSTRUCTION; COORDINATING HIS WORK WITH THAT OF ALL OTHER TRADES; AND PERFORMING HIS WORK IN A SAFE AND SATISFACTORY MANNER.

VHB Vanasse Hangen Brustlin, Inc. Engineers, Planners, and Scientists Six Bedford Farms, Kitton Rd. Bedford, NH 03102 603 644 0888

Job Number: 56411
Reviewed By: SMITH
Date: 11/15/04

G5 THRU G8 = SHIPMENT 2
G9 THRU G12 = SHIPMENT 3

CODE: 30

NO.	REVISION	BY	DATE
1	INCREASE LENGTHS TO SATISFY REQUIREMENTS FOR LENGTH @ MEAN TEMPERATURE OF 45°F.	DP	9/17/04

HIGH STEEL STRUCTURES, INC.
1770 Hempstead Road
Lancaster, PA 17605-0008
Phone 717/299-5211
A Division of High Industries, Inc.

WEB CAMBER DIAGRAMS
VT 78 OVER MISSISQUOI BAY, BRIDGE NO. 2
VT 78 STA.10+970.425 TO STA.12+059.775
TOWNS OF ALBURG AND SWANTON
COUNTIES OF GRAND ISLE AND FRANKLIN
STATE OF VERMONT, AGENCY OF TRANSPORTATION

STATE CONTRACT OR REF. NO. BRF-036-1(1)
CONTRACTOR CIANBRO CORPORATION
IN CHARGE: GLIDDEN (IH) MADE BY: KMA CHK'D. BY: SJA DATE: 7/9/04
CONTRACT NUMBER: VT-04057-2&3 DRAWING NUMBER: WC4 OF WC5

METRIC

PLOTTED: 9/20/2004 10:33:42 PM
BY: dparker