METRIC

METRIC	1. ALL DIMENSIONS ARE IN MILLIMETERS UNLESS OTHERWISE NOTED. 2. ALL WEIGHTS ARE IN KILOGRAMS.	FED. ROAD DIV. NO.	STATE VT	FED. AID PROJ. NO.

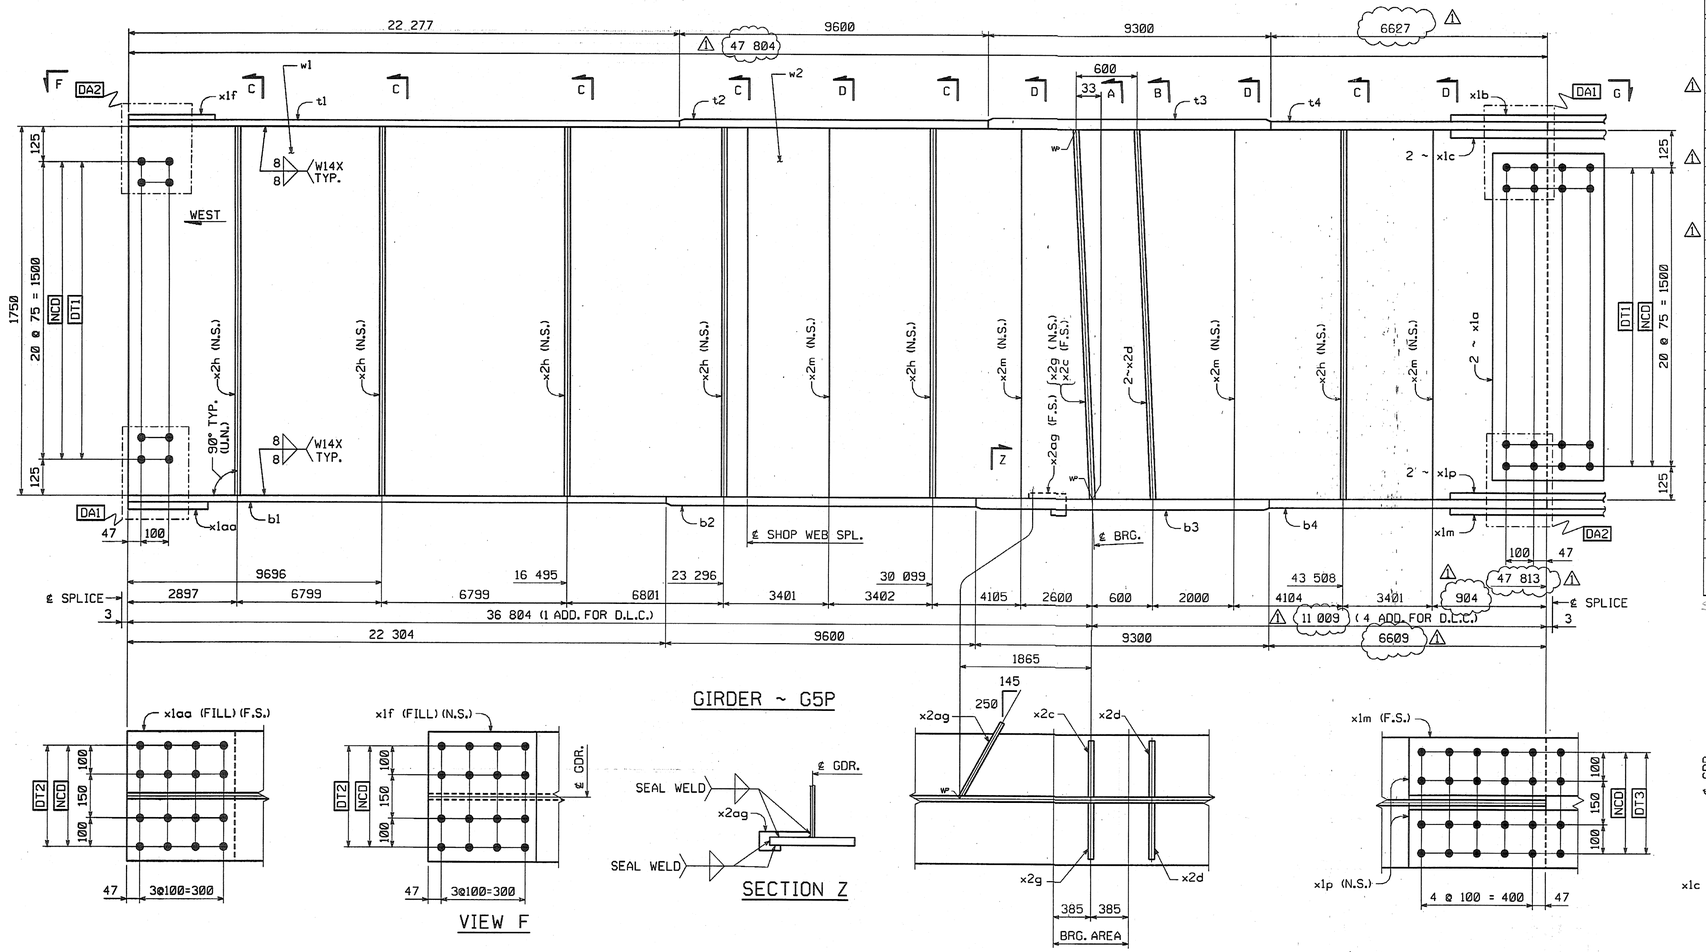

VIEW F

SECTION Z

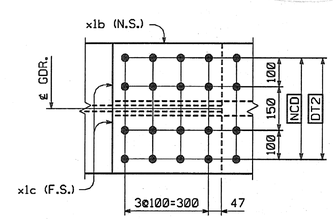

VIEW G

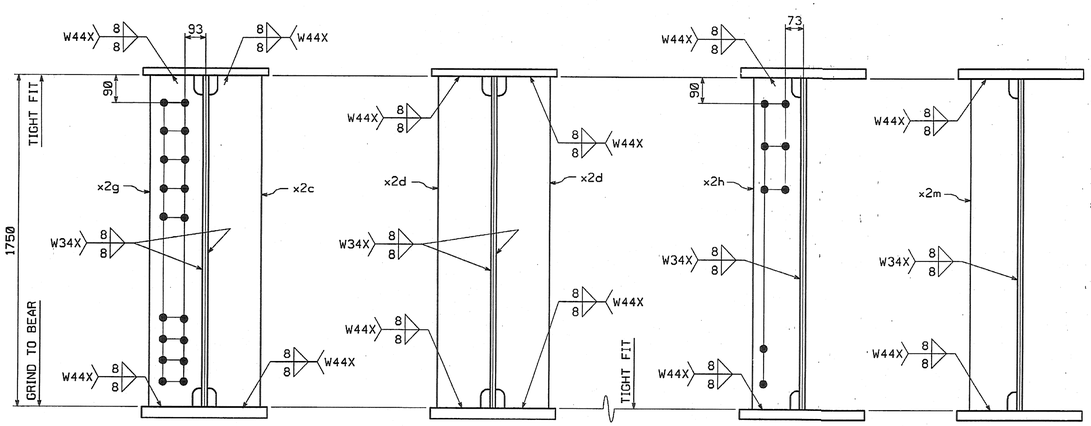

SECTION A

SECTION B

SECTION C

SECTION D

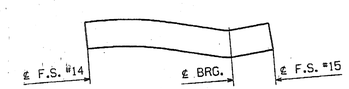

ORIENTATION DIAGRAM

SHOP NOTE

HOLES: 15/16" ø

BOLTS: NONE

PAINT: NONE

FOR GENERAL SHOP NOTES, SEE DWG. GN1.

FOR WEB CAMBER DIAGRAM, SEE DWG. WC4.

CODE:30

BILL OF MATERIAL

NO.	MARK	DESCRIPTION	LENGTH	REMARKS	GRP.	ITEM	SHIP. WT. KG. EA.
ONE	G5P	GIRDER					24 890
1	w1	PL 16 x 1750	~~23 812~~	(T)	3	6	5233.28
1	w2	PL 16 x 1750	~~24 010~~	(T) 47808	3	1	5276.79 10508.57
1	t1	PL 22 x 450	22 277	(T)	4	25	~~1731.06~~ 1731.26
1	t2	PL 40 x 450	9 600	(T)	4	8	~~1356.32~~ 1356.48
1	t3	PL 80 x 450	9 300	(T)	4	1	~~2627.88~~ 2628.18
1	t4	PL 40 x 450	~~6 628~~	(T) 6627	4	10	~~936.43~~ 936.40
1	b1	PL 22 x 450	22 304	(T)	4	23	~~1733.16~~ 1733.36
1	b2	PL 40 x 450	9 600	(T)	4	8	~~1356.32~~ 1356.48
1	b3	PL 80 x 450	9 300	(T)	4	1	~~2627.88~~ 2628.18
1	b4	PL 40 x 450	~~6 610~~	(T) 6609	4	11	~~933.89~~ 933.85
2	x1a	PL 12 x 1600	400	(T)	6	1	~~60.28~~ 120.58
1	x1b	PL 14 x 450	790	(T)	6	6	~~39.06~~ 39.07
2	x1c	PL 16 x 200	790	(T)	6	5	19.84 39.69
1	x1f	PL 10 x 450	392	FILL	6	7	13.85
1	x1m	PL 18 x 450	990	(T)	6	3	~~62.94~~ 62.95
2	x1p	PL 20 x 200	990	(T)	6	2	~~31.08~~ 62.17
1	x1aa	PL 10 x 450	392	FILL	6	7	13.85
1	x2c	PL 38 x 200	1 750		7	1	~~104.39~~ 104.41
2	x2d	PL 38 x 200	1 750		7	1	~~104.39~~ 208.81
1	x2g	PL 38 x 200	1 750		7	1	104.39 104.41
6	x2h	PL 12 x 180	1 750		7	4	~~29.67~~ 178.04
4	x2m	PL 12 x 180	1 750		7	4	29.67 118.69
1	x2ag	PL 6 x ~~130~~	301	* V61 = 8415mm	7	5	~~1.84~~ 0.66
		TOTAL WEIGHT THIS SHEET:		~~24 881.23~~	kgs		

SEE SHEET 5 OF 112

24879.68 kg HMR 8-7-06

24879.67 kg 08-21-06

24879 08-22-06

SHOP DRAWING REVIEW

X REVIEWED AS REQUIRED BY THE CONSTRUCTION CONTRACT DOCUMENTS AND APPROVED, BUT ONLY FOR CONFORMANCE TO THE DESIGN CONCEPT OF THE WORK, AND SUBJECT TO FURTHER LIMITATIONS AND REQUIREMENTS CONTAINED IN THE CONSTRUCTION CONTRACT DOCUMENTS.

☐ REJECTED ☐ REVISE AND RESUBMIT ☐ FURNISH AS CORRECTED

CORRECTIONS OR COMMENTS MADE ON THE SHOP DRAWINGS DURING THIS REVIEW DO NOT RELIEVE CONTRACTOR FROM COMPLIANCE WITH REQUIREMENTS OF THE DRAWINGS AND SPECIFICATIONS. THIS CHECK IS ONLY FOR REVIEW OF GENERAL CONFORMANCE WITH THE DESIGN CONCEPT OF THE PROJECT AND GENERAL COMPLIANCE WITH THE INFORMATION GIVEN IN THE CONTRACT DOCUMENTS. THE CONTRACTOR IS RESPONSIBLE FOR: CONFIRMING AND CORRELATING ALL QUANTITIES AND DIMENSIONS; SELECTING FABRICATION PROCESSES AND TECHNIQUES OF CONSTRUCTION; COORDINATING HIS WORK WITH THAT OF ALL OTHER TRADES; AND PERFORMING HIS WORK IN A SAFE AND SATISFACTORY MANNER.


Job Number: 5691.11
Reviewed By: [illegible]
Date: 11.01.04

NO.	REVISION	BY	DATE
1	INCREASE LENGTHS TO SATISFY REQUIREMENTS FOR LENGTH @ MEAN TEMPERATURE OF 45°F.	JSA	9/17/04

HIGH STEEL STRUCTURES, INC.
1770 Hempstead Road
Lancaster, PA 17605-0008
Phone 717/299-5211
A Division of High Industries, Inc.

GIRDER	G5P
VT 78 OVER MISSISQUOI BAY, BRIDGE NO. 2	
VT 78 STA.10+970.425 TO STA.12+059.775	
TOWNS OF ALBURG AND SWANTON	
COUNTIES OF GRAND ISLE AND FRANKLIN	
STATE OF VERMONT, AGENCY OF TRANSPORTATION	

STATE CONTRACT OR REF. NO. BRF-036-1(1)

CONTRACTOR CIANBRO CORPORATION

IN CHARGE: GLIDDEN (IH) MADE BY: ERS CHK'D. BY: CS DATE: 8-23-04

CONTRACT NUMBER: VT-04057-2 DRAWING NUMBER: 61 OF 112

PLOTTED: 9/20/2004 1:07:11 PM BY: dpainter