METRIC

1. ALL DIMENSIONS ARE IN MILLIMETERS UNLESS OTHERWISE NOTED.
2. ALL WEIGHTS ARE IN KILOGRAMS.

FED. ROAD DIV. NO.	STATE	FED. AID PROJ. NO.
	VT	

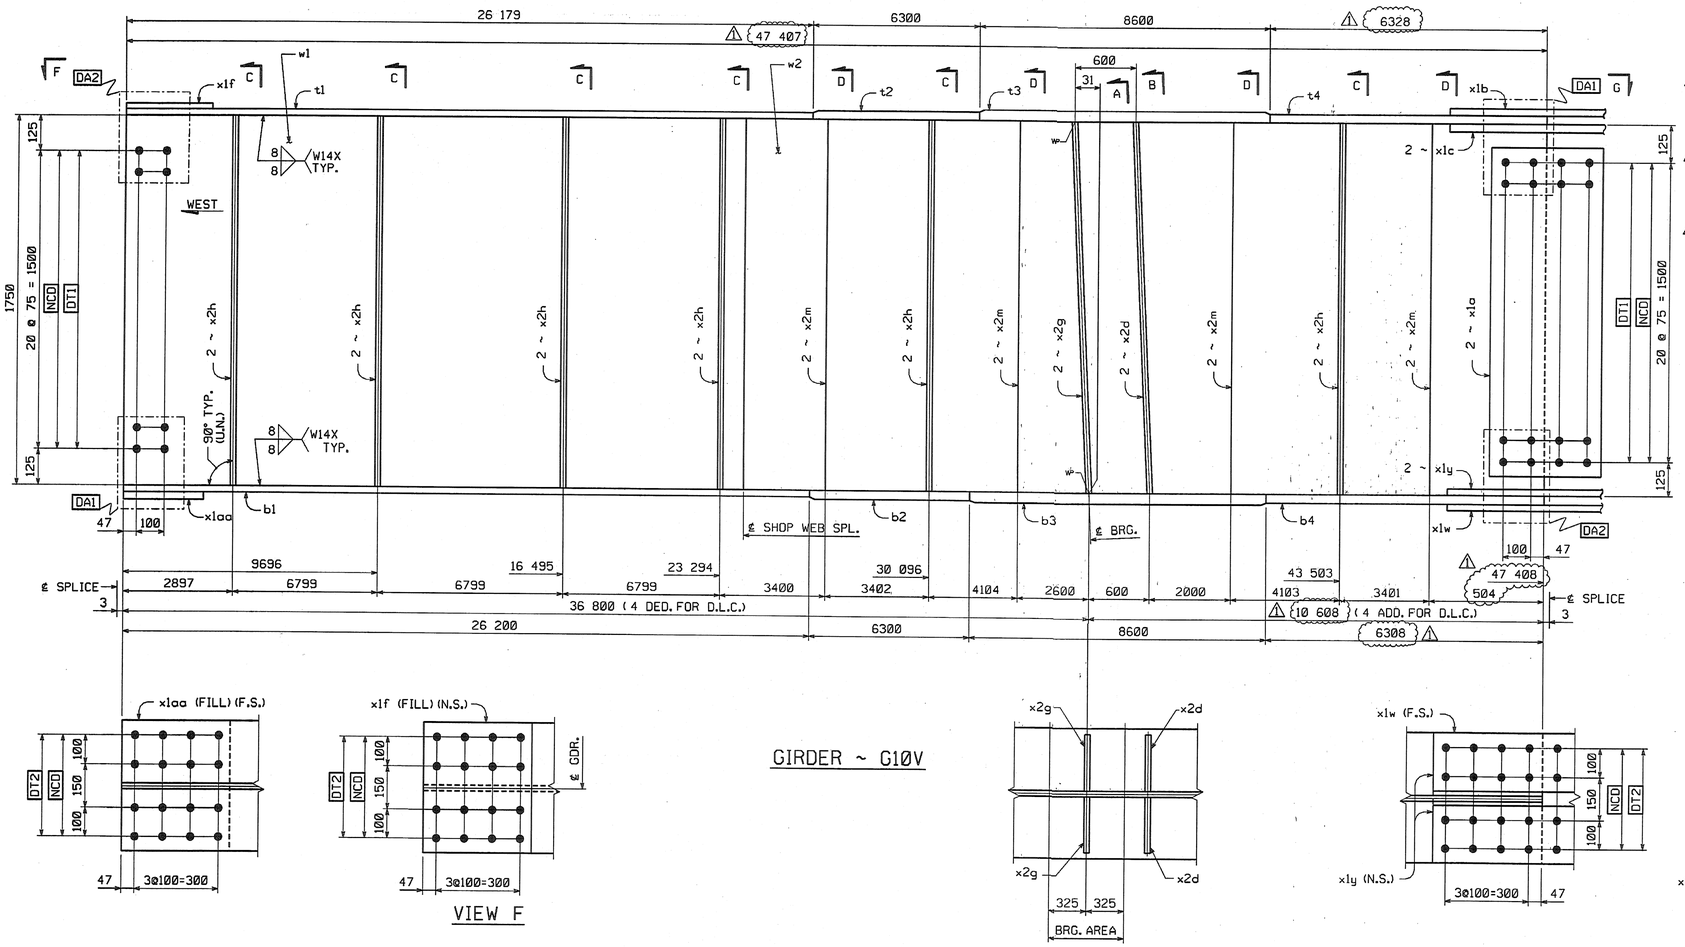

BILL OF MATERIAL

NO.	MARK	DESCRIPTION	LENGTH	REMARKS	GRP.	ITEM	SHIP. WT. KG. EA.
ONE	G10V	GIRDER					22 610
1	w1	PL 16 x 1750	23 811	(T)	3	6	5233.06
1	w2	PL 16 x 1750	23 608	(T) 47408	3	2	~~5188.44~~ 10420.17
1	t1	PL 22 x 450	26 179	(T)	4	21	2034.27 2034.50
1	t2	PL 32 x 450	6 300	(T)	4	15	712.07 712.15
1	t3	PL 65 x 450	8 600	(T)	4	3	1974.44 1974.67
1	t4	PL 32 x 450	6 329	(T) 6328	4	13	715.35 715.32
1	b1	PL 22 x 450	26 200	(T)	4	20	~~2035.90~~ 2036.13
1	b2	PL 32 x 450	6 300	(T)	4	15	712.07 712.15
1	b3	PL 65 x 450	8 600	(T)	4	3	1974.44 1974.67
1	b4	PL 32 x 450	6 309	(T) 6308	4	14	~~713.09~~ 713.06
2	x1a	PL 12 x 1600	400	(T)	6	1	~~60.28~~ 120.58
1	x1b	PL 14 x 450	790	(T)	6	6	~~39.06~~ 39.07
2	x1c	PL 16 x 200	790	(T)	6	5	~~19.84~~ 39.69
1	x1f	PL 10 x 450	392	FILL	6	7	13.85
1	x1w	PL 14 x 450	790	(T)	6	6	~~39.06~~ 39.07
2	x1y	PL 16 x 200	790	(T)	6	5	~~19.84~~ 39.69
1	x1aa	PL 10 x 450	392	FILL	6	7	13.85
2	x2d	PL 38 x 200	1 750		7	1	~~104.39~~ 209.81
2	x2g	PL 38 x 200	1 750		7	1	~~104.39~~ 209.81
12	x2h	PL 12 x 180	1 750		7	4	~~29.67~~ 356.08
8	x2m	PL 12 x 180	1 750		7	4	~~29.67~~ 237.38