METRIC

1. ALL DIMENSIONS ARE IN MILLIMETERS UNLESS OTHERWISE NOTED.
2. ALL WEIGHTS ARE IN KILOGRAMS.

| FED. ROAD DIV. NO. | STATE | FED. AID PROJ. NO. |
|---|---|---|
| | VT | |

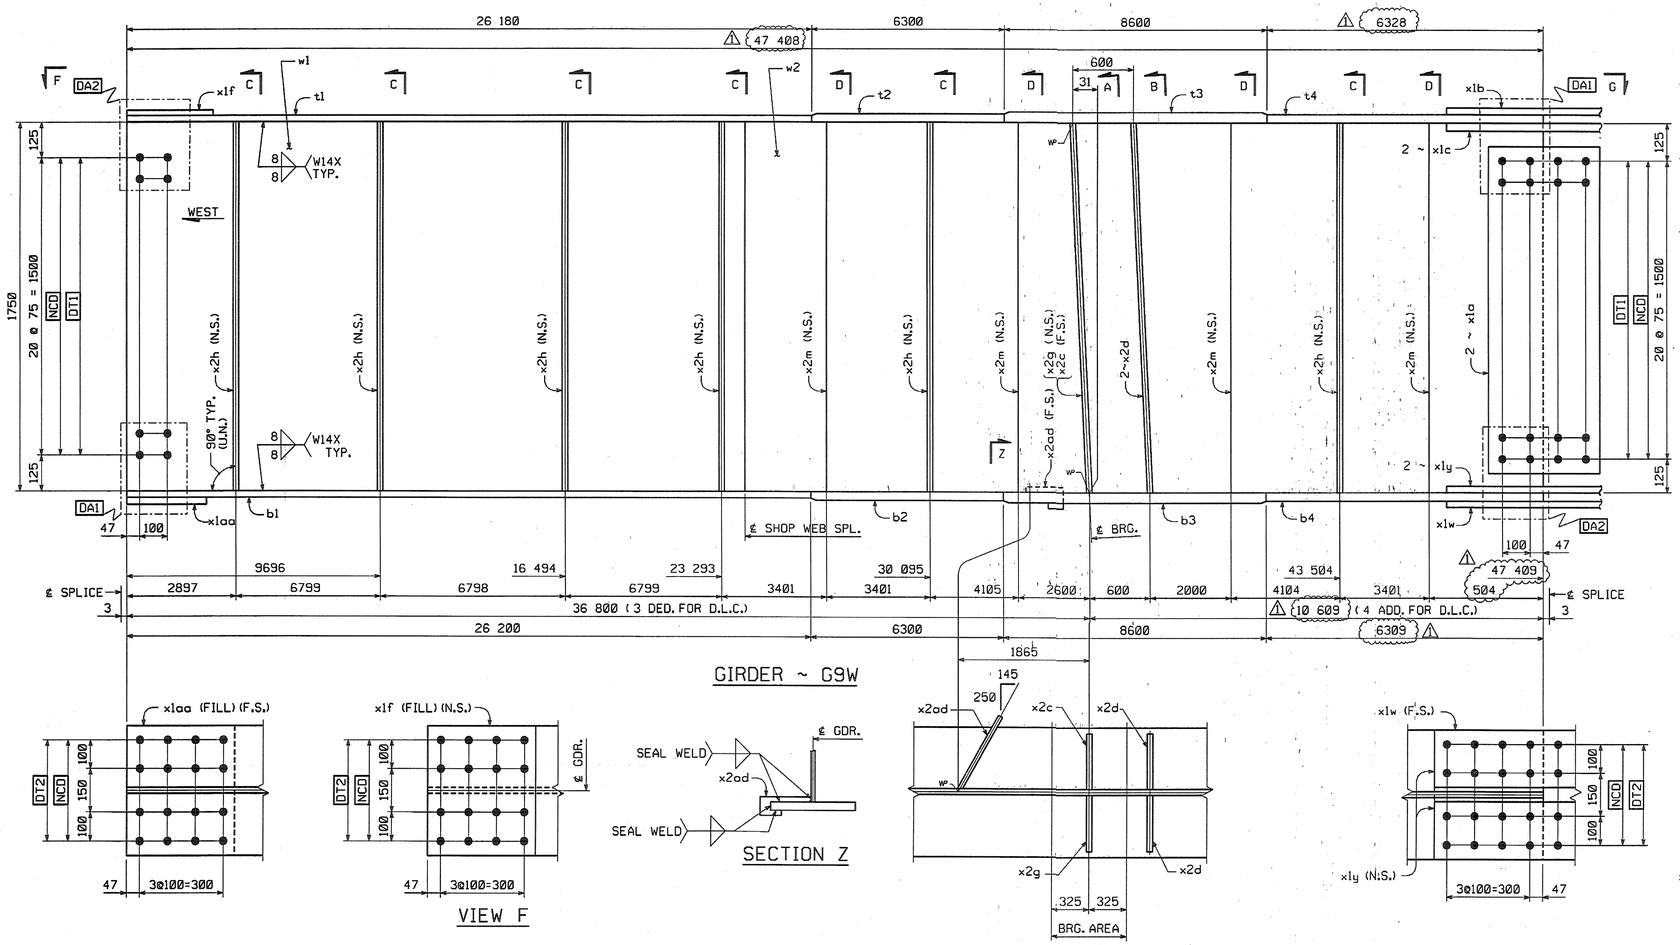


## BILL OF MATERIAL

| NO. | MARK | DESCRIPTION | LENGTH | REMARKS | GRP. | ITEM | SHIP. WT. KG. EA. | |
|---|---|---|---|---|---|---|---|---|
| ONE | G9W | GIRDER | | | | | 22 320 | |
| ~~1~~ | ~~w1~~ | ~~PL 16 x 1750~~ | ~~23 812~~ | ~~(T)~~ | ~~3~~ | ~~4~~ | ~~5233.28~~ | |
| 1 | w2 | PL 16 x 1750 | ~~23 608~~ | (T) 47408.5 | 3 | 2 | ~~5188.44~~ | 10420.39 |
| 1 | t1 | PL 22 x 450 | 26 180 | (T) | 4 | 21 | ~~2034.35~~ | 2034.58 |
| 1 | t2 | PL 32 x 450 | 6 300 | (T) | 4 | 15 | ~~712.07~~ | 712.15 |
| 1 | t3 | PL 65 x 450 | 8 600 | (T) | 4 | 3 | ~~1974.44~~ | 1974.67 |
| 1 | t4 | PL 32 x 450 | ~~6 329~~ | (T) 6328 | 4 | 13 | ~~715.35~~ | 715.32 |
| 1 | b1 | PL 22 x 450 | 26 200 | (T) | 4 | 20 | ~~2035.90~~ | 2036.13 |
| 1 | b2 | PL 32 x 450 | 6 300 | (T) | 4 | 15 | ~~712.07~~ | 712.15 |
| 1 | b3 | PL 65 x 450 | 8 600 | (T) | 4 | 3 | ~~1974.44~~ | 1974.67 |
| 1 | b4 | PL 32 x 450 | ~~6 310~~ | (T) 6309 | 4 | 14 | ~~713.20~~ | 713.12 |
| 2 | x1a | PL 12 x 1600 | 400 | (T) | 6 | 1 | ~~60.28~~ | 120.58 |
| 1 | x1b | PL 14 x 450 | 790 | (T) | 6 | 6 | ~~39.06~~ | 39.07 |
| 2 | x1c | PL 16 x 200 | 790 | (T) | 6 | 5 | ~~19.84~~ | 39.69 |
| 1 | x1f | PL 10 x 450 | 392 | FILL | 6 | 7 | ~~13.85~~ | |
| 1 | x1w | PL 14 x 450 | 790 | (T) | 6 | 6 | ~~39.06~~ | 39.07 |
| 2 | x1y | PL 16 x 200 | 790 | (T) | 6 | 5 | ~~19.84~~ | 39.69 |
| 1 | x1aa | PL 10 x 450 | 392 | FILL | 6 | 7 | ~~13.85~~ | |
| 1 | x2c | PL 38 x 200 | 1 750 | | 7 | 1 | ~~104.39~~ | 104.41 |
| 2 | x2d | PL 38 x 200 | 1 750 | | 7 | 1 | ~~104.39~~ | 208.81 |
| 1 | x2g | PL 38 x 200 | 1 750 | | 7 | 1 | ~~104.39~~ | 104.41 |
| 6 | x2h | PL 12 x 180 | 1 750 | | 7 | 4 | ~~29.67~~ | 178.04 |
| 4 | x2m | PL 12 x 180 | 1 750 | | 7 | 4 | ~~29.67~~ | 118.69 |
| 1 | x2ad | PL 6 x 115 | 301 | *V.I.= 7960 mm | 7 | 5 | ~~1.03~~ | 0.62, 0.63 |
| | | | | | | | | |
| | | | | | | | | |
| | | | | | | | |