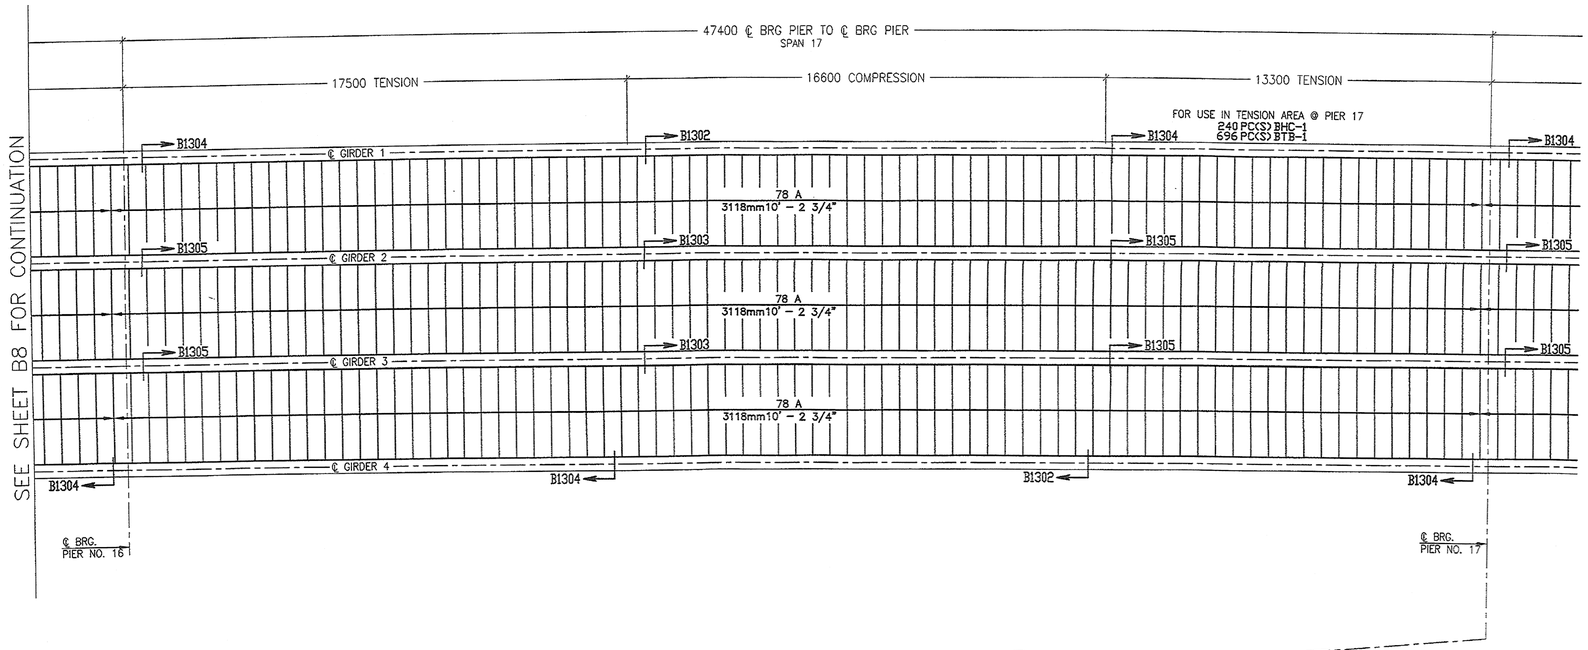

UNIT 3
BRIDGEFORM DECK PLAN
SPANS 17 & 18

114mm (4 1/2") X 305mm (12") PITCH 19 GA GALV G165 (MARK A)

SCALE: 1:100

CONSTRUCTION

SHOP DRAWING REVIEW

☐ REVIEWED AS REQUIRED BY THE CONSTRUCTION CONTRACT DOCUMENTS AND APPROVED, BUT ONLY FOR CONFORMANCE TO THE DESIGN CONCEPT OF THE WORK, AND SUBJECT TO FURTHER LIMITATIONS AND REQUIREMENTS CONTAINED IN THE CONSTRUCTION CONTRACT DOCUMENTS.

☐ REJECTED ☐ REVISE AND RESUBMIT ☑ FURNISH AS CORRECTED

CORRECTIONS OR COMMENTS MADE ON THE SHOP DRAWINGS DURING THIS REVIEW DO NOT RELIEVE CONTRACTOR FROM COMPLIANCE WITH REQUIREMENTS OF THE DRAWINGS AND SPECIFICATIONS. THIS CHECK IS ONLY FOR REVIEW OF GENERAL CONFORMANCE WITH THE DESIGN CONCEPT OF THE PROJECT AND GENERAL COMPLIANCE WITH THE INFORMATION GIVEN IN THE CONTRACT DOCUMENTS. THE CONTRACTOR IS RESPONSIBLE FOR: CONFIRMING AND CORRELATING ALL QUANTITIES AND DIMENSIONS; SELECTING FABRICATION PROCESSES AND TECHNIQUES OF CONSTRUCTION; COORDINATING HIS WORK WITH THAT OF ALL OTHER TRADES; AND PERFORMING HIS WORK IN A SAFE AND SATISFACTORY MANNER.

VHB Vanasse Hangen Brustlin, Inc. Engineers, Planners, and Scientists Six Bedford Farms, Kilton Rd. Bedford, NH 03110 603 644 0688

Job Number: 50911
Reviewed By: [illegible]
Date: 5-27-05

EACH SHEET MUST BE FASTENED TO SUPPORTS IMMEDIATELY UPON PLACEMENT TO AVOID HAZARD THAT COULD RESULT FROM HORIZONTAL MOVEMENT OR SUDDEN UPLIFT

Wheeling Corrugating Company
Since 1890
A DIVISION OF WHEELING PITTSBURGH STEEL CORPORATION
1134 MARKET ST., WHEELING, WEST VIRGINIA 26003
PHONE (304)-234-2348
FAX (304)-234-2343

CUSTOMER: CIANBRO
PROJECT: MISSISQUOI BAY BRIDGE
VT 78 (PRINCIPAL ARTERIAL)
OVER MISSISQUOI BAY, BRIDGE NO. 2
LOCATION: COUNTIES OF GRAND ISLE AND FRANKLIN
OWNER: STATE OF VERMONT AGENCY OF TRANSPORTATION

DRAWN	DATE	CHECKED	DATE	PROJECT #
GLH	3/21/05	LUCAS	3/28/05	BRF 036 - 1 (1)

REVISIONS

PRINTS ISSUED

No.	DATE	FOR
0/6	3/29	APPROVAL
E-0/6	4/21	APPROVAL
E	4/22	APPROVAL
E	5/13	APPROVAL

SYMBOLS

- SEQ. LINE
- AREA LINE
- # = SEQ. MARK
- # = AREA MARK
- E.O.D. = END OF DECK
- E.O.S. = END OF SLAB

NUMBER OF DECK SHEETS — DECKING MARK
1 A
0 – 0
SHEET LENGTH
DECK SYMBOL LEGEND

PROJECT # **BR-05-27**

B9

SHEET 9 OF 13