ITEM	DESCRIPTION	QUAN.
△ s24a	51mm X 157mm X 907mm BAR	48
△ s26	16GA. X 67mm X 165mm S.S. SHIM	96
s29	16GA. X 67mm X 403mm S.S. SHIM	96
s30	16mm X 64mm X 70mm FLAT BAR	48
s31	16mm X 64mm X 87mm FLAT BAR	48

NOTE: STAINLESS SHIMS NOT SHOWN IN RIGHT HAND VIEW FOR CLARITY PURPOSES.

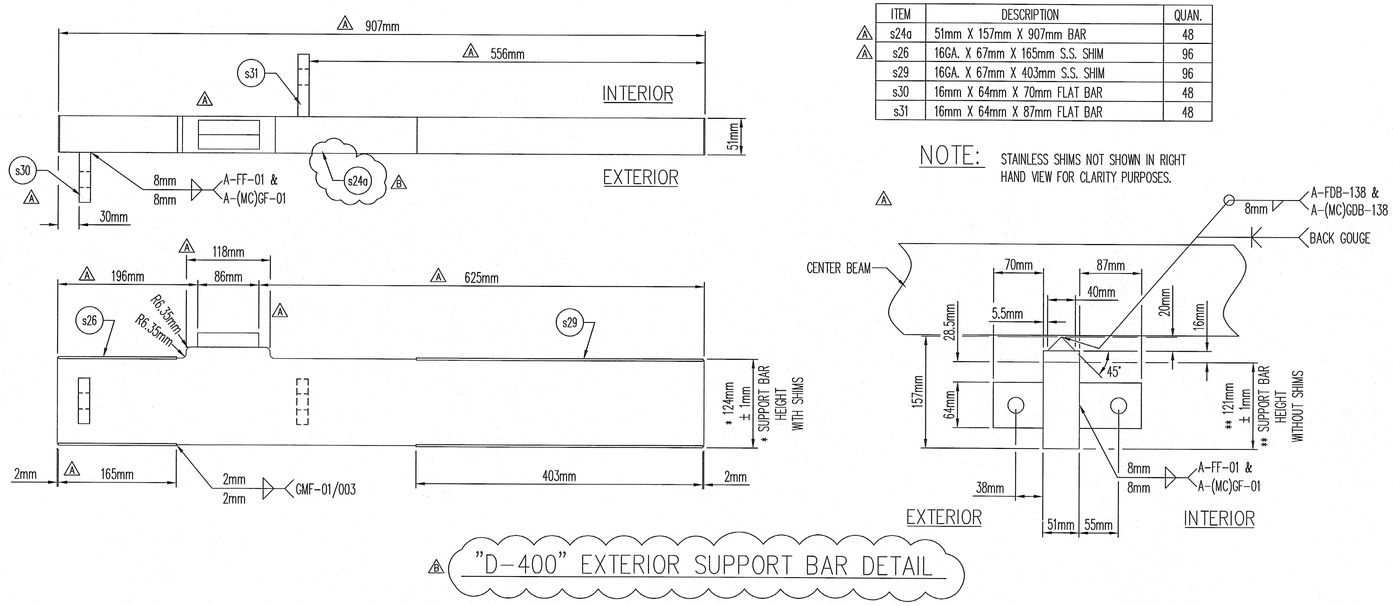

△B "D-400" EXTERIOR SUPPORT BAR DETAIL

ITEM	DESCRIPTION	QUAN.
△ s25a	51mm X 157mm X 907mm BAR	48
△ s27	16GA. X 67mm X 244mm S.S. SHIM	96
s28	16GA. X 67mm X 324mm S.S. SHIM	96
s31	16mm X 64mm X 87mm FLAT BAR	96
△		

NOTE: STAINLESS SHIMS NOT SHOWN IN RIGHT HAND VIEW FOR CLARITY PURPOSES.

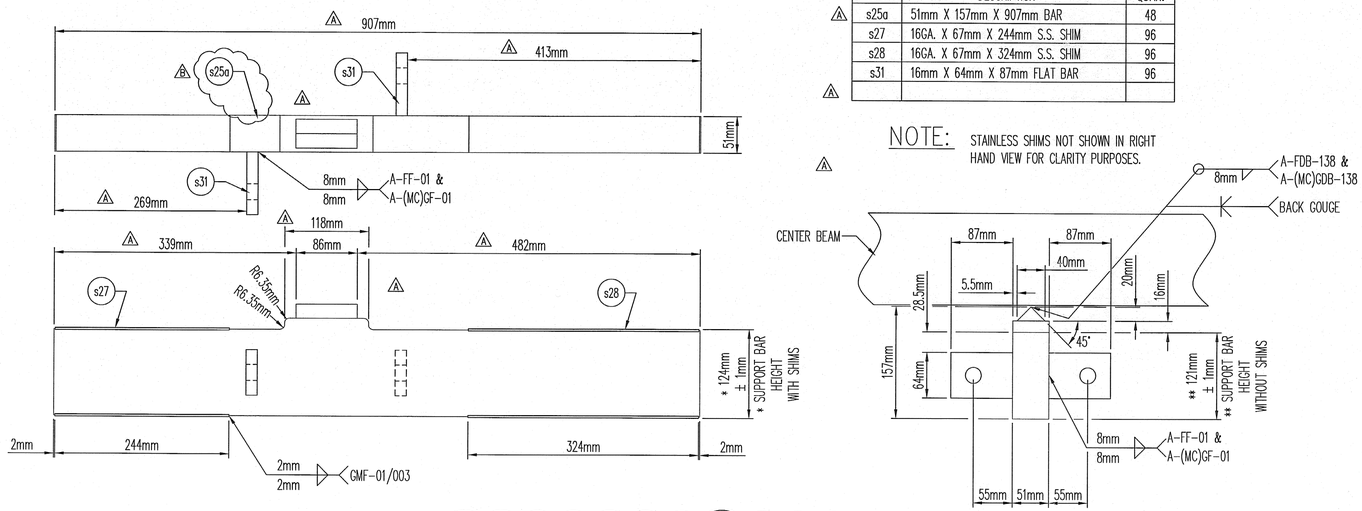

△B "D-400" INTERIOR SUPPORT BAR DETAIL

SHOP DRAWING REVIEW

☐ REVIEWED AS REQUIRED BY THE CONSTRUCTION CONTRACT DOCUMENTS AND APPROVED, BUT ONLY FOR CONFORMANCE TO THE DESIGN CONCEPT OF THE WORK, AND SUBJECT TO FURTHER LIMITATIONS AND REQUIREMENTS CONTAINED IN THE CONSTRUCTION CONTRACT DOCUMENTS.

☐ REJECTED ☐ REVISE AND RESUBMIT ☒ FURNISH AS CORRECTED

CORRECTIONS OR COMMENTS MADE ON THE SHOP DRAWINGS DURING THIS REVIEW DO NOT RELIEVE CONTRACTOR FROM COMPLIANCE WITH REQUIREMENTS OF THE DRAWINGS AND SPECIFICATIONS. THIS CHECK IS ONLY FOR REVIEW OF GENERAL CONFORMANCE WITH THE DESIGN CONCEPT OF THE PROJECT AND GENERAL COMPLIANCE WITH THE INFORMATION GIVEN IN THE CONTRACT DOCUMENTS. THE CONTRACTOR IS RESPONSIBLE FOR: CONFIRMING AND CORRELATING ALL QUANTITIES AND DIMENSIONS; SELECTING FABRICATION PROCESSES AND TECHNIQUES OF CONSTRUCTION; COORDINATING HIS WORK WITH THAT OF ALL OTHER TRADES; AND PERFORMING HIS WORK IN A SAFE AND SATISFACTORY MANNER.

VHB Vanasse Hangen Brustlin, Inc. Engineers, Planners, and Scientists Six Bedford Farms, Kitton Rd. Bedford, NH 03110 603 644 0888

Job Number: 50911
Reviewed By: SAH
Date: 6/1/06

REV.	DESCRIPTION	DATE	DET.	CKD.
△B	MODIFIED ITEMS IN SUPPORT BAR DETAIL & TITLE BLOCK	04/02/06	RES	JLW
△A	MODIFIED OPTIONAL SUPPORT BAR DETAILS	10/25/05	RES	JLW

D.S. BROWN
300 E. CHERRY STREET
NORTH BALTIMORE, OHIO 45872
419.257.3561
FAX: 419.257.0332

4201 NOREX DRIVE
CHASKA, MINNESOTA 55318
952.368.3000
FAX: 952.448.7000

DSBROWN.COM

	ITEM	QUANTITY
LOCATION — VT 78 OVER MISSISQUOI BAY	–	–
BRIDGE — 2	–	–
PROJECT NO. — BRF 036-1 (1)	–	–
△B TOWN — ALBURG AND SWANTON	–	–
P.O. NO. — P078559 MIS	–	–
△B SUPERVISOR — MARK KACZINSKI	–	–
CUSTOMER — CIANBRO CORPORATION	–	–
	–	–

DESCRIPTION: "D-400" SUPPORT BAR DETAILS
COUNTIES OF GRAND ISLE AND FRANKLIN, VERMONT

SCALE:	DRAWN BY:	CHECKED BY:	DATE:	BRIDGE SHEET:
N.T.S.	RES	JLW	03-22-05	13 OF 15

PROJECT NUMBER	PRODUCT CODE	RELEASE	SHEET
12244	1021	1	13