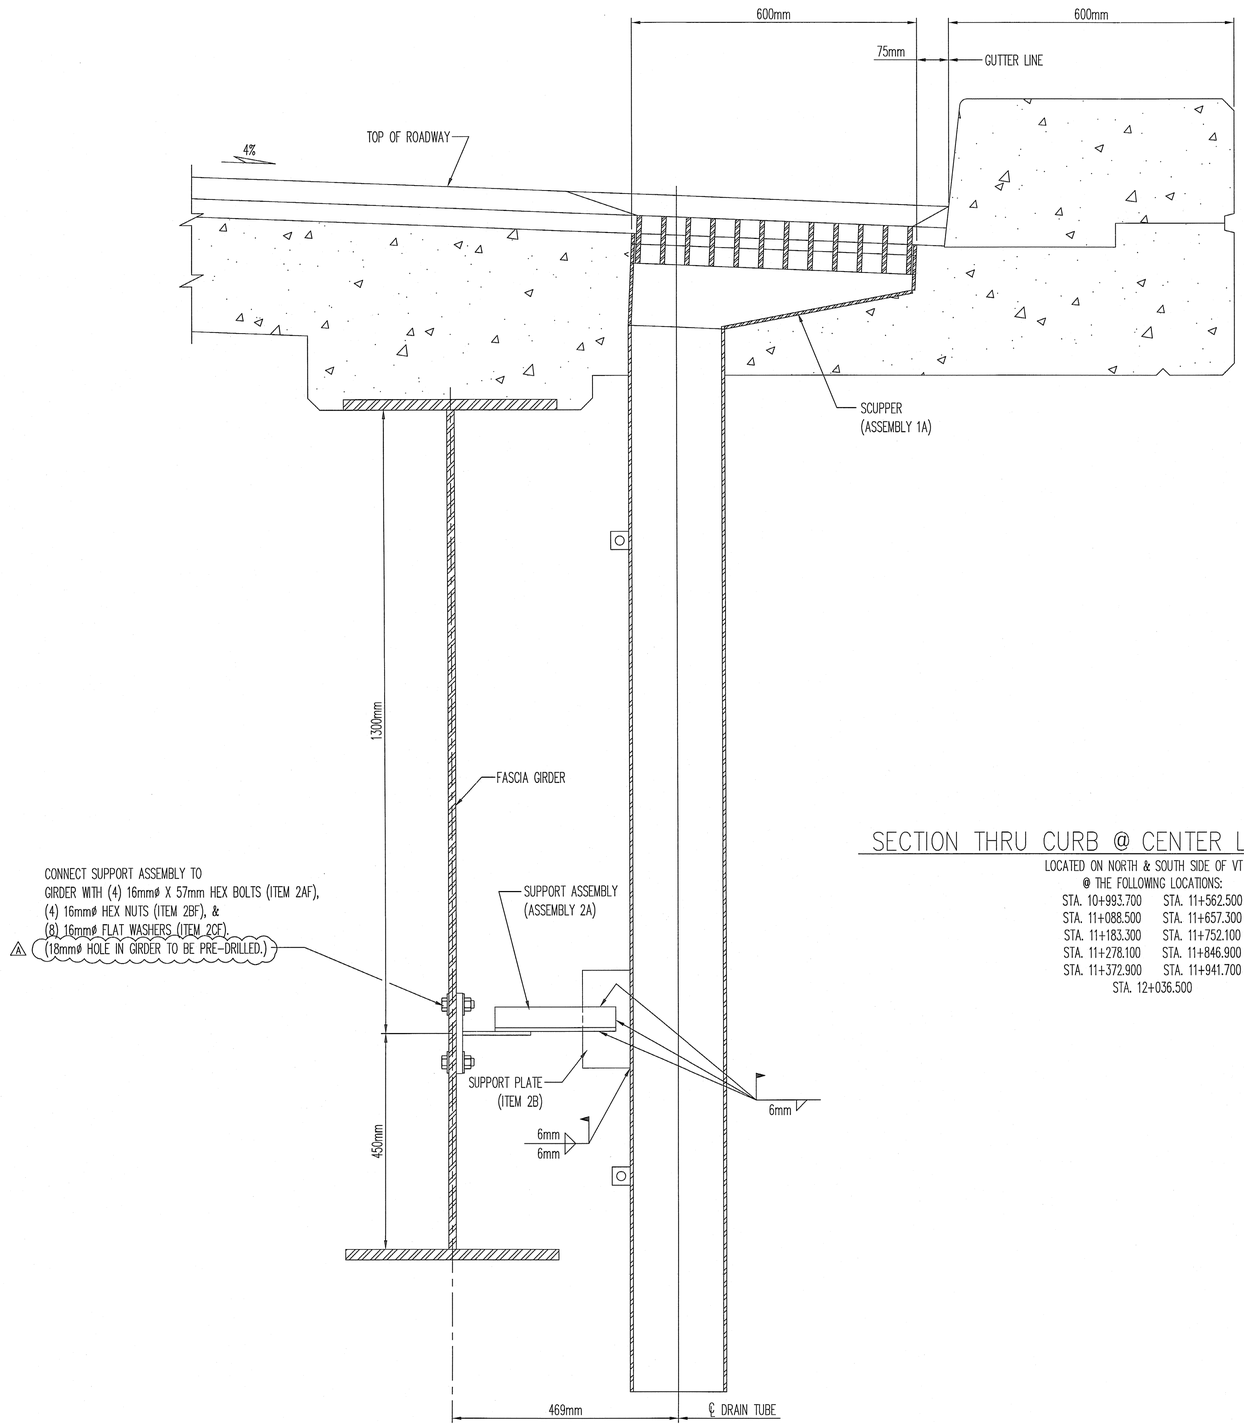

SECTION THRU CURB @ CENTER LINE OF SCUPPER

LOCATED ON NORTH & SOUTH SIDE OF VT 78
@ THE FOLLOWING LOCATIONS:

STA. 10+993.700	STA. 11+562.500
STA. 11+088.500	STA. 11+657.300
STA. 11+183.300	STA. 11+752.100
STA. 11+278.100	STA. 11+846.900
STA. 11+372.900	STA. 11+941.700
STA. 12+036.500	

SHOP DRAWING REVIEW

☑ REVIEWED AS REQUIRED BY THE CONSTRUCTION CONTRACT DOCUMENTS AND APPROVED, BUT ONLY FOR CONFORMANCE TO THE DESIGN CONCEPT OF THE WORK, AND SUBJECT TO FURTHER LIMITATIONS AND REQUIREMENTS CONTAINED IN THE CONSTRUCTION CONTRACT DOCUMENTS.

☐ REJECTED ☐ REVISE AND RESUBMIT ☐ FURNISH AS CORRECTED

CORRECTIONS OR COMMENTS MADE ON THE SHOP DRAWINGS DURING THIS REVIEW DO NOT RELIEVE CONTRACTOR FROM COMPLIANCE WITH REQUIREMENTS OF THE DRAWINGS AND SPECIFICATIONS. THIS CHECK IS ONLY FOR REVIEW OF GENERAL CONFORMANCE WITH THE DESIGN CONCEPT OF THE PROJECT AND GENERAL COMPLIANCE WITH THE INFORMATION GIVEN IN THE CONTRACT DOCUMENTS. THE CONTRACTOR IS RESPONSIBLE FOR: CONFIRMING AND CORRELATING ALL QUANTITIES AND DIMENSIONS; SELECTING FABRICATION PROCESSES AND TECHNIQUES OF CONSTRUCTION; COORDINATING HIS WORK WITH THAT OF ALL OTHER TRADES; AND PERFORMING HIS WORK IN A SAFE AND SATISFACTORY MANNER.

VHB Vanasse Hangen Brustlin, Inc. Engineers, Planners, and Scientists Six Bedford Farms, Kitton Rd. Bedford, NH 03110 603 644 0688

Job Number: 50911
Reviewed By: RRT-M
Date: 7-7-05

REV.	DESCRIPTION	DATE	DET.	CKD.
A	MODIFIED DESCRIPTION FOR HOLES IN GIRDER	06/21/05	RES	JEB

D.S. BROWN
300 E. CHERRY STREET
NORTH BALTIMORE, OHIO 45872
419.257.3561
FAX: 419.257.0332

4201 NOREX DRIVE
CHASKA, MINNESOTA 55318
952.368.3000
FAX: 952.448.7000

DSBROWN.COM

	ITEM	QUANTITY
LOCATION — VT 78 OVER MISSISQUOI BAY	–	–
BRIDGE — 2	–	–
PROJECT NO. — BRF 036-1 (1)	–	–
CITY — ALBURG AND SWANTON	–	–
P.O. NO. — P078559 MIS	–	–
DESIGNER — VANASSE HANGEN BRUSTLIN, INC.	–	–
CUSTOMER — CIANBRO CORPORATION	–	–
	–	–

DESCRIPTION: SCUPPER DETAILS
COUNTIES OF GRAND ISLE AND FRANKLIN, VERMONT

SCALE:	DRAWN BY:	CHECKED BY:	DATE:
N.T.S.	RES	JEB	03-24-05

PROJECT NUMBER	PRODUCT CODE	RELEASE	SHEET
12244	1235	1	E1