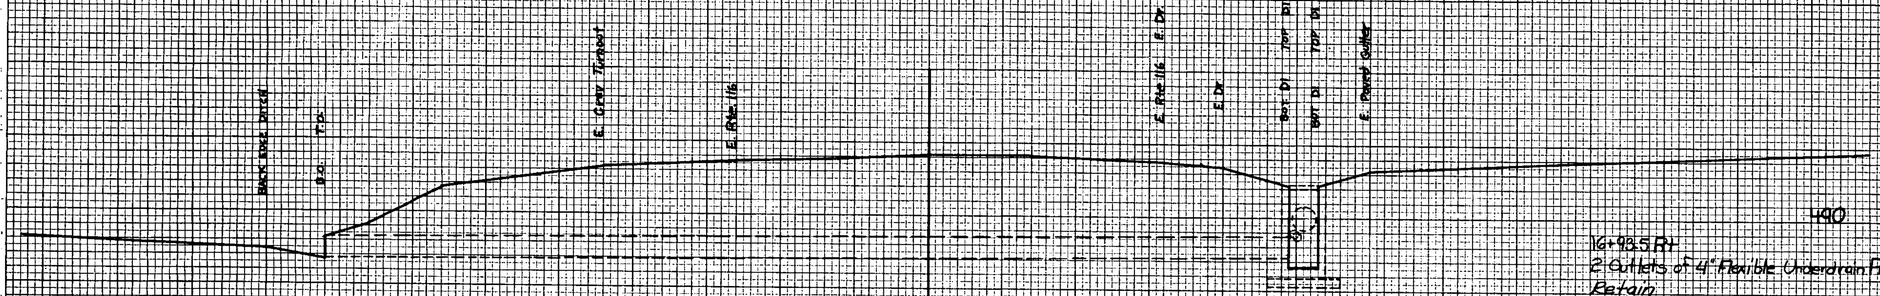

16+93.5 Rt
2 Outlets of 4" Flexible Underdrain Pipe
Retain

16+59 Rt
Sewer Manhole, Retain

16+56 Rt - 16+93.5 Rt
Existing 18" ACCGMP Retain

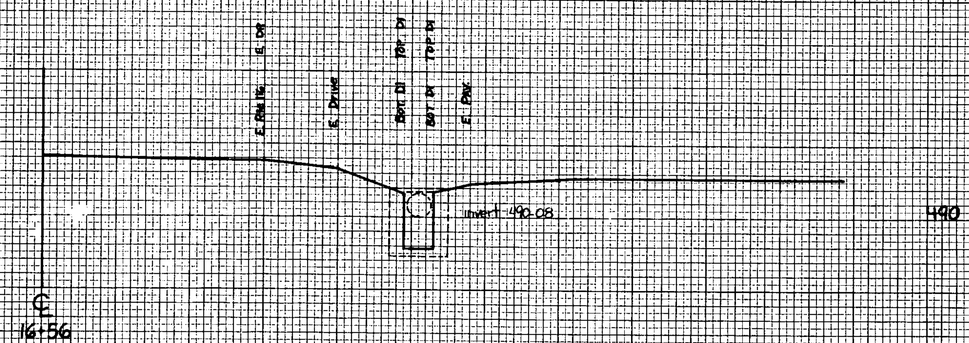

scale in feet
0 5 10

From Sta 16+56 to Sta 16+93.5
Project Name: Fairfax Mainline
No. F-021-1(635) Plotted 7-6-83
Surveyed by Fall June 83
Sheet 60 of 76 Sheets