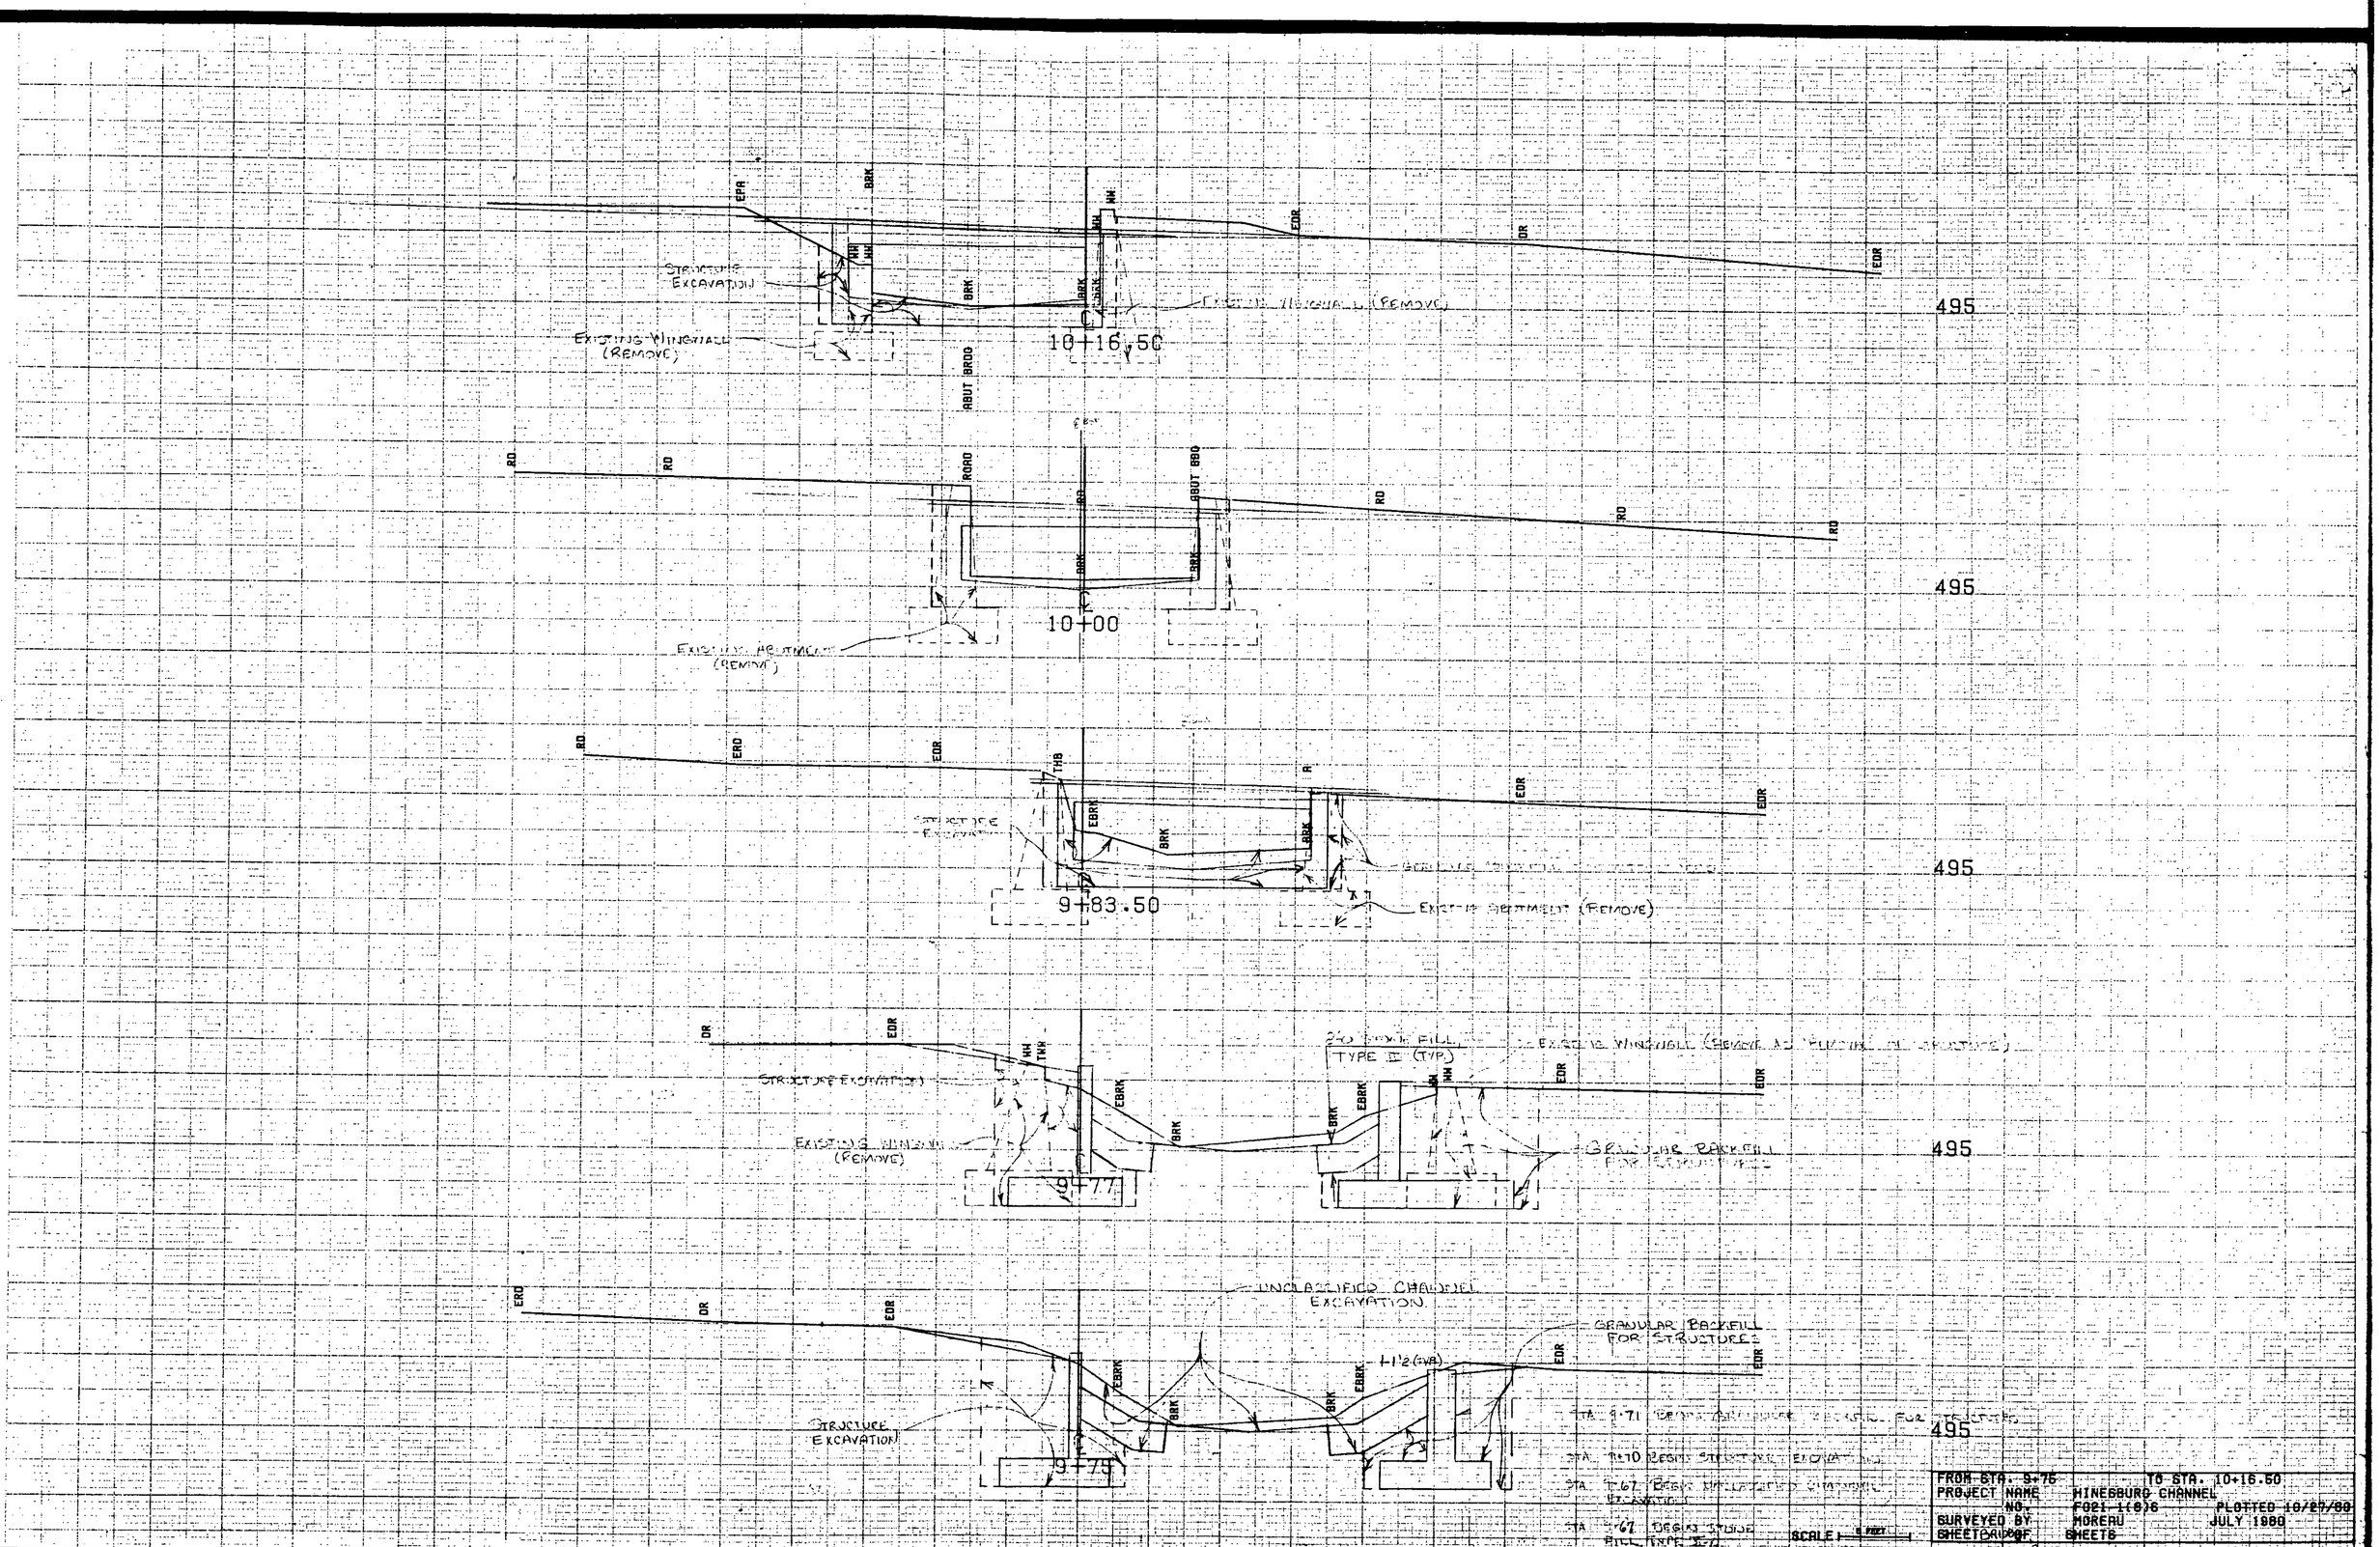
EPR
BRK
STRUCTURE EXCAVATION
EXISTING WINGWALL (REMOVE)
10+16.50
ABUT BRDG
RD
ROAD
ABUT BRDG
10+00
EXISTING WINGWALL (REMOVE)
EDR
DR
495
495
THB
EBRK
STRUCTURE EXCAVATION
9+83.50
EXISTING SEDIMENT (REMOVE)
495
HH
THH
STRUCTURE EXCAVATION
EXISTING WINGWALL (REMOVE)
9+77
2'-0" FILL TYPE II (TYP)
GRANULAR BACKFILL FOR STRUCTURE
495
UNCLASSIFIED CHANNEL EXCAVATION
GRANULAR BACKFILL FOR STRUCTURE
1:1 1/2 (TYP)
STRUCTURE EXCAVATION
9+79
495
FROM STA. 9+75 TO STA. 10+16.50
PROJECT NAME HINESBURG CHANNEL
NO. F021-1(8)6 PLOTTED 10/27/80
SURVEYED BY MOREAU JULY 1980
SHEET 8 OF SHEETS
SCALE 5 FEET