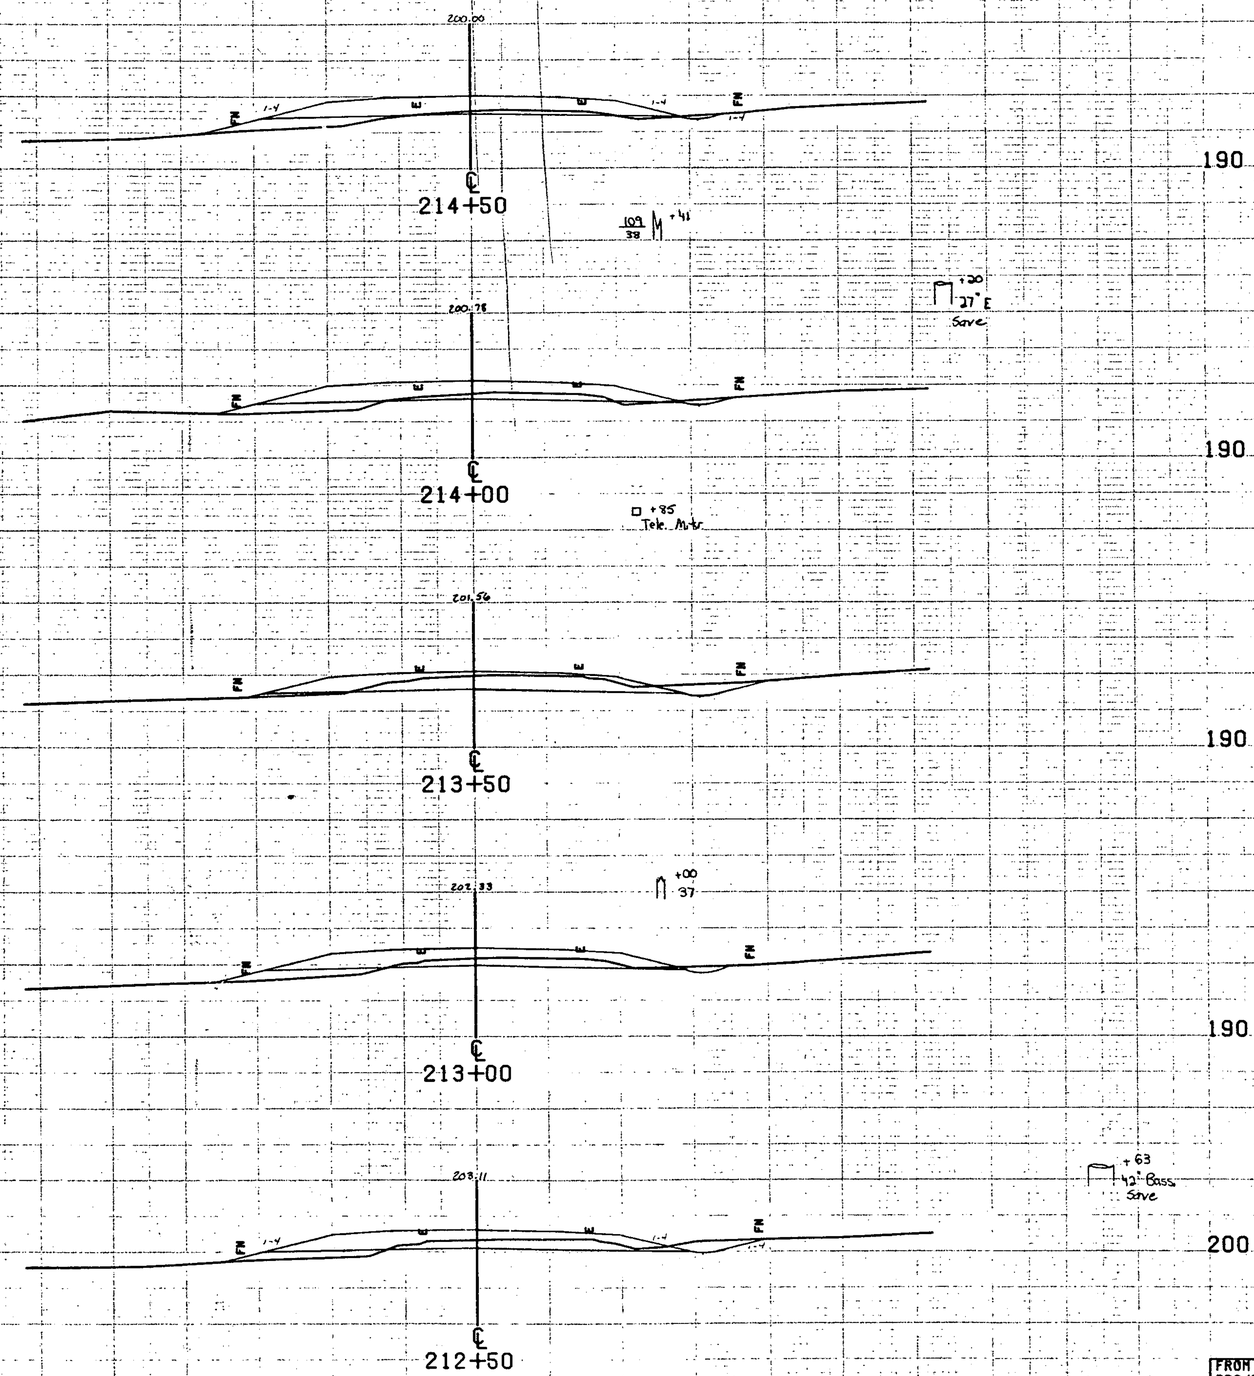

FROM STA. 212+50		TO STA. 214+50
PROJECT NAME	FERRISBURG M/L	
NO.	F EGC F 019-4 (11)	PLOTTED 05/27/80
SURVEYED BY	CARLSON	APRIL 1980
SHEET 30 OF 62 SHEETS		

SCALE 10 FEET