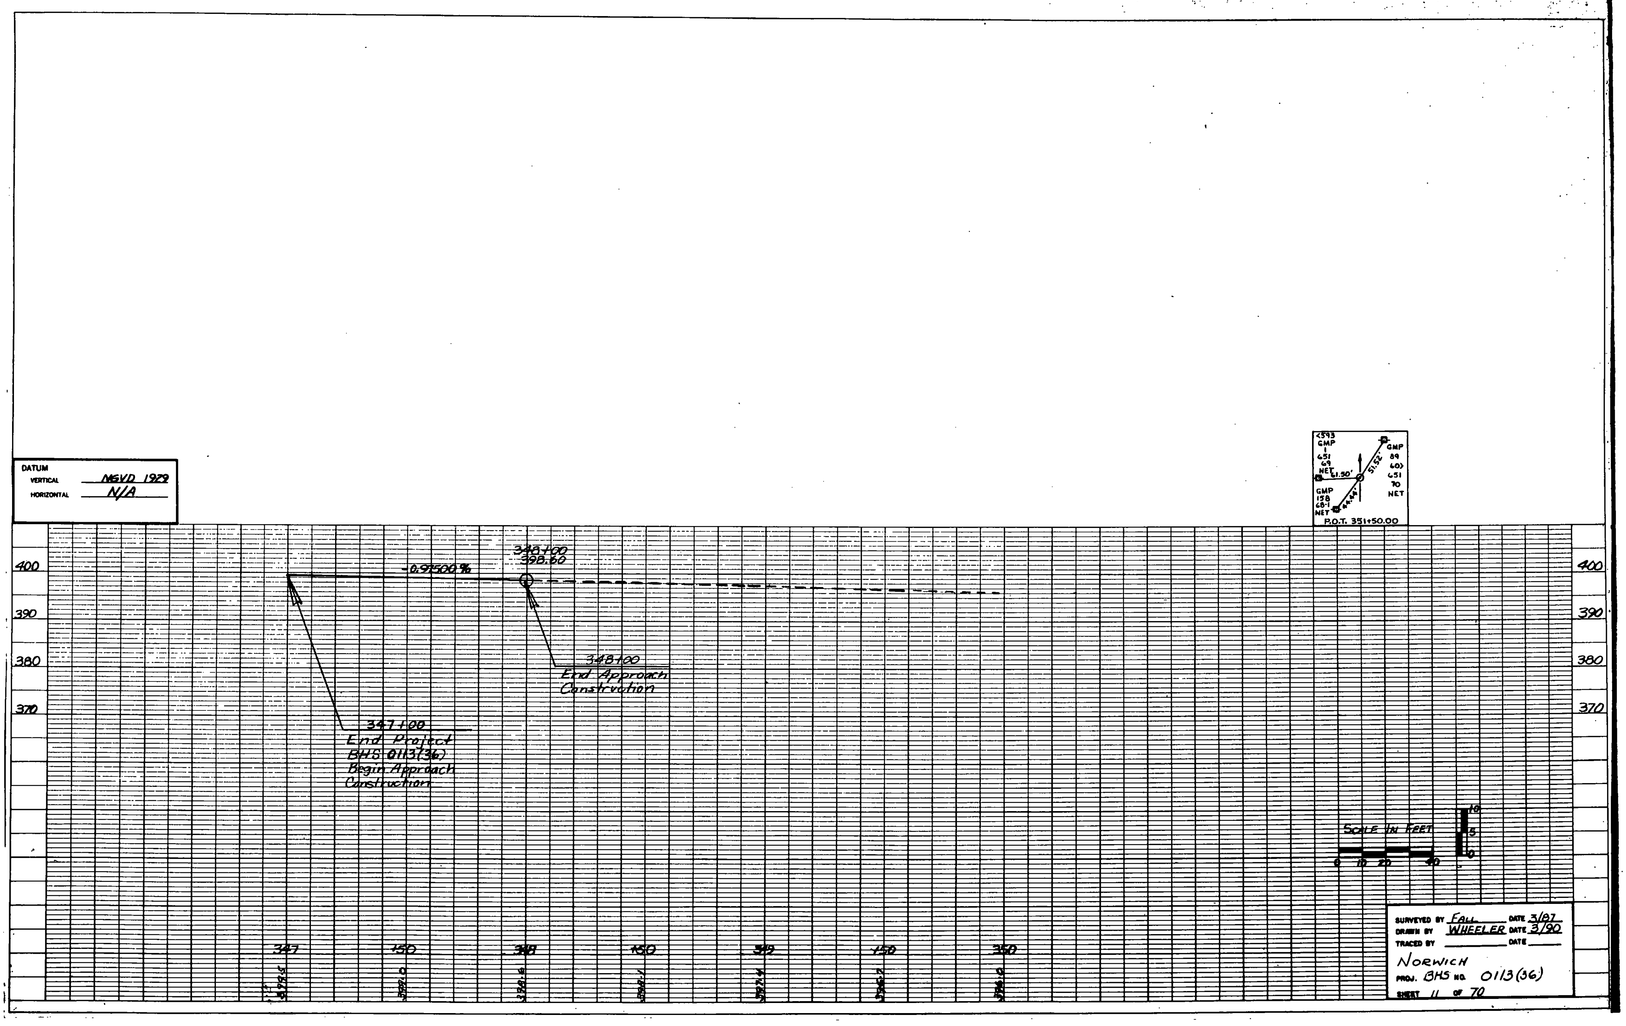
DATUM
VERTICAL NGVD 1929
HORIZONTAL N/A
P.O.T. 351+50.00
-0.97500%
348+00
358.60
348+00
End Approach
Construction
347+00
End Project
BHS 0113(36)
Begin Approach
Construction
400
390
380
370
347
350
348
350
349
350
350
SCALE IN FEET
0 10 20 30
SURVEYED BY FALL DATE 3/87
DRAWN BY WHEELER DATE 3/90
TRACED BY DATE
NORWICH
PROJ. BHS NO. 0113(36)
SHEET 11 OF 70