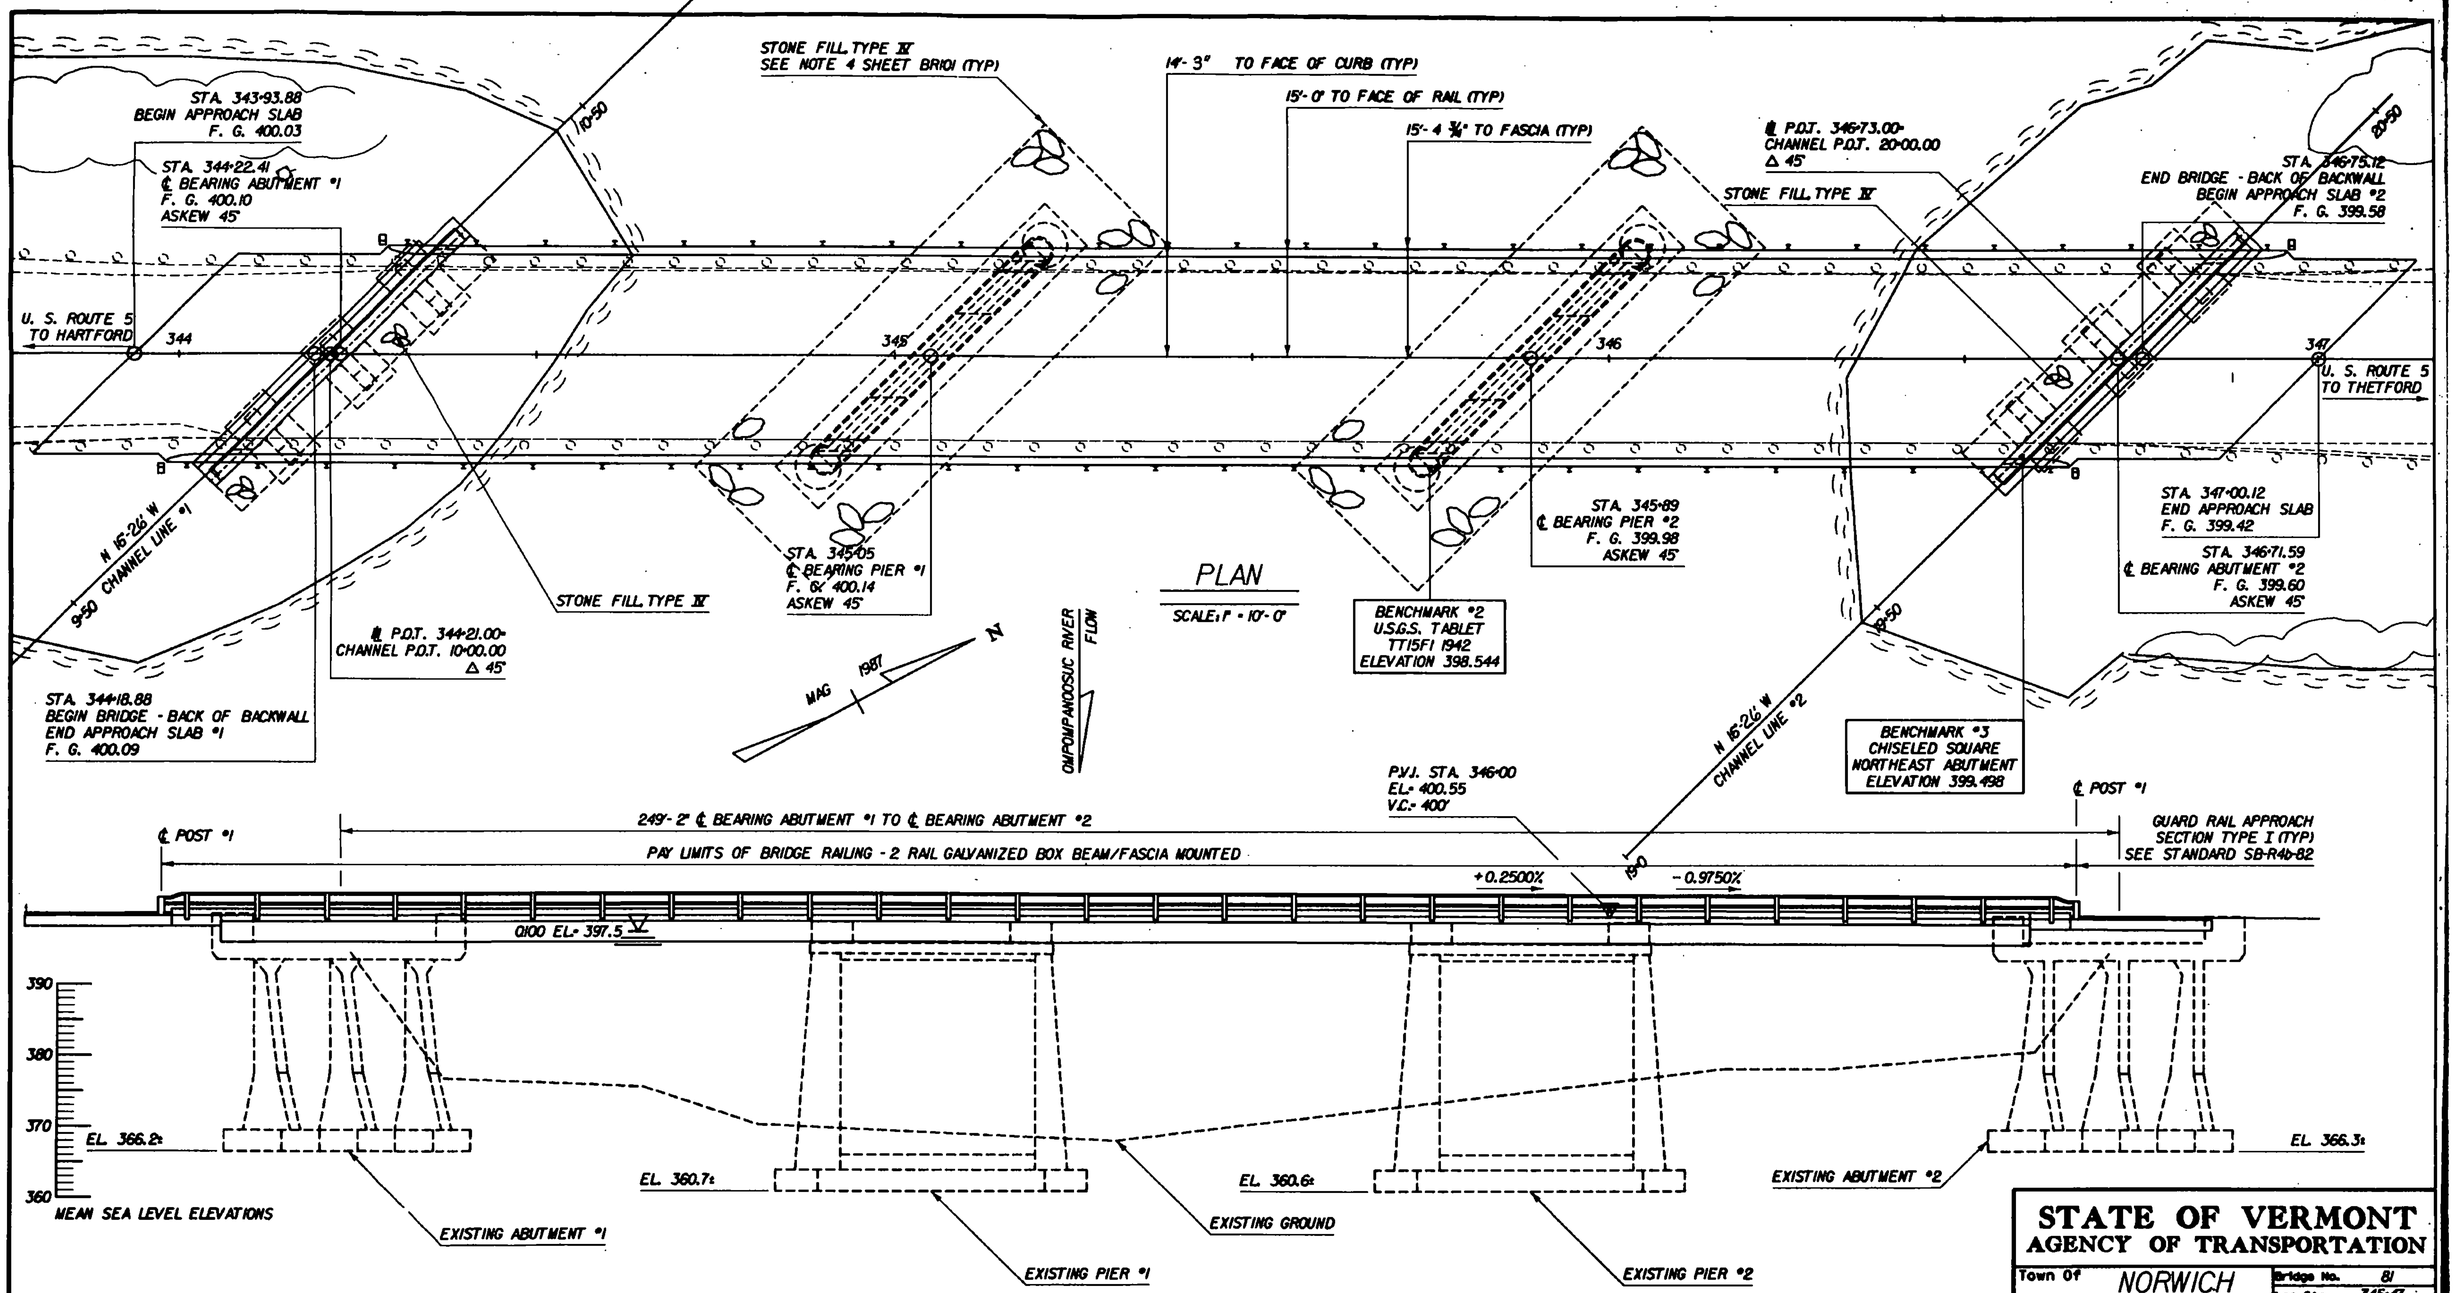

NOTE: ALL EXISTING SUBSTRUCTURES SUPPORTED ON TIMBER PILES

STATE OF VERMONT
AGENCY OF TRANSPORTATION

Town Of	NORWICH	Bridge No.	81
		Log Sta.	345+47
Highway No.	U. S. ROUTE 5	Surv. Sta.	345+47
PLAN AND ELEVATION			
U. S. ROUTE 5 OVER THE OMPOMPANOOSUC RIVER			
Designed By	D. J. HOYNE	Drawn By	K. S. CLAIRMONT
Checked By	D. J. HOYNE Date 2/92	Bridge Design Supervisor	F. W. Bolkom Date 4/92
PROJECT	NORWICH	PROJECT NO.	BHS 0113(36)
I.D.C. Info.	ZHI: [30,47] TTB069.DGN;1		
Bridge Sheet No.	BR103	Sheet 19 of 70	