WEST RUTLAND - RUTLAND
FEGC F020-1(10) S/Z
TOPSOIL 979+50 Rt - 981+50 Rt

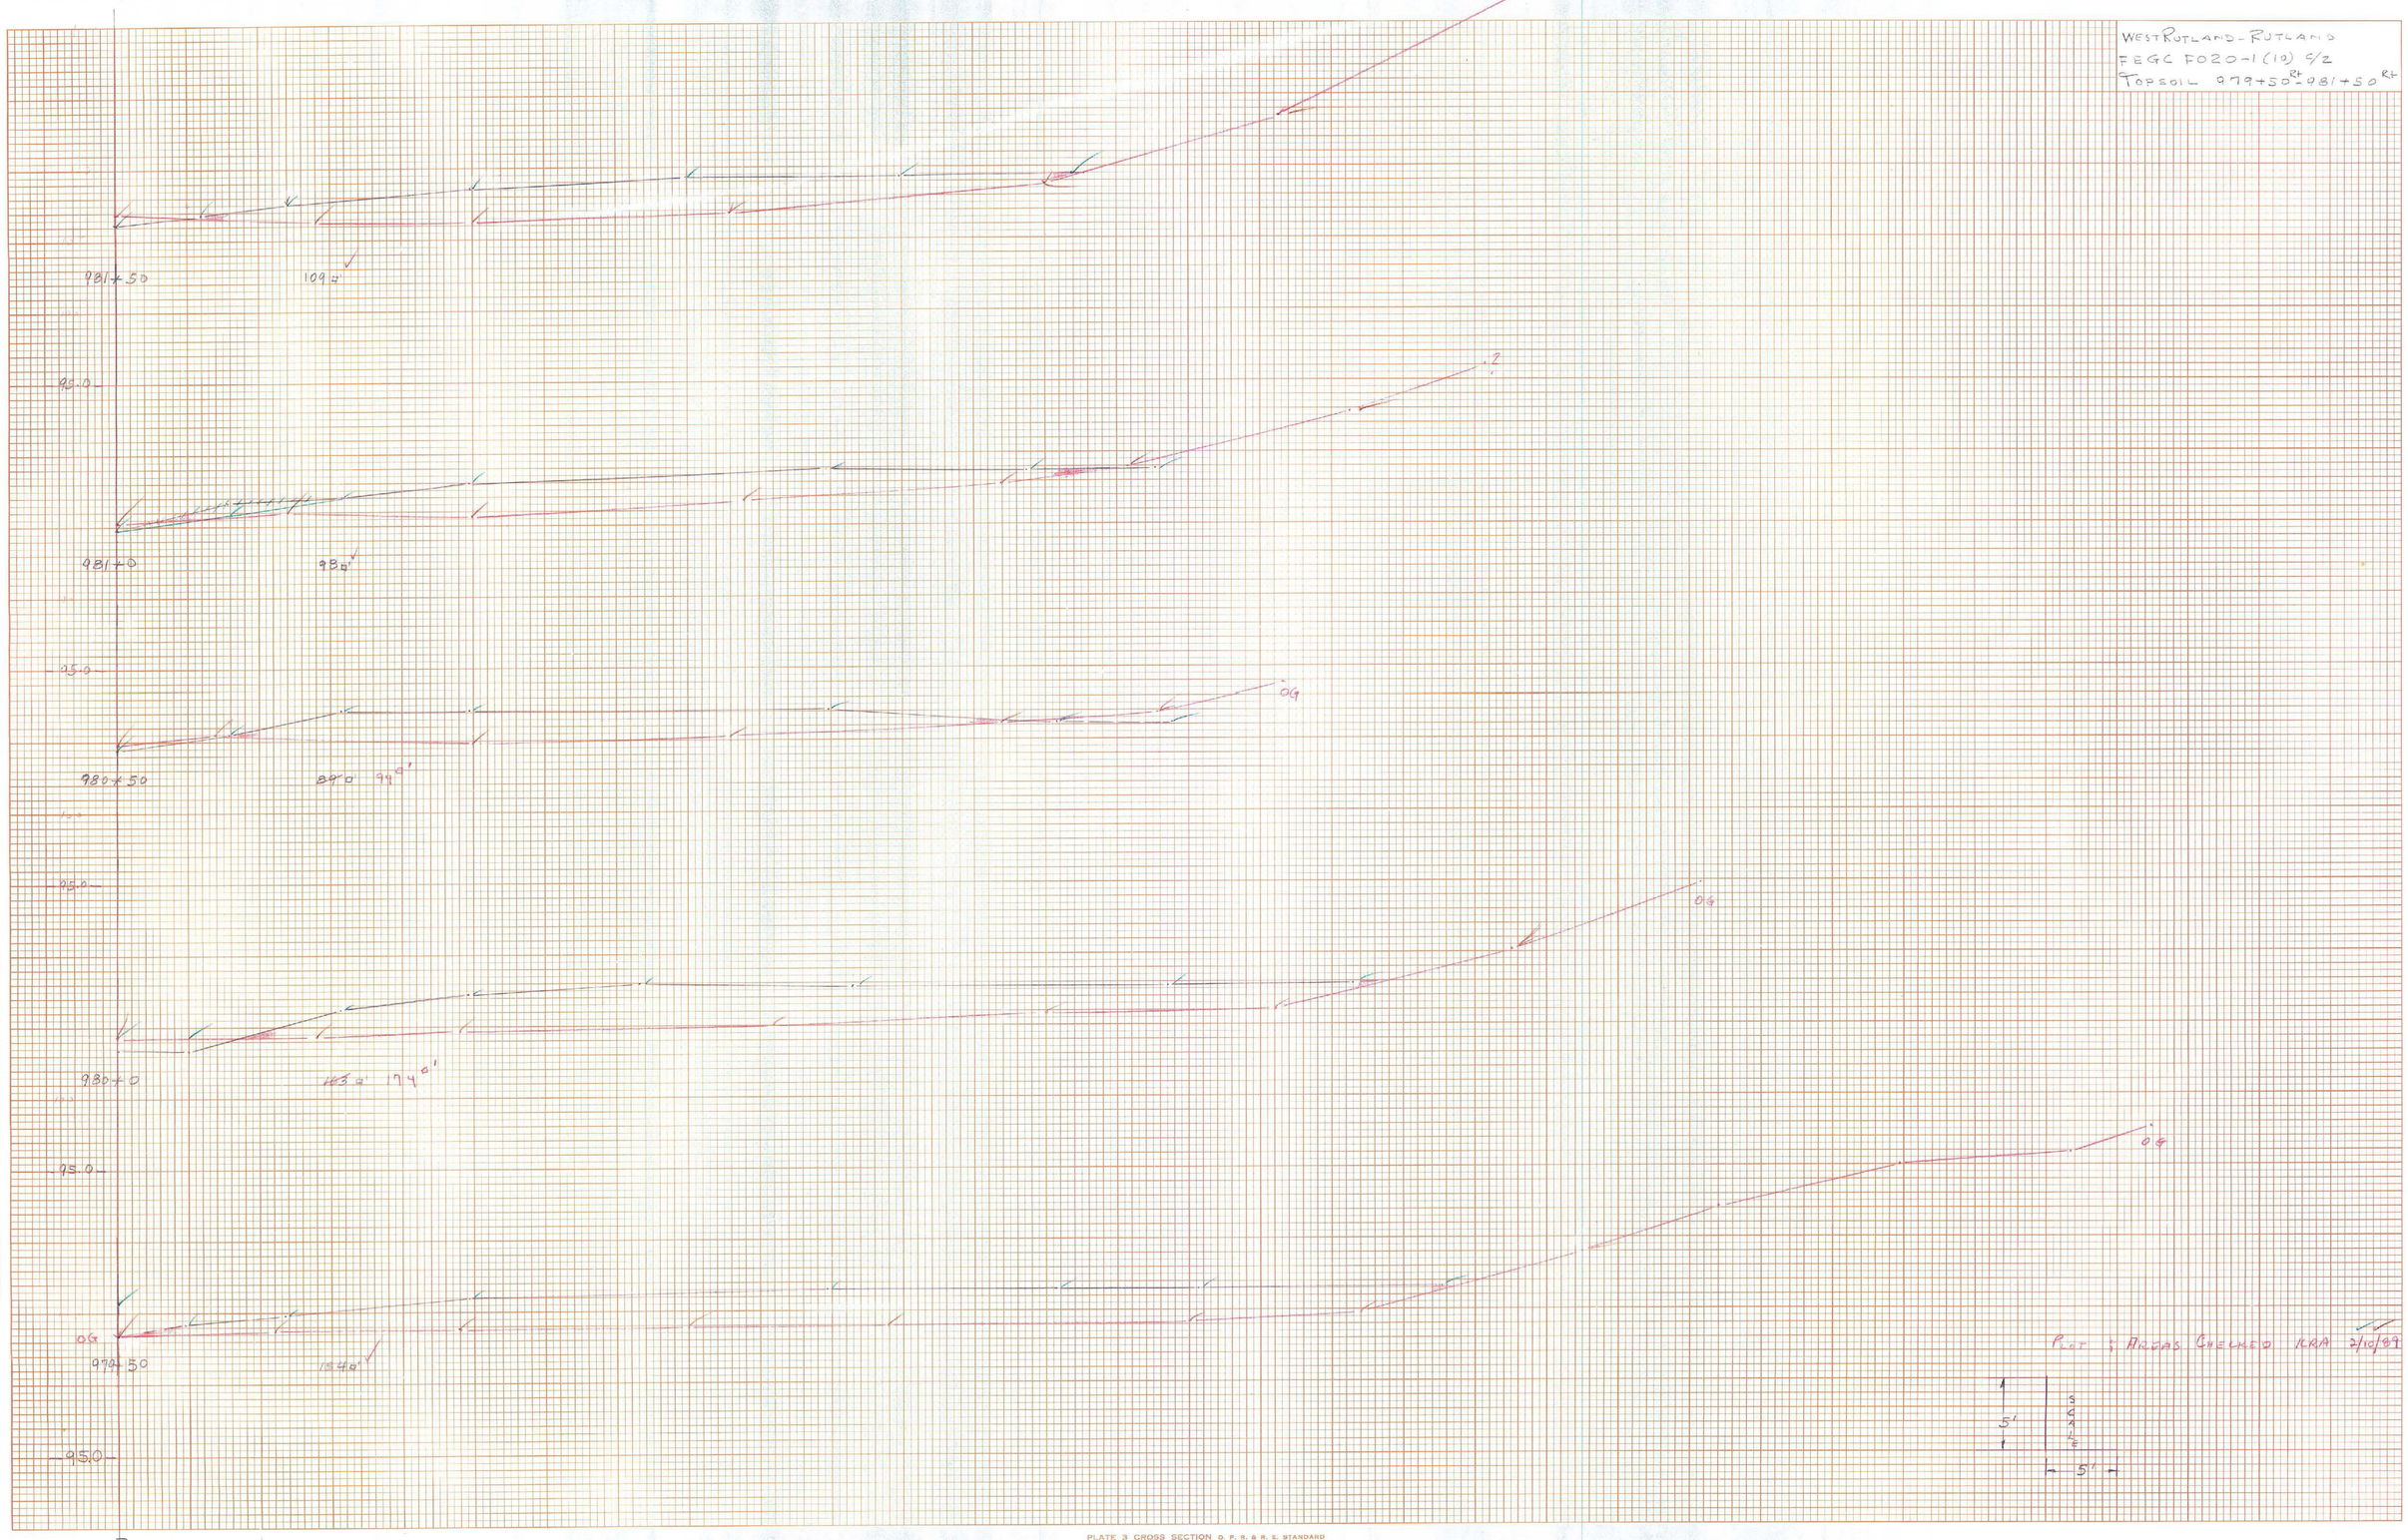


| FINAL SURVEY | | | |
|---|---|---|---|
| NOTE BOOK No. | SURVEYED | BY | DATE |
| | PLOTTED | | |
| | TEMPLATE | | |
| | AREAS | | |
| | AREAS CHECKED | | |

| ORIGINAL SURVEY | | | |
|---|---|---|---|
| NOTE BOOK No. | SURVEYED | BY | DATE |
| | PLOTTED | | |
| | TEMPLATE | | |
| | AREAS | | |
| | AREAS CHECKED | | |

PLATE 3 CROSS SECTION O. P. R. & R. E. STANDARD
DIETZGEN CORPORATION