


DATE _____
 BY _____
 SURVEYED _____
 PLOTTED _____
 TEMPLATE _____
 NOTE BOOK _____
 AREAS CHECKED _____
 NO. _____

DATE _____
 BY _____
 SURVEYED _____
 PLOTTED _____
 TEMPLATE _____
 NOTE BOOK _____
 AREAS CHECKED _____
 NO. _____

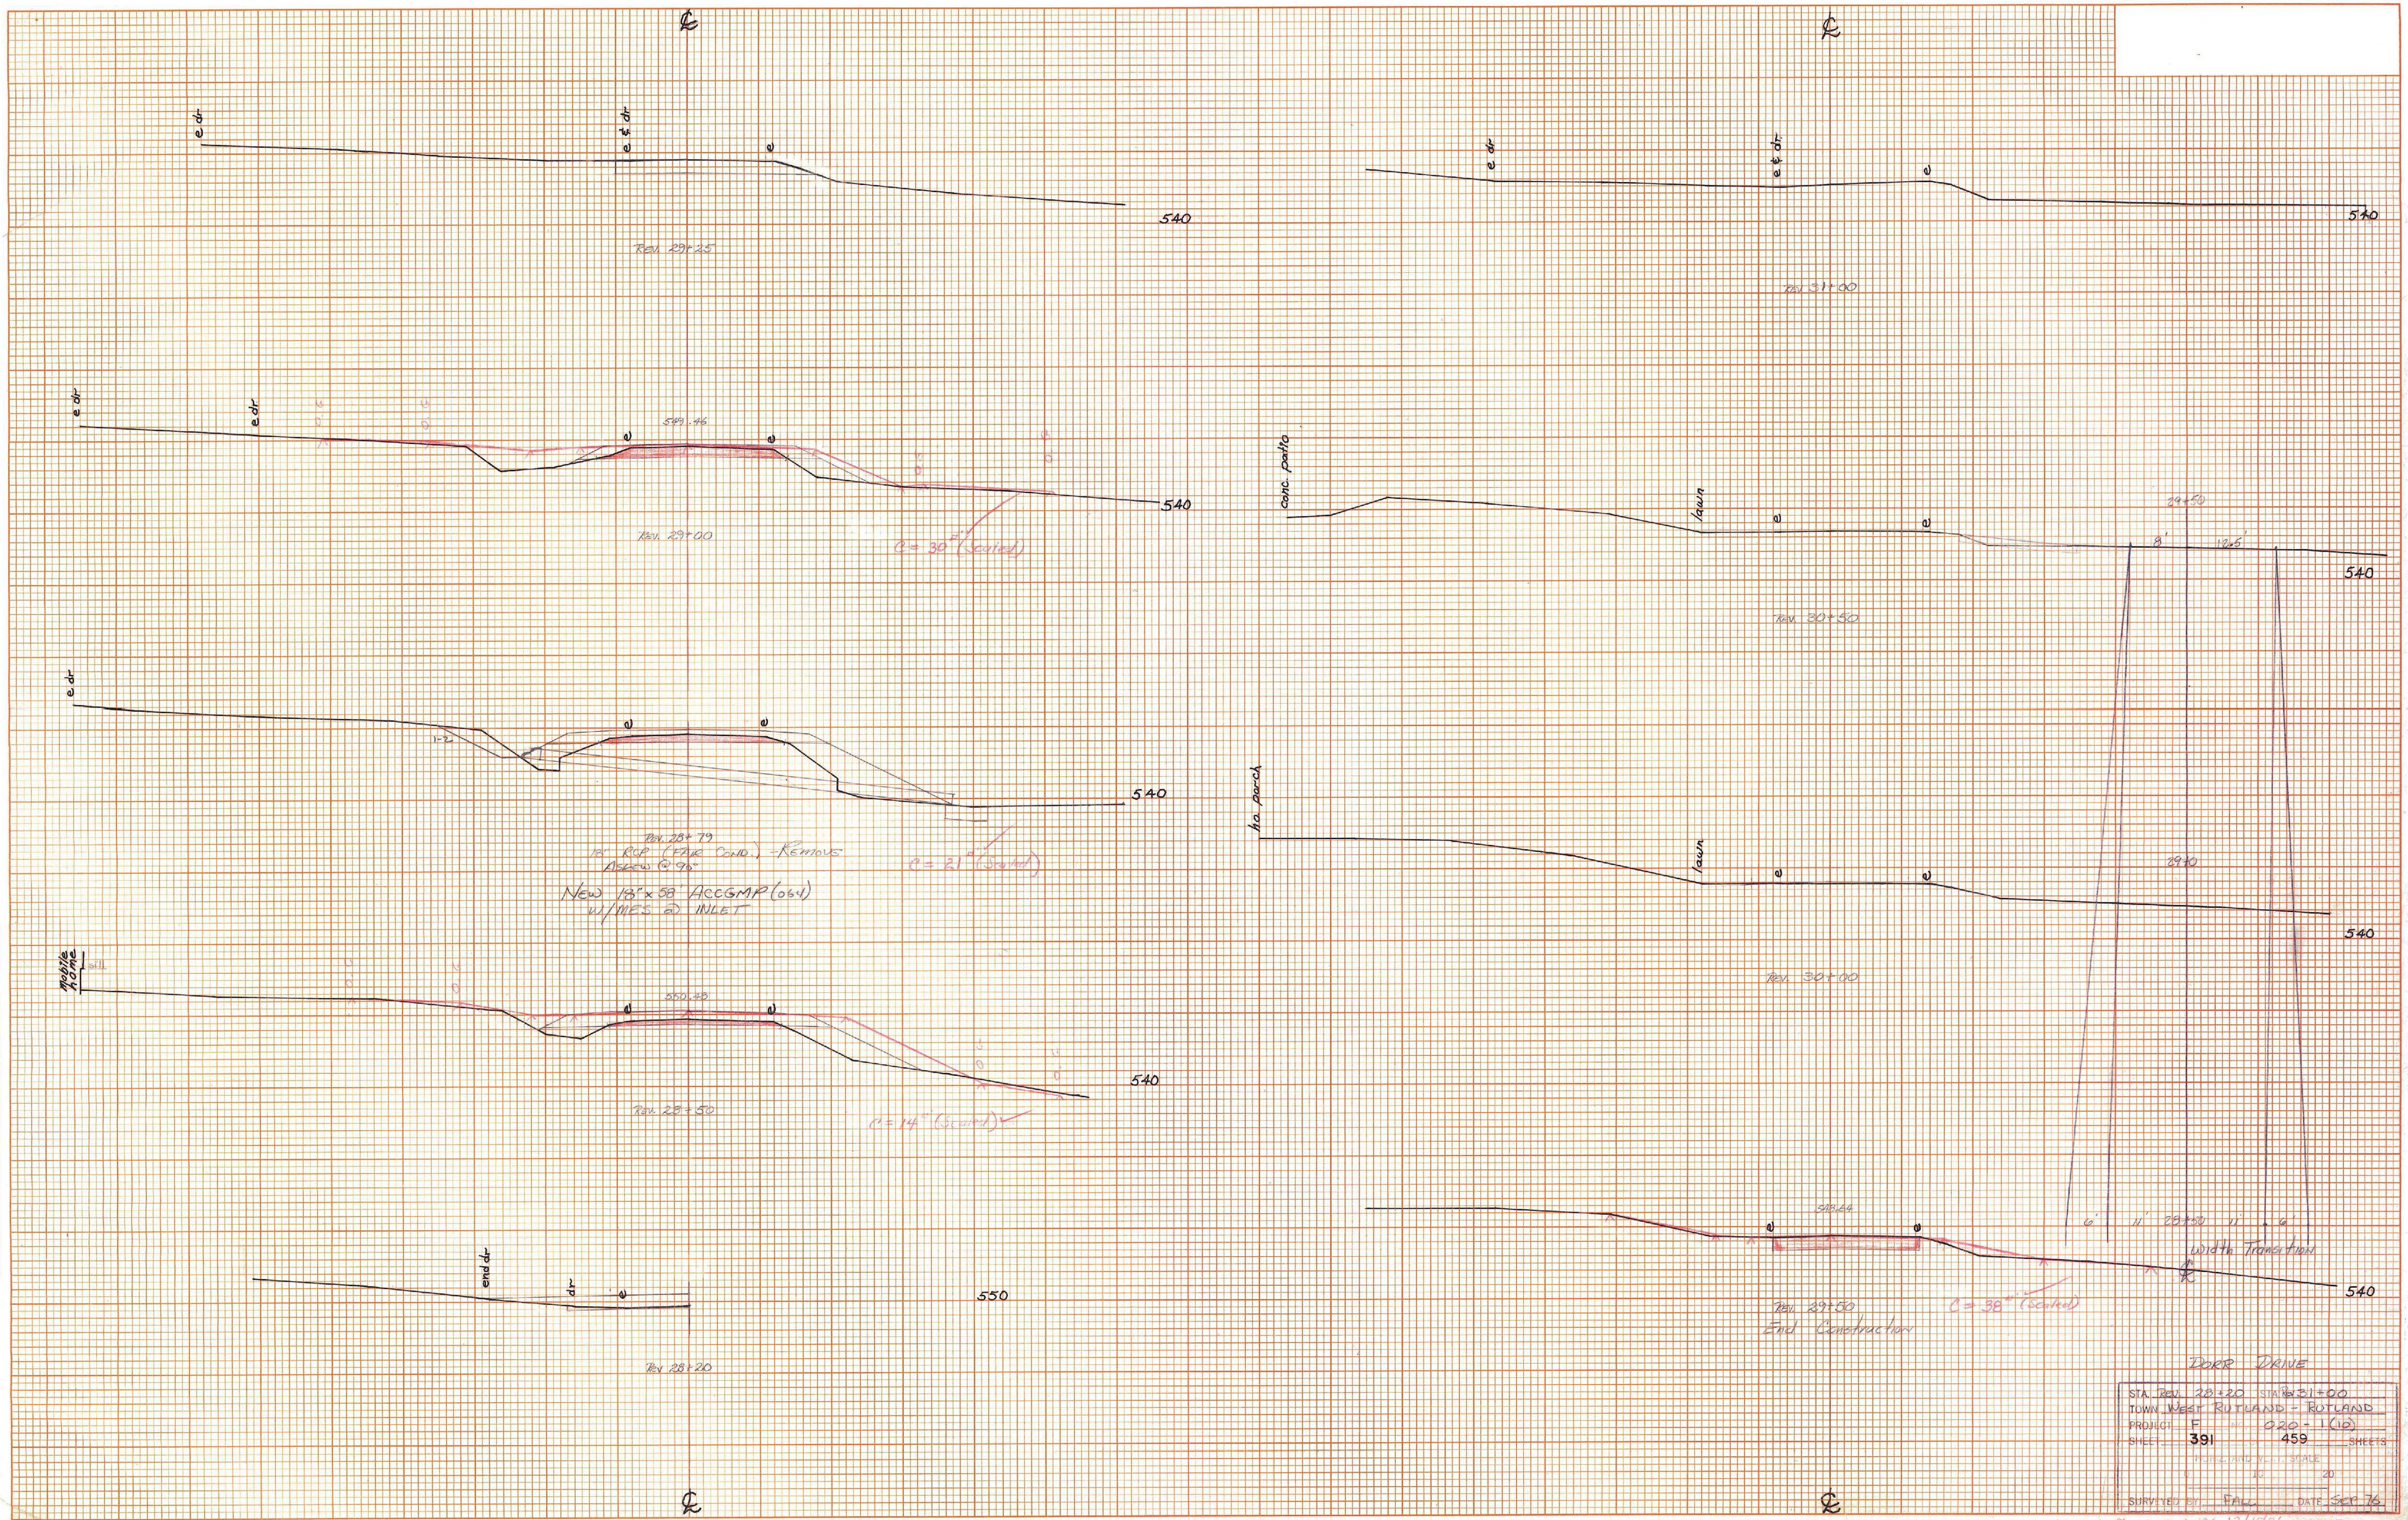

STA. REV. 28+20	STA. REV. 31+00
TOWN WEST RUTLAND - RUTLAND	
PROJECT F	020-1(10)
SHEET 391	459 SHEETS
SURVEYED BY: FALC DATE: SEP 76	

Plot on 12/10/06
 (w/ 2' grid) 28-29-31 Cable TV