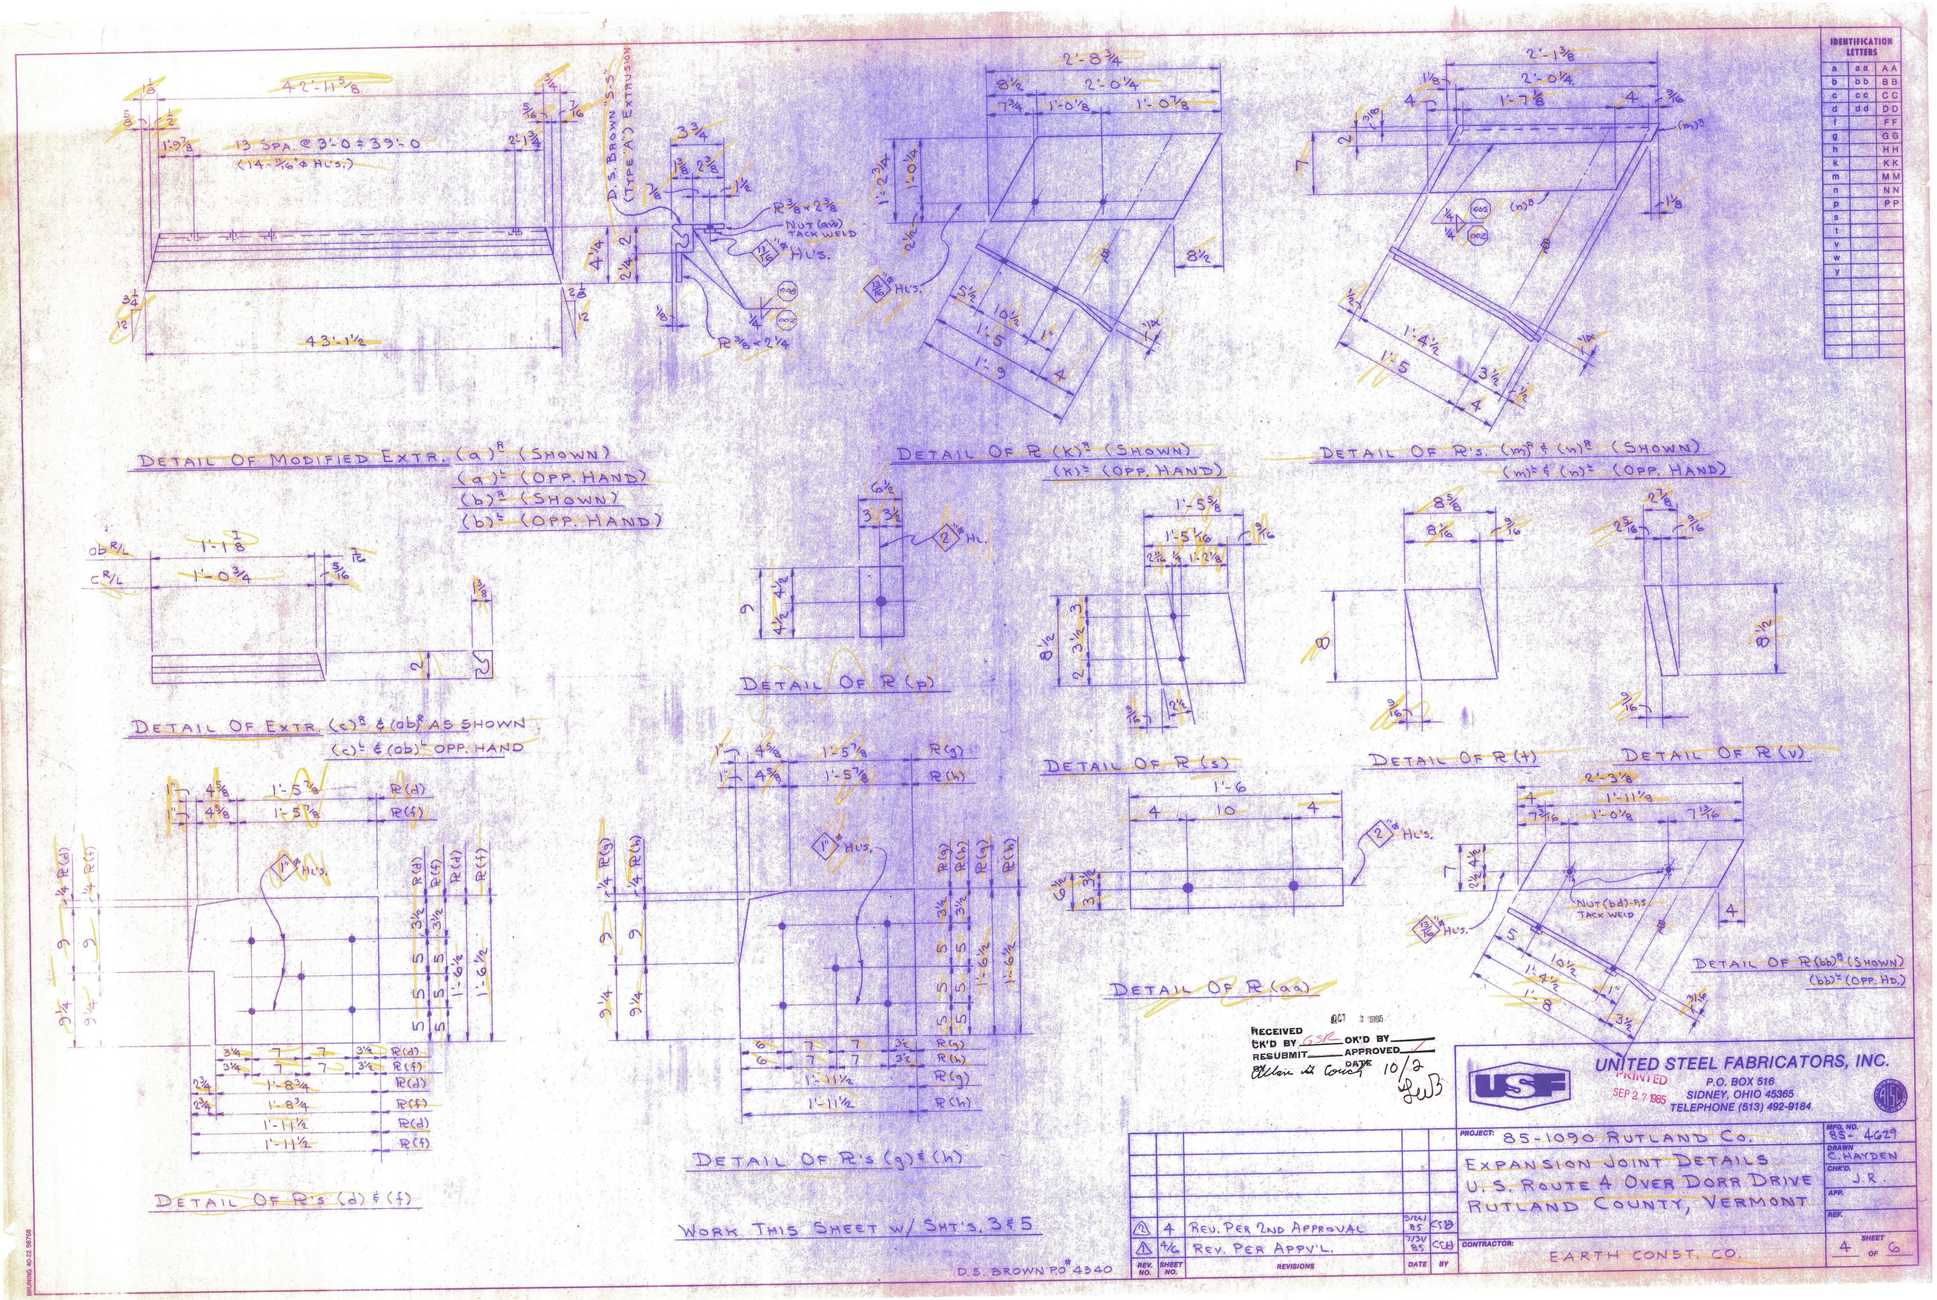

IDENTIFICATION LETTERS		
a	aa	AA
b	bb	BB
c	cc	CC
d	dd	DD
f		FF
g		GG
h		HH
k		KK
m		MM
n		NN
p		PP
s		
t		
v		
w		
y		

RECEIVED OCT 1 1985
CK'D BY GJF OK'D BY
RESUBMIT APPROVED
DATE 10/2
Ellison & Cook

PRINTED SEP 27 1985

UNITED STEEL FABRICATORS, INC.
P.O. BOX 516
SIDNEY, OHIO 45365
TELEPHONE (513) 492-9184

REV. NO.	SHEET NO.	REVISIONS	DATE	BY
3	4	REV. PER 2ND APPROVAL	5/24/85	CJB
2	4/6	REV. PER APPV'L.	7/30/85	CJB

PROJECT: 85-1090 RUTLAND Co.
EXPANSION JOINT DETAILS
U.S. ROUTE 4 OVER DORR DRIVE
RUTLAND COUNTY, VERMONT

CONTRACTOR: EARTH CONST. CO.

MFG. NO. 85-4029
DRAWN C. HAYDEN
CHK'D. J.R.
APP.
REF.
SHEET 4 OF 6