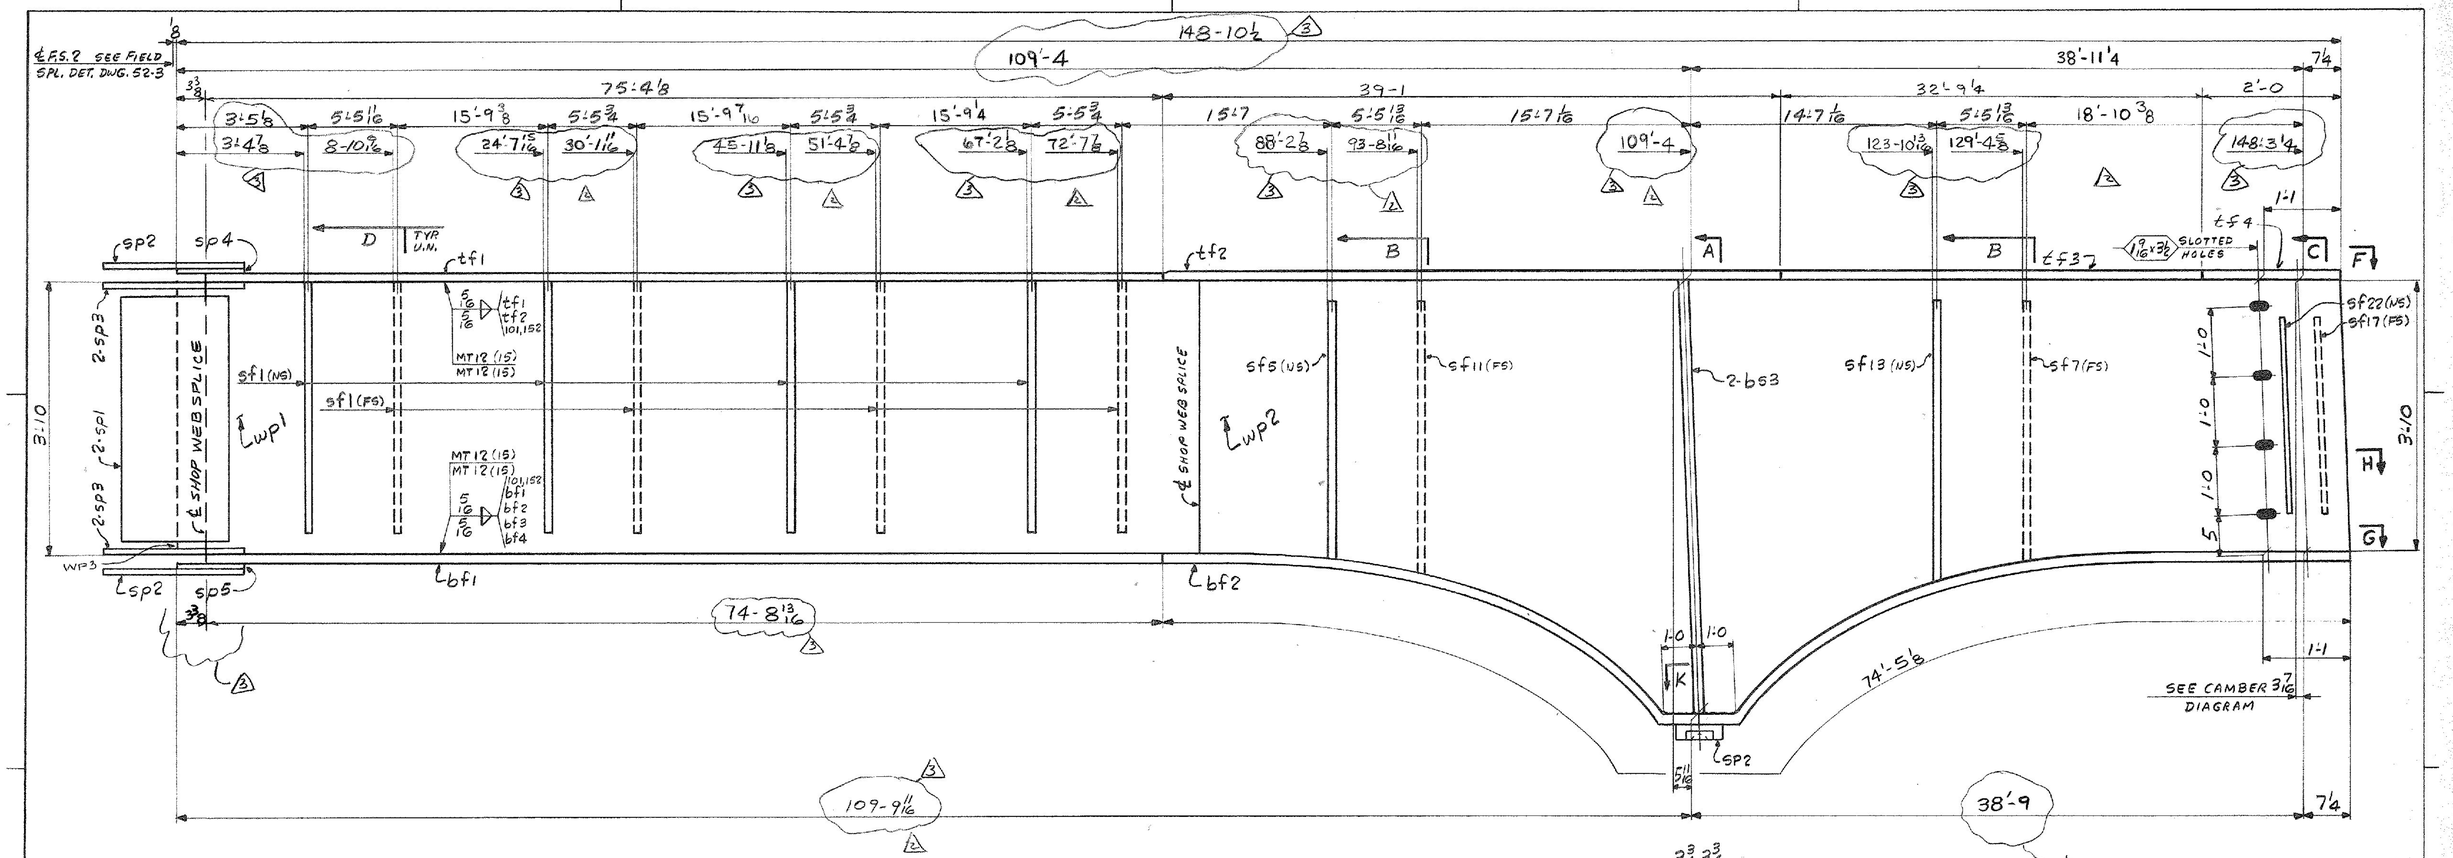

ONE - GIRDER - HG3C

FOR GIRDER STANDARD DETAILS SEE DWG. 52-3
FOR WEB ℄ CUTTING SK. & FLG. ℄ ASSY SEE DWG. 52-2
FOR SHOP ASSEMBLY DIAGRAM SEE DWG. 52-1

WORK THIS DWG. WITH DWG. 52-21

(7) 11-7-84 APP
(8) 12-7-84 FAB

△3 MK END & EXT DIMS
△2 EXT DIMS
△1 CHANGE FLG SPL LOCATIONS

IT. NO. 506.91	BR. NO. 4	PROJ. NO. F020-1(10)
FOR APPROVAL	FOR FILES & FIELD	

GIRDER - HG3C

APPROVED: 5-17-84

PRINT DIST.		
7	4-11-84	APP.
8	6-27-84	FAB.
NR	—	F&F.
7	10-4-84	APP
8	10-9-84	FAB
8	10-23-84	FAB
7	10-23-84	APP
△2	10-22-84	JCM
REV. △1	10-3-84	JCM
CHECKED	4/2/84	GK
DRAWN	3-8-84	ELC

Bancroft & Martin Inc.
South Portland, Maine 04106

JOB: T.H. 22 OVER U.S.4 E.B. & W.B. RUTLAND, VERMONT

CUSTOMER: M & J CONSTRUCTION CO.

DESIGNER: STATE OF VERMONT, AGENCY OF TRANSP.

ORDER NO.	JOB NO.	DRAWING NO.	REV.
	4-7	52-20	△2

TENSOR 921-08

HARLAN F. SPILLER CO.