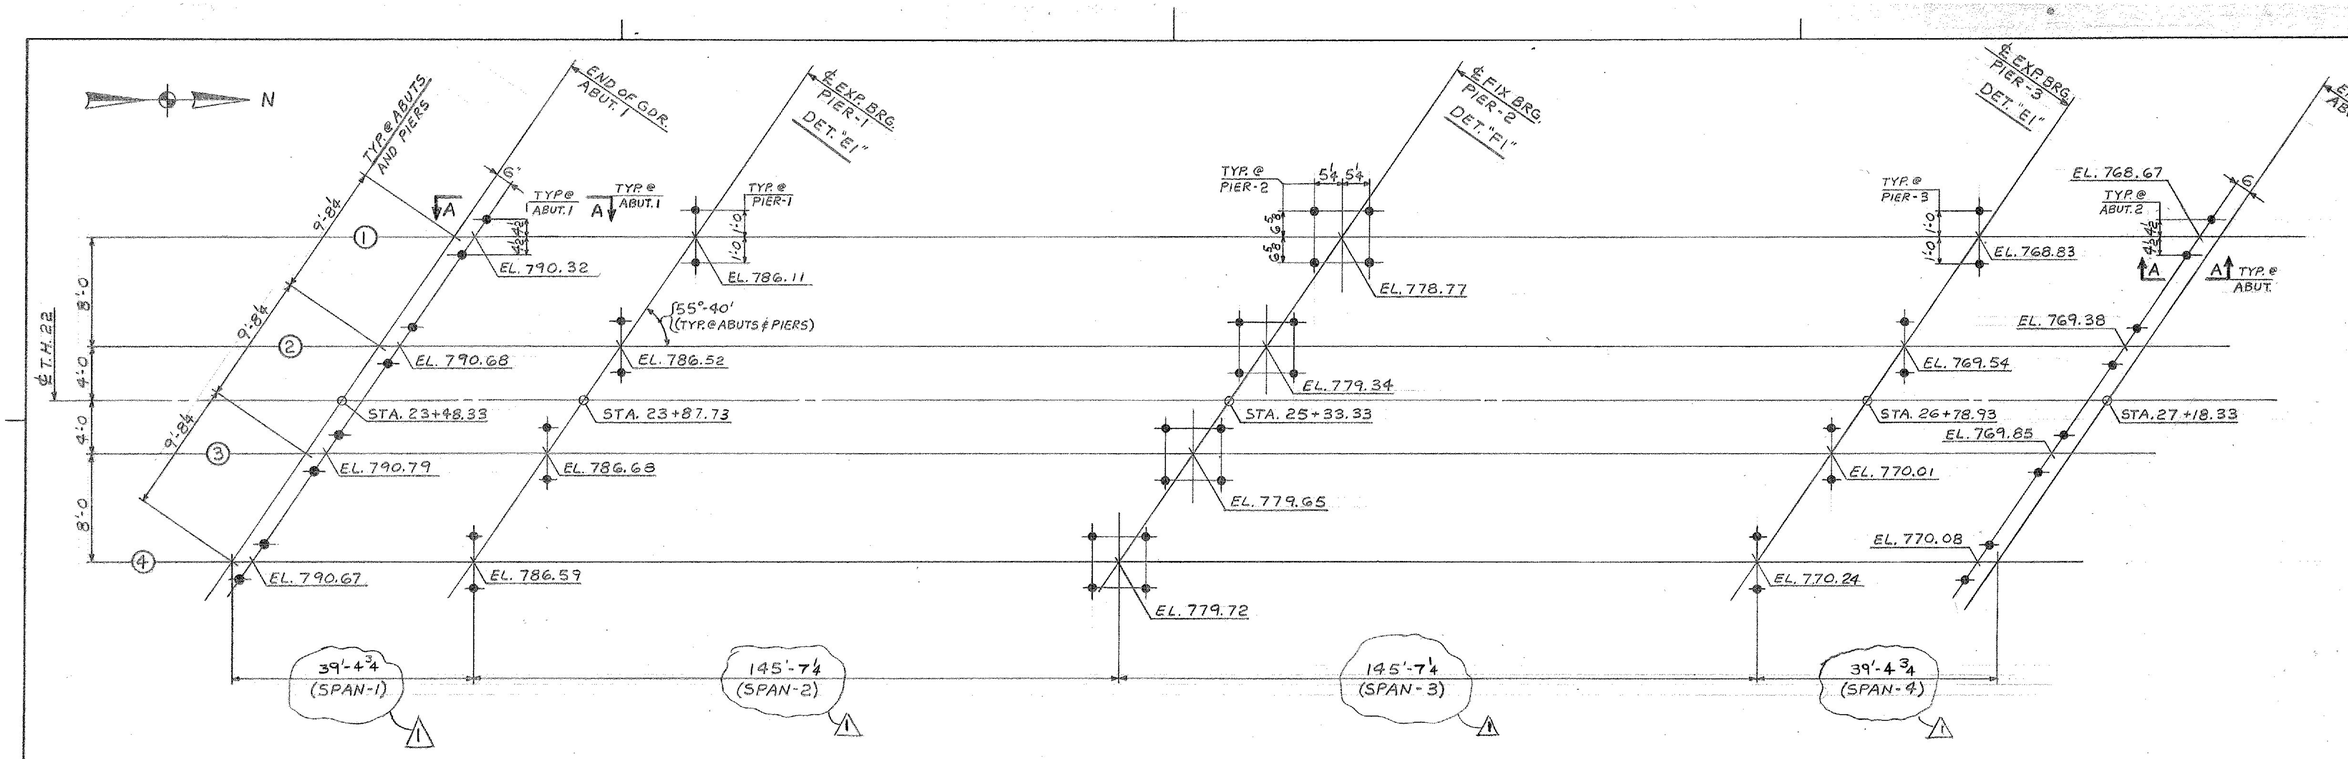

ANCHOR BOLT PLAN

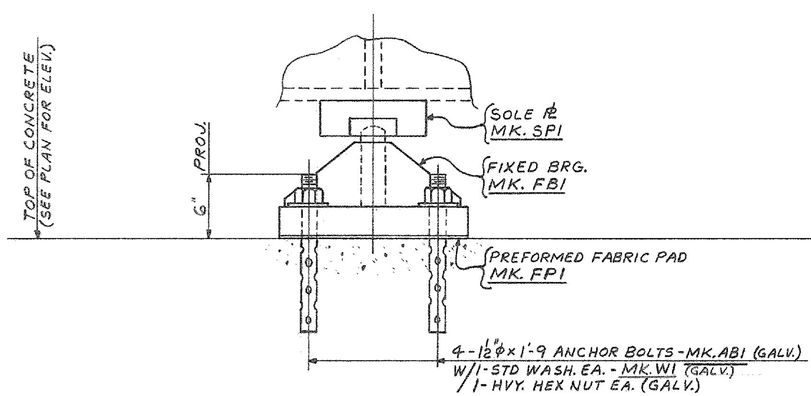

DETAIL "F1"
FIXED BRG @ PIER-2

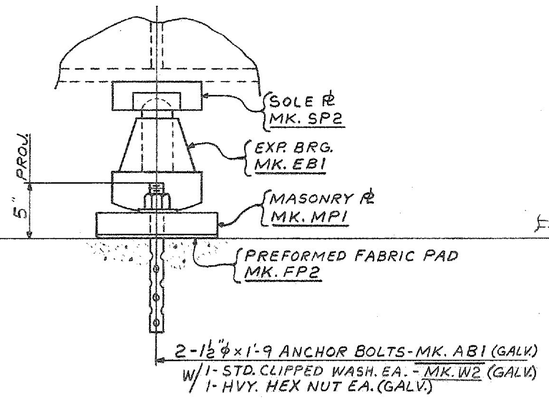

DETAIL "E1"
EXP. BRG. @ PIERS 1 & 3

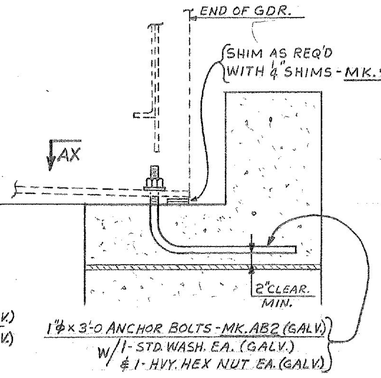

SECTION A-A
END OF GDR @ ABUTS. 1 & 2

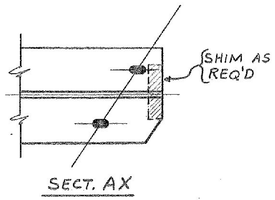

SECT. AX

NOTES:

1. ALL DIMENSIONS ARE TAKEN IN A HORIZONTAL PLANE.
2. ALL DIMENSIONS MUST BE STRICTLY ADHERED TO, OTHERWISE, STEEL WILL NOT FIT. IN CASE OF ERROR NOTIFY BANCROFT & MARTIN INC. AT ONCE.
3. ANCHOR BOLTS ARE FURNISHED BY BANCROFT & MARTIN INC. AND SET BY OTHERS.
4. SOLE PLATES ARE SHOP WELDED TO GIRDERS. MARKS ARE GIVEN FOR REFERENCE ONLY.

IT. NO. 506.99	BR. NO. 4	PROJ. NO. F020-1(10)	
FOR APPROVAL	FOR FILES & FIELD		
ANCHOR BOLT PLAN			
APPROVED: 5-17-84	Bancroft & Martin Inc.		
PRINT DIST.	South Portland, Maine 04106		
7 3-1-84 APP.	JOB: T.H. 22 OVER U.S. RTE. 4 E.B. & W.B. RUTLAND, VERMONT		
8 6-7-84 FAB.			
F&F.			
7 4-11-84 APP	CUSTOMER: EARTH CONSTRUCTION		
8 10-23-84 FAB			
7 10-23-84 APP	DESIGNER: STATE OF VERMONT AGENCY OF TRANS.		
7 10-31-84 APP			
8 10-31-84 FAB			
REV. ⚠ 10-22-84 JCM	ORDER NO.	JOB NO.	DRAWING NO. REV.
CHECKED 4/27/84 LT		4-11	E-1 ⚠2
DRAWN 2-22-84 RLA			

① 11-19-84 APP
② 11-19-84 FAB

⚠ PAD ELEV PIER 1 & 3

⚠2 PAD ELEV 1CM PIER 1 & 3 11/19/84

TENSOR 921-03

HARLAN F. SPILLER CO.