


GUARD RAIL, STANDARD STEEL BEAM W/
STEEL POSTS, TYPE II, 6'-3" SPACING
EB 972+00 TO 988+00 RT.
WB 972+00± TO 988+00 LT

WOVEN WIRE FENCE W/STEEL POSTS
WB 972+00 TO 972+55 LT
EB 972+00 TO 973+05 RT.
EB 974+40 TO 988+00 RT.
WB 973+90 TO 988+00 LT.

TREATED TIMBER CURB
EB 972+00 TO 988+00 RT.
WB 972+00 TO 988+00 LT.

BM - CHC-B
VT. H.D. DISK
ON HDR.
U.S. ELEV.
534.949

B.M. 36 R
SIR 12" E
U.S. ELEV.
546.829

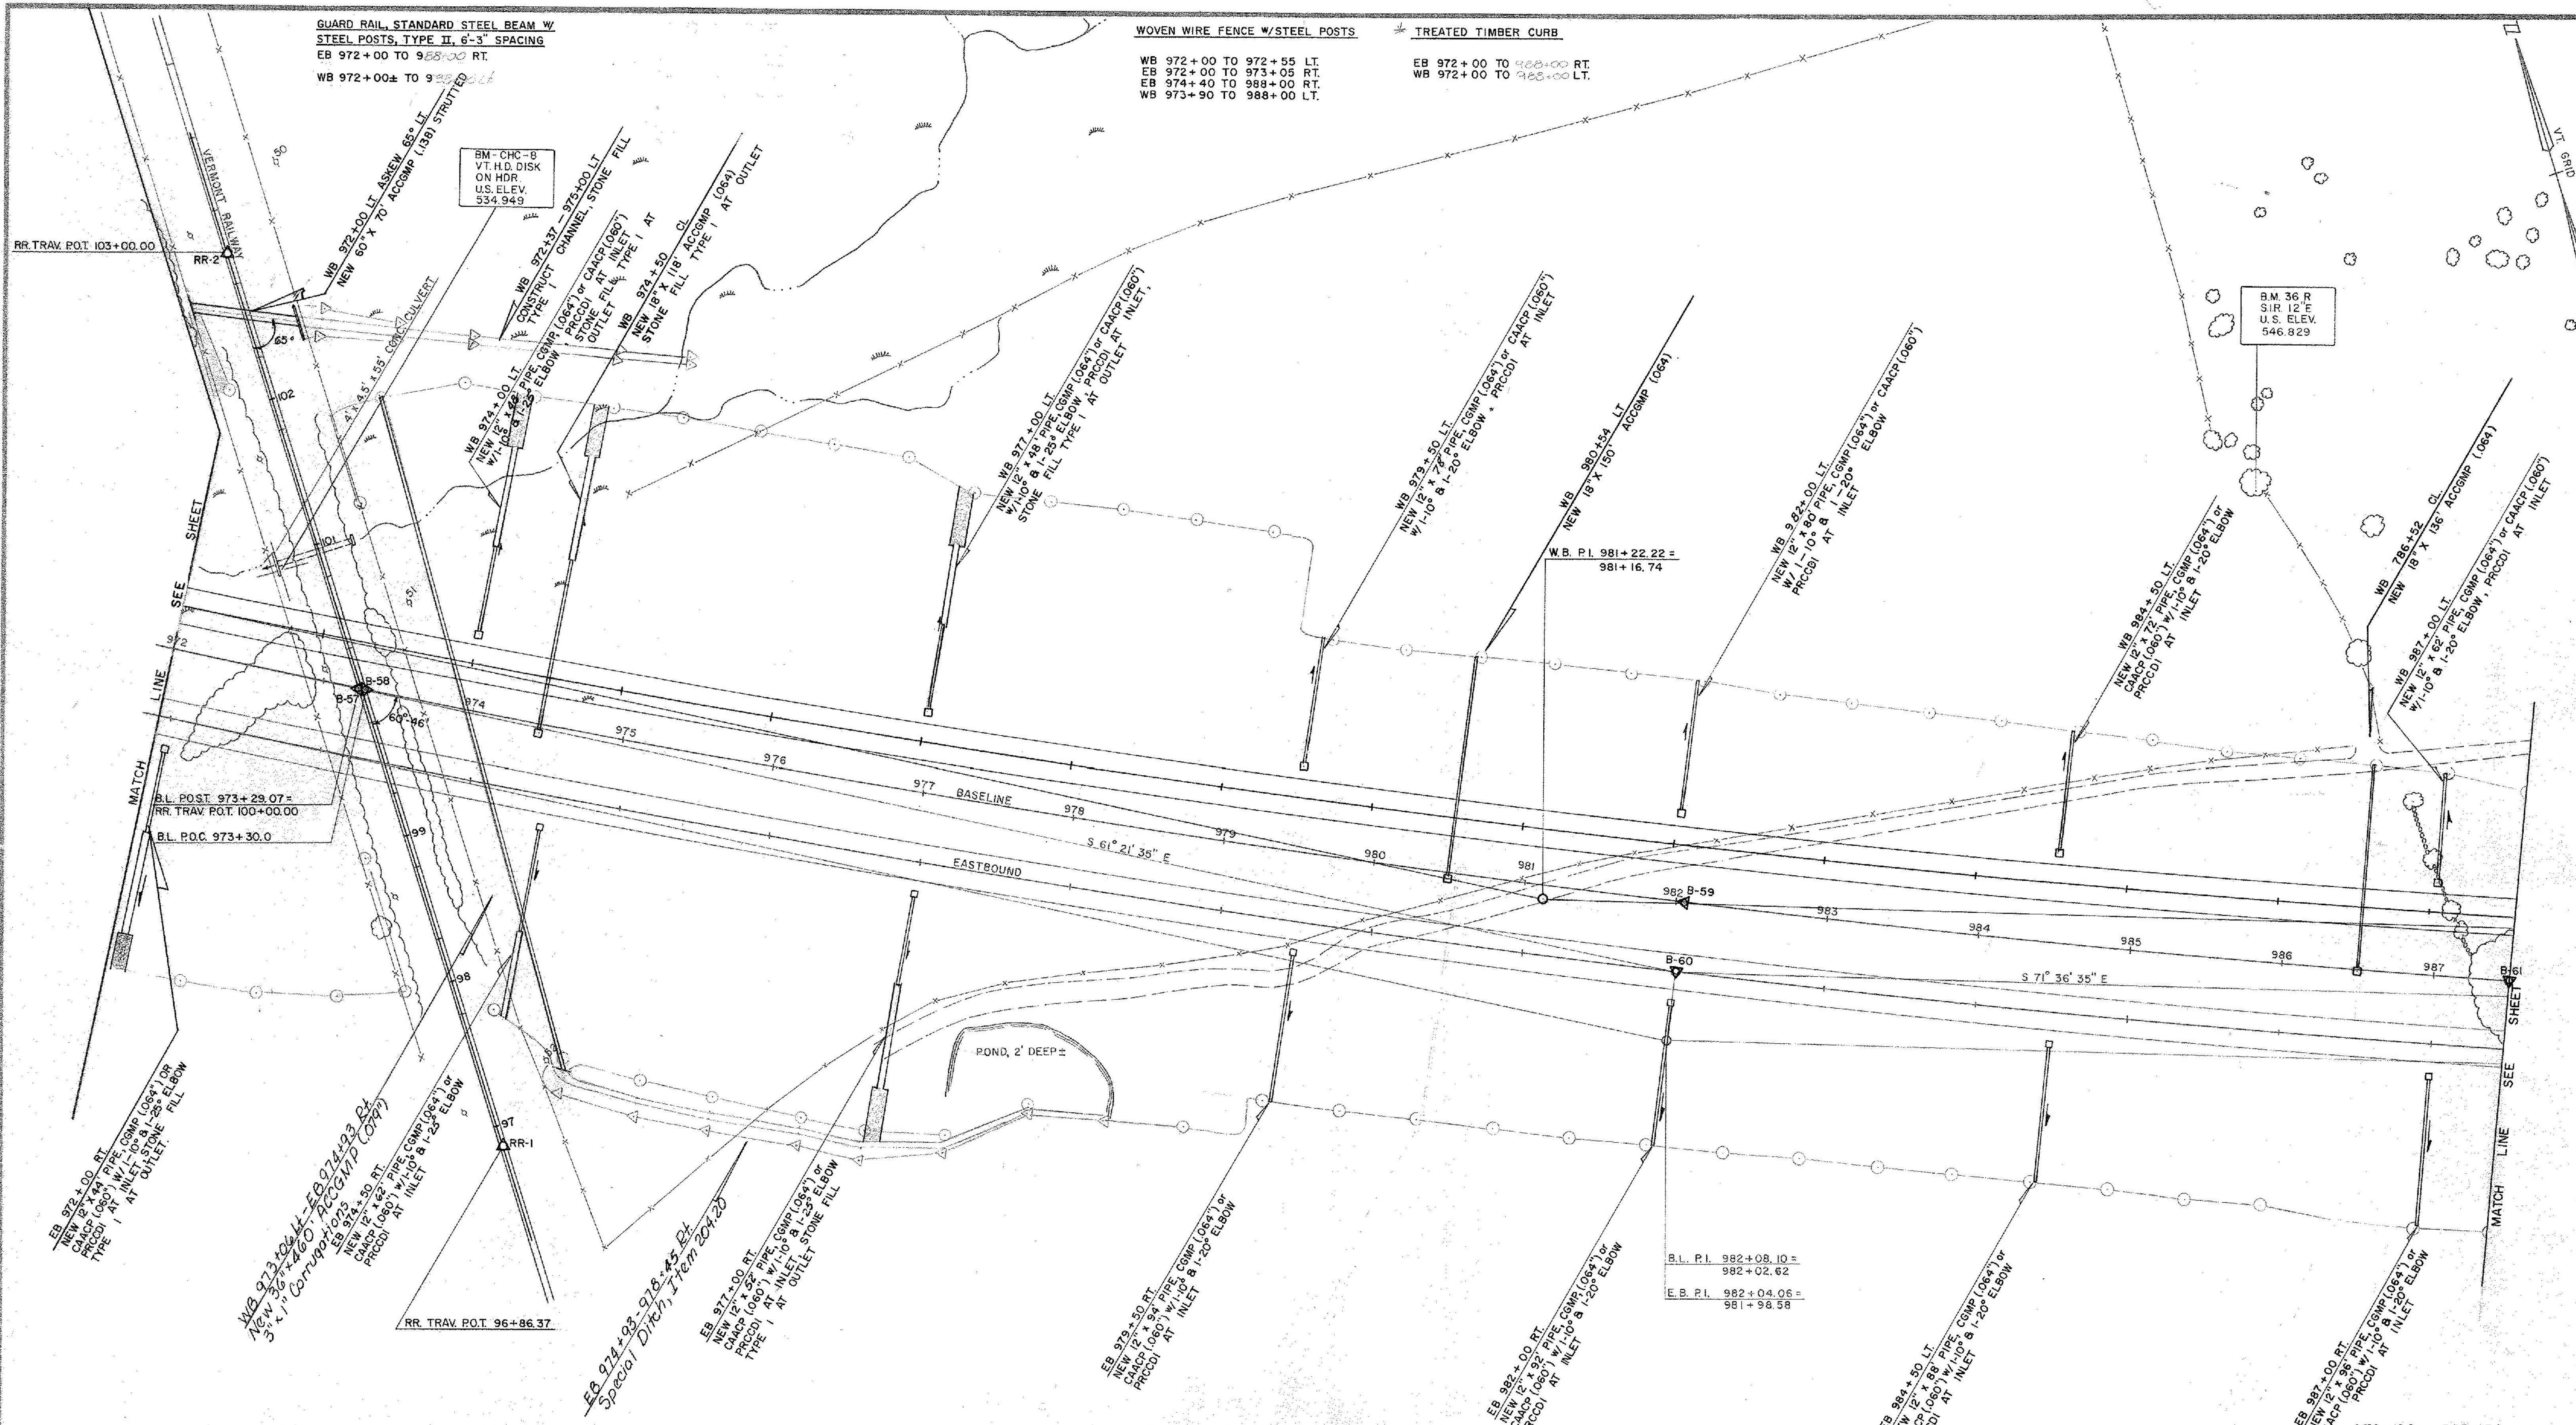

UNCLASSIFIED CHANNEL EXCAVATION
ITEM 203.27
WB 972+37 TO 975+00 LT.

STONE FILL, TYPE I, ITEM 613.10
WB 972+37 TO 973+00 LT.

COUNTERWEIGHT BERM
WB 972+00 TO 979+35 LT.
EB 972+00 TO 979+35 RT.

SETTLEMENT PLATFORM, TYPE II
ITEM 623.22
EB 973+00 E
EB 978+00 E

A 10° 15' LT.
D 0° 30'
R 11459.16
T 1027.74
L 2050.00
E 46.00
DO NOT BANK

0 50 100
SCALE IN FEET

972+00 - 987+50
WEST RUTLAND - RUTLAND

SURVEYED BY FALL DATE JUNE '75
DRAWN BY DZG DATE JULY '75
TRACED BY DZG DATE JULY '75

STAGE I CONSTRUCTION

PROJ. F NO. 020-1(10)

SHEET OF