PLAN	BY	DATE
NOTE BOOK NO.	SURVEYED	
	PLOTTED	
	ALIGNMENT CHECKED	
	ST. OF PLAN CHECKED	
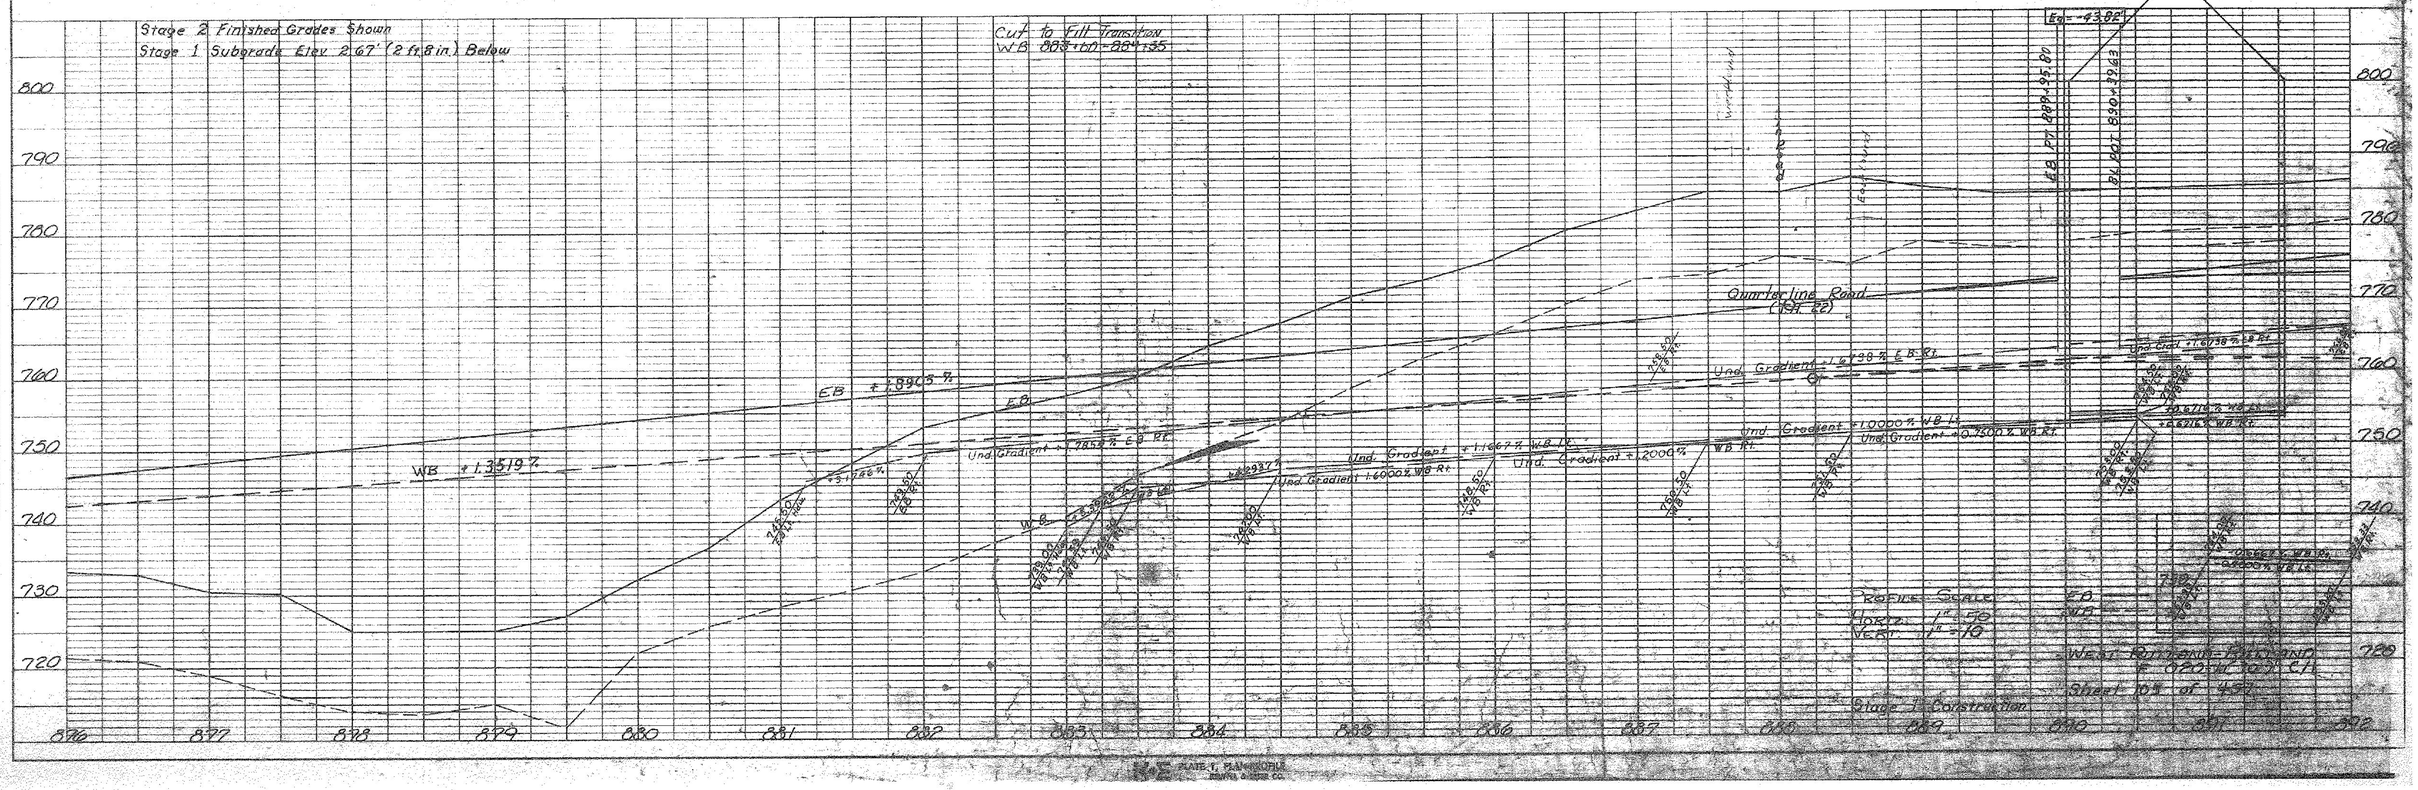
PROFILE	BY	DATE
NOTE BOOK NO.	SURVEYED	
	PLOTTED	
	GRADES CHECKED	
	ALIGNMENT	
	STRUCTURE NOTATIONS CH'KD