



PLAN	SURVEYED	DATE
	PLOTTED	BY
	ALIGNMENT CHECKED	
	RT. OF WAY CHECKED	
NOTE BOOK NO.		

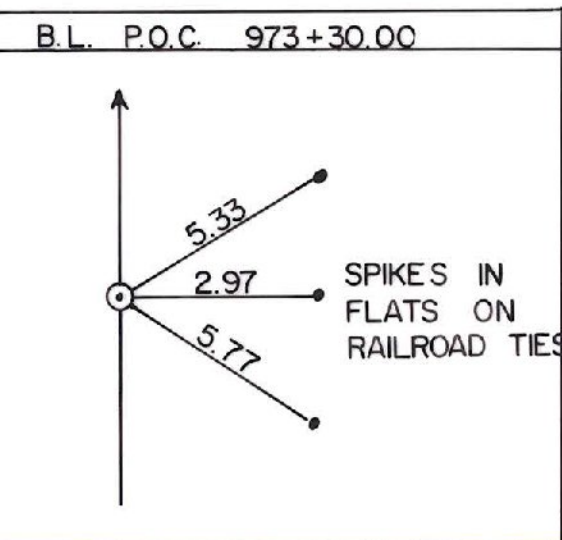

PROFILE	SURVEYED	DATE
	GRADES CHECKED	BY
	STRUCTURE NOTATIONS CHDWD	
NOTE BOOK NO.		

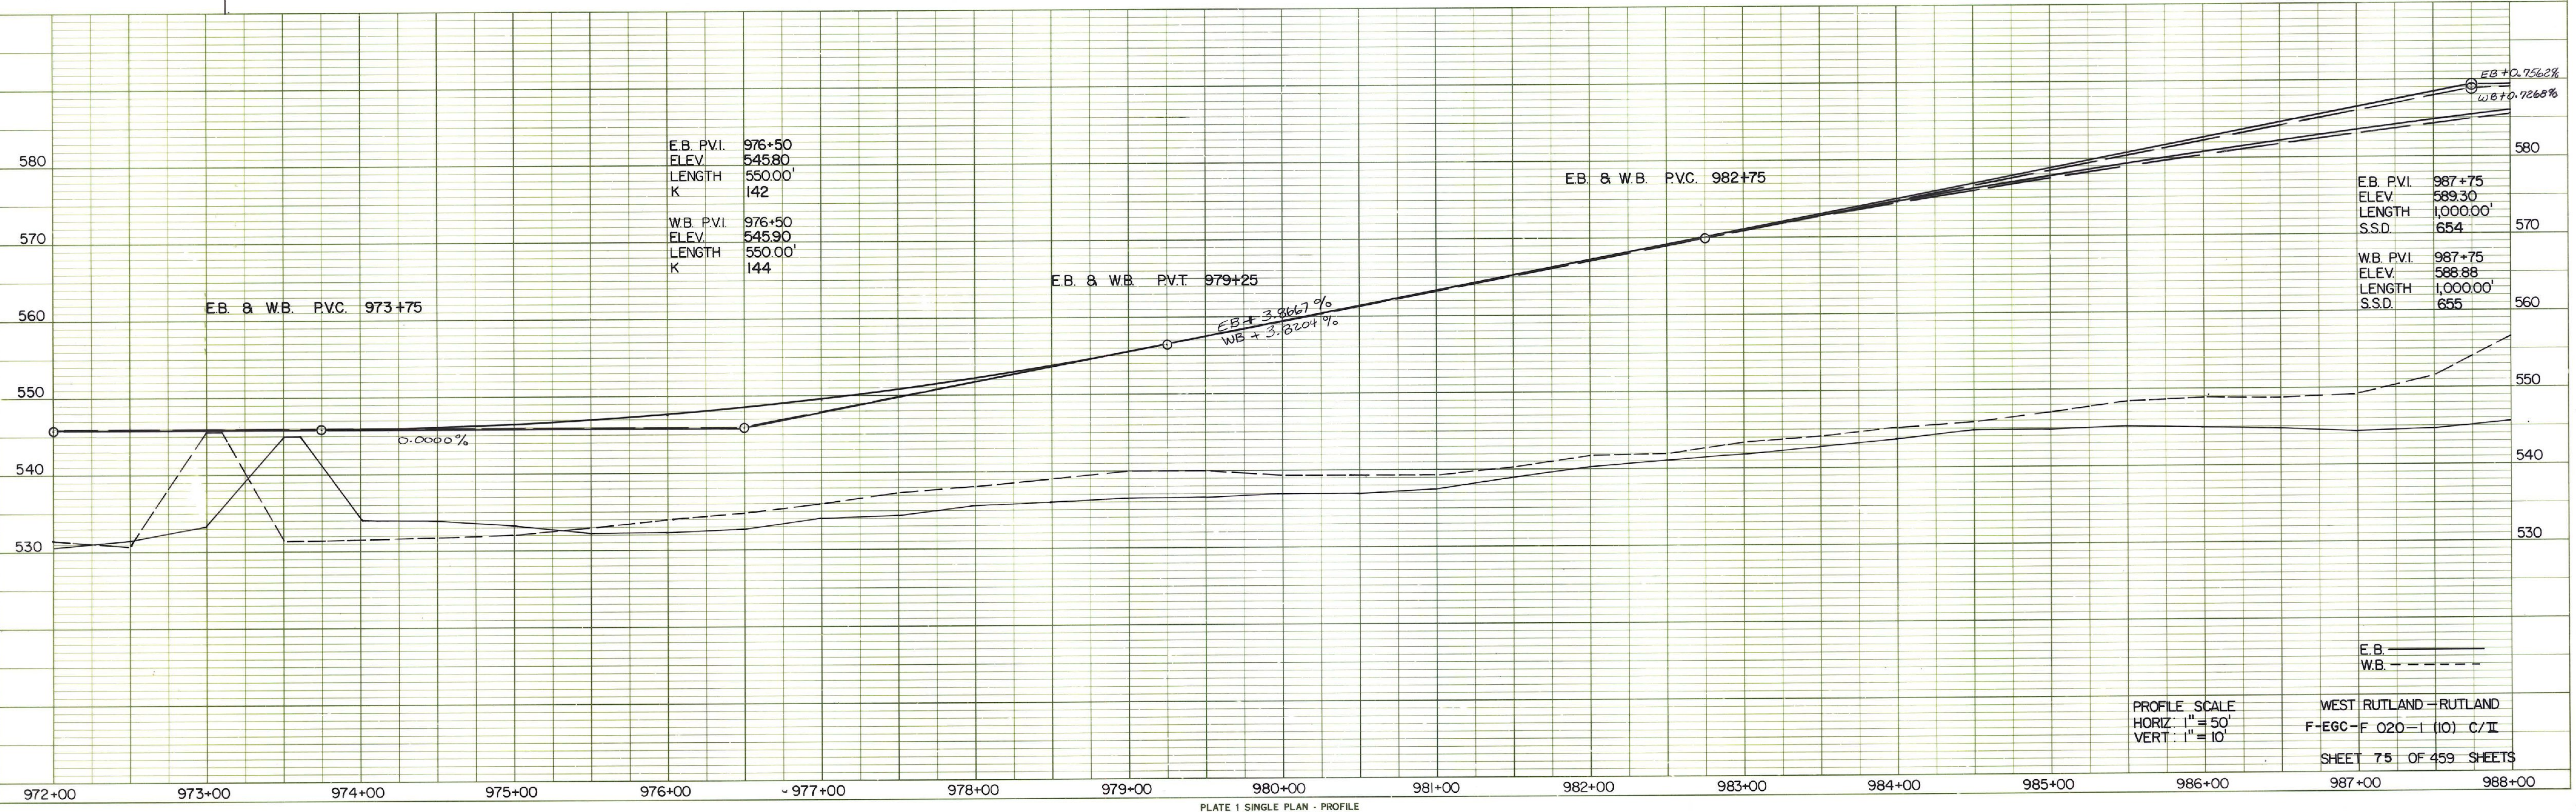

BRUNING 44-131 53428