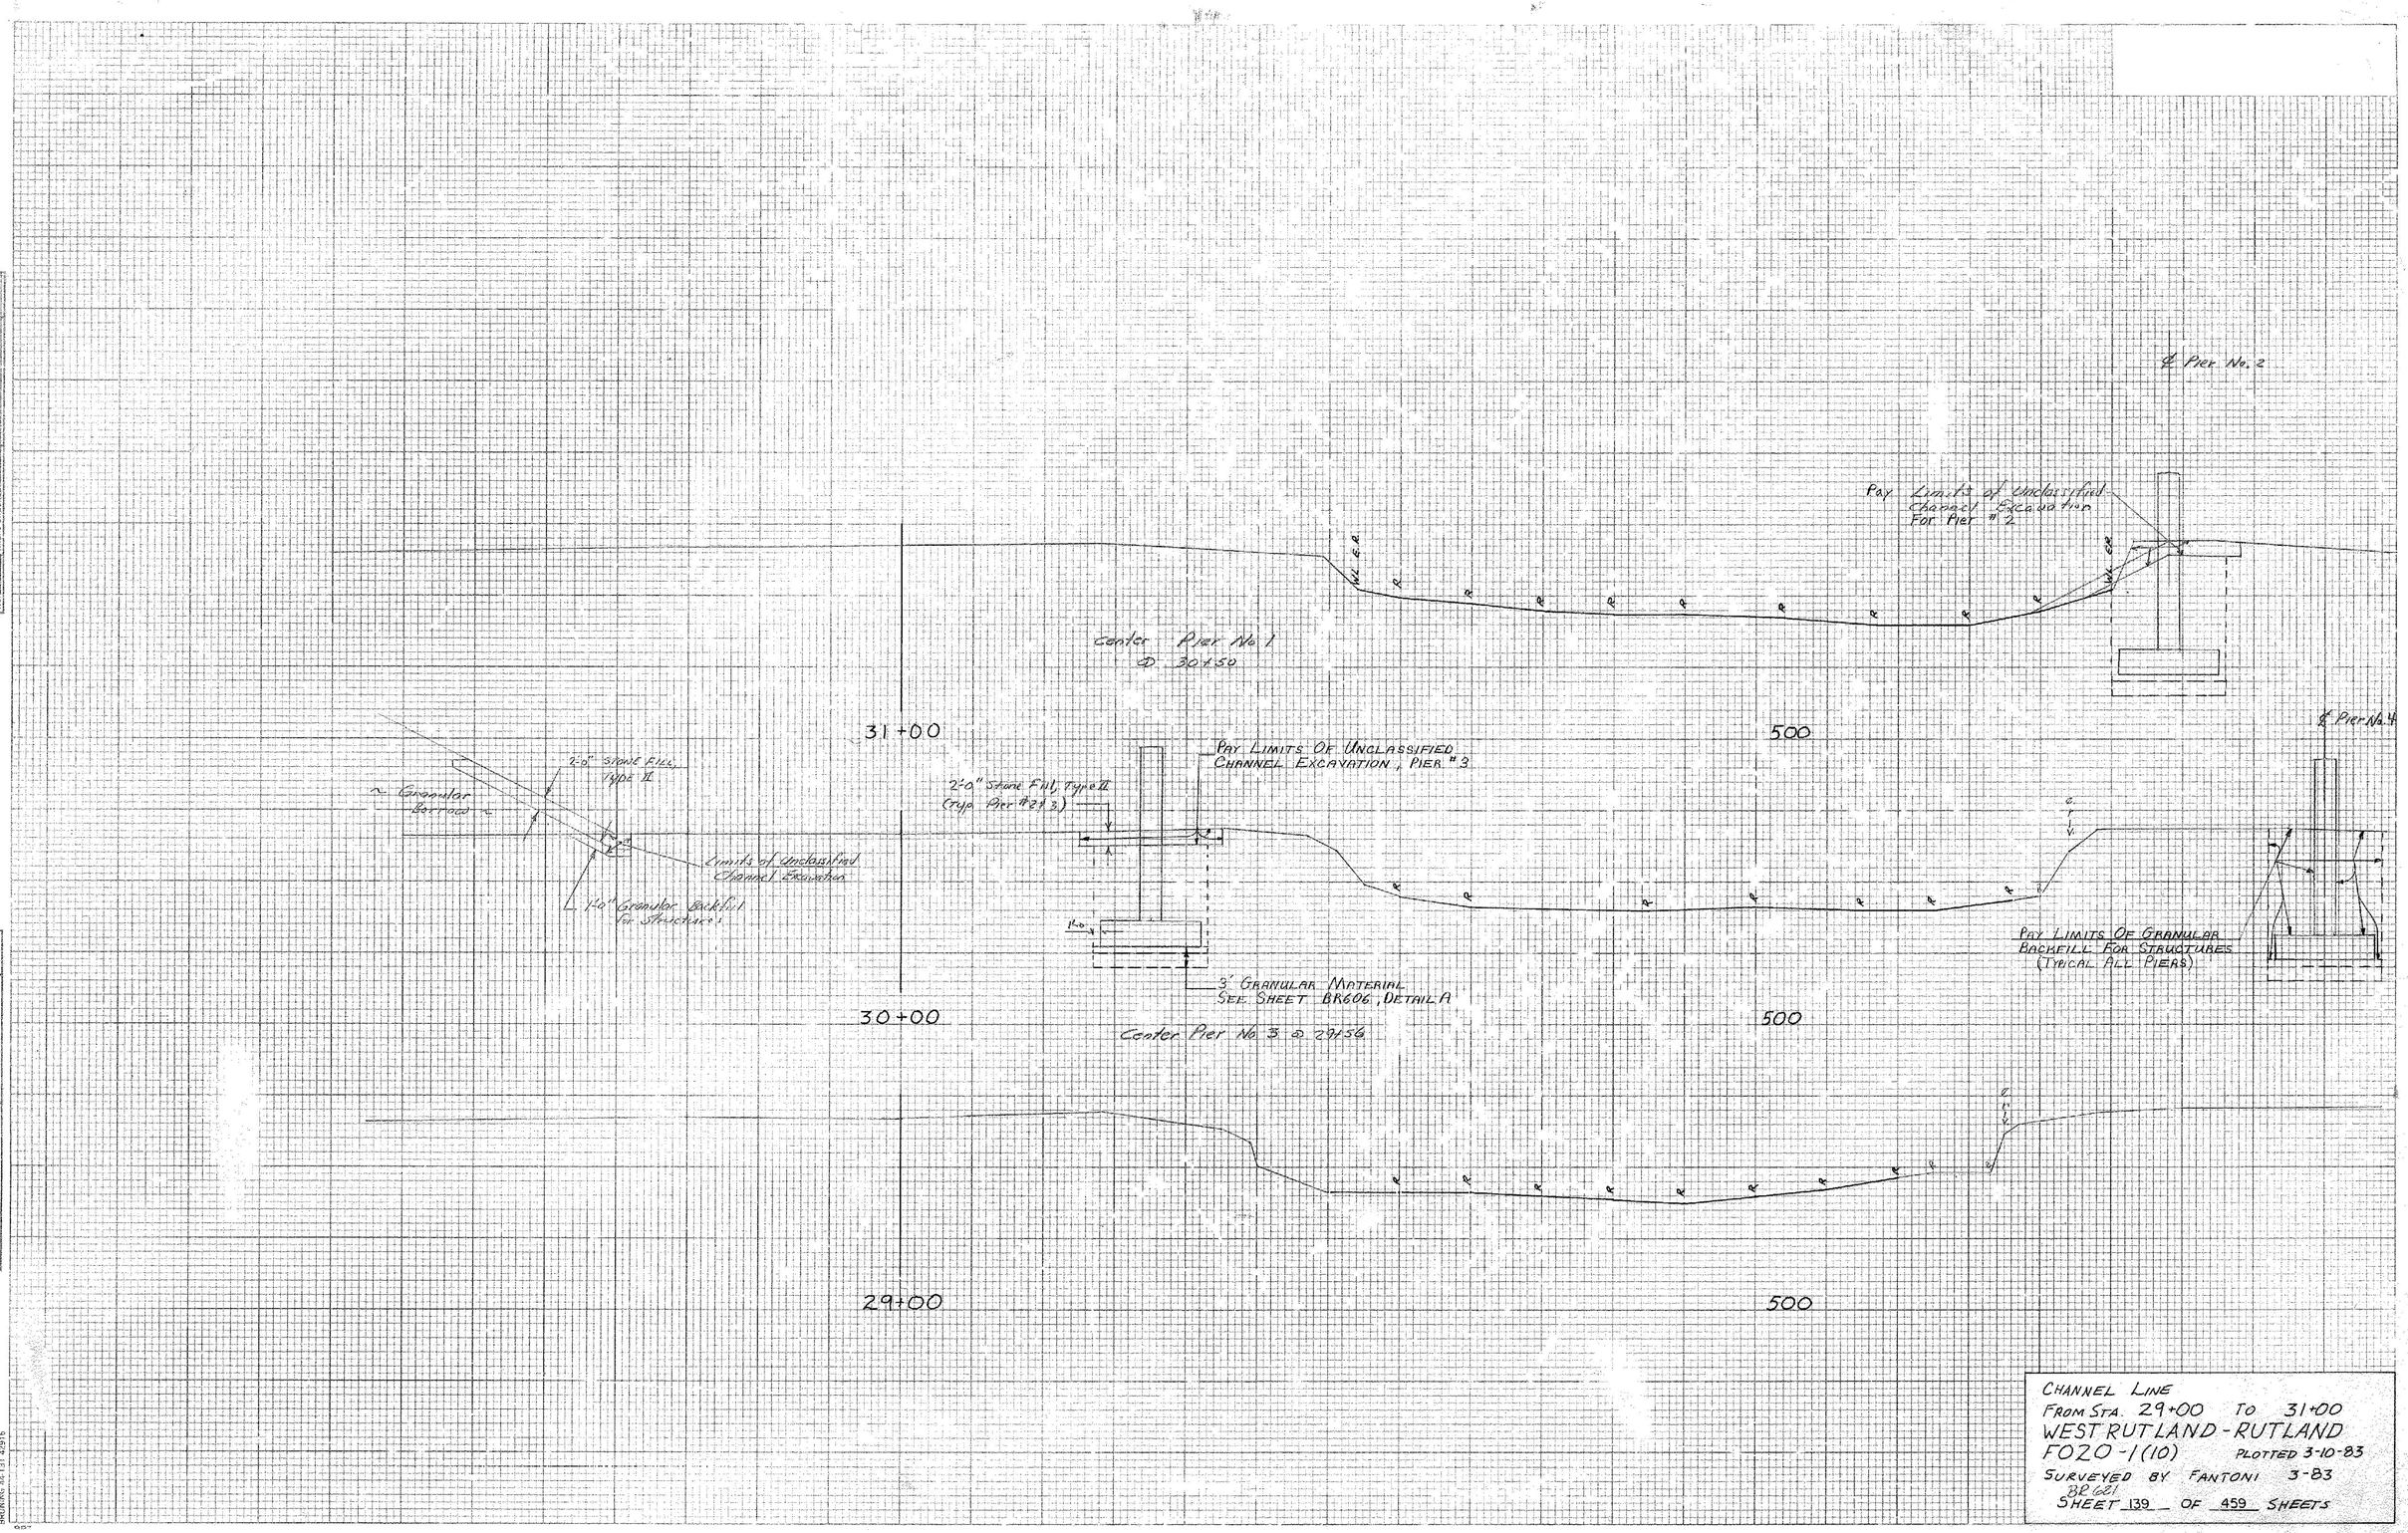


CHANNEL LINE
FROM STA. 29+00 TO 31+00
WEST RUTLAND - RUTLAND
F020-1(10) PLOTTED 3-10-83
SURVEYED BY FANTONI 3-83
BR 621
SHEET 139 OF 459 SHEETS

SURVEY
NOTE BOOK
NO.
SURVEYED
PLOTTED
TEMPLATE
AREA
AREAS CHECKED
BY
DATE

ORIGINAL SURVEY
NOTE BOOK
NO.
SURVEYED
PLOTTED
TEMPLATE
AREA
AREAS CHECKED
BY FANTONI S. BARCOM
DATE 3/83

BRUNING 46 131 42916