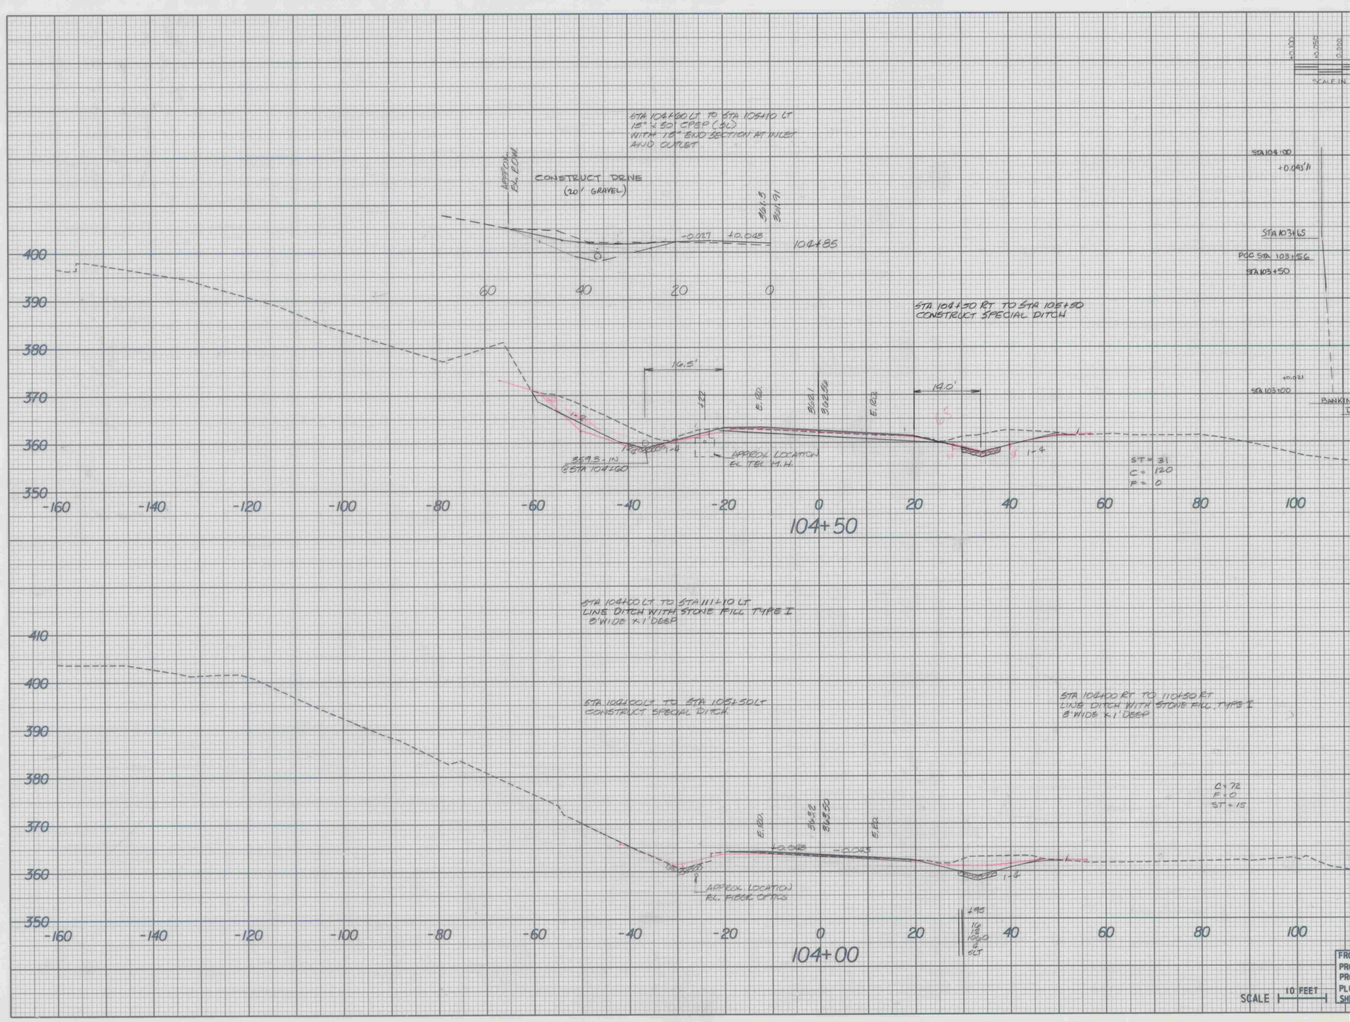
STA 104+00 LT TO STA 109+10 LT
18" X 50' CPEP (SL)
WITH 18" END SECTION AT INLET
AND OUTLET
CONSTRUCT DRIVE
(20' GRAVEL)
-0.027
+0.048
104+85
STA 109+50 RT TO STA 109+50
CONSTRUCT SPECIAL DITCH
16.5'
14.0'
APPROX. LOCATION
EL. TEL. M.H.
ST = 31
C = 120
F = 0
104+50
STA 104+00 LT TO STA 111+10 LT
LINE DITCH WITH STONE FILL TYPE I
8' WIDE X 1' DEEP
STA 104+00 LT TO STA 105+50 LT
CONSTRUCT SPECIAL DITCH
STA 104+00 RT TO 110+50 RT
LINE DITCH WITH STONE FILL, TYPE I
8' WIDE X 1' DEEP
C = 72
F = 0
ST = 15
APPROX. LOCATION
EL. FIBER OPTICS
104+00
SCALE
10 FEET