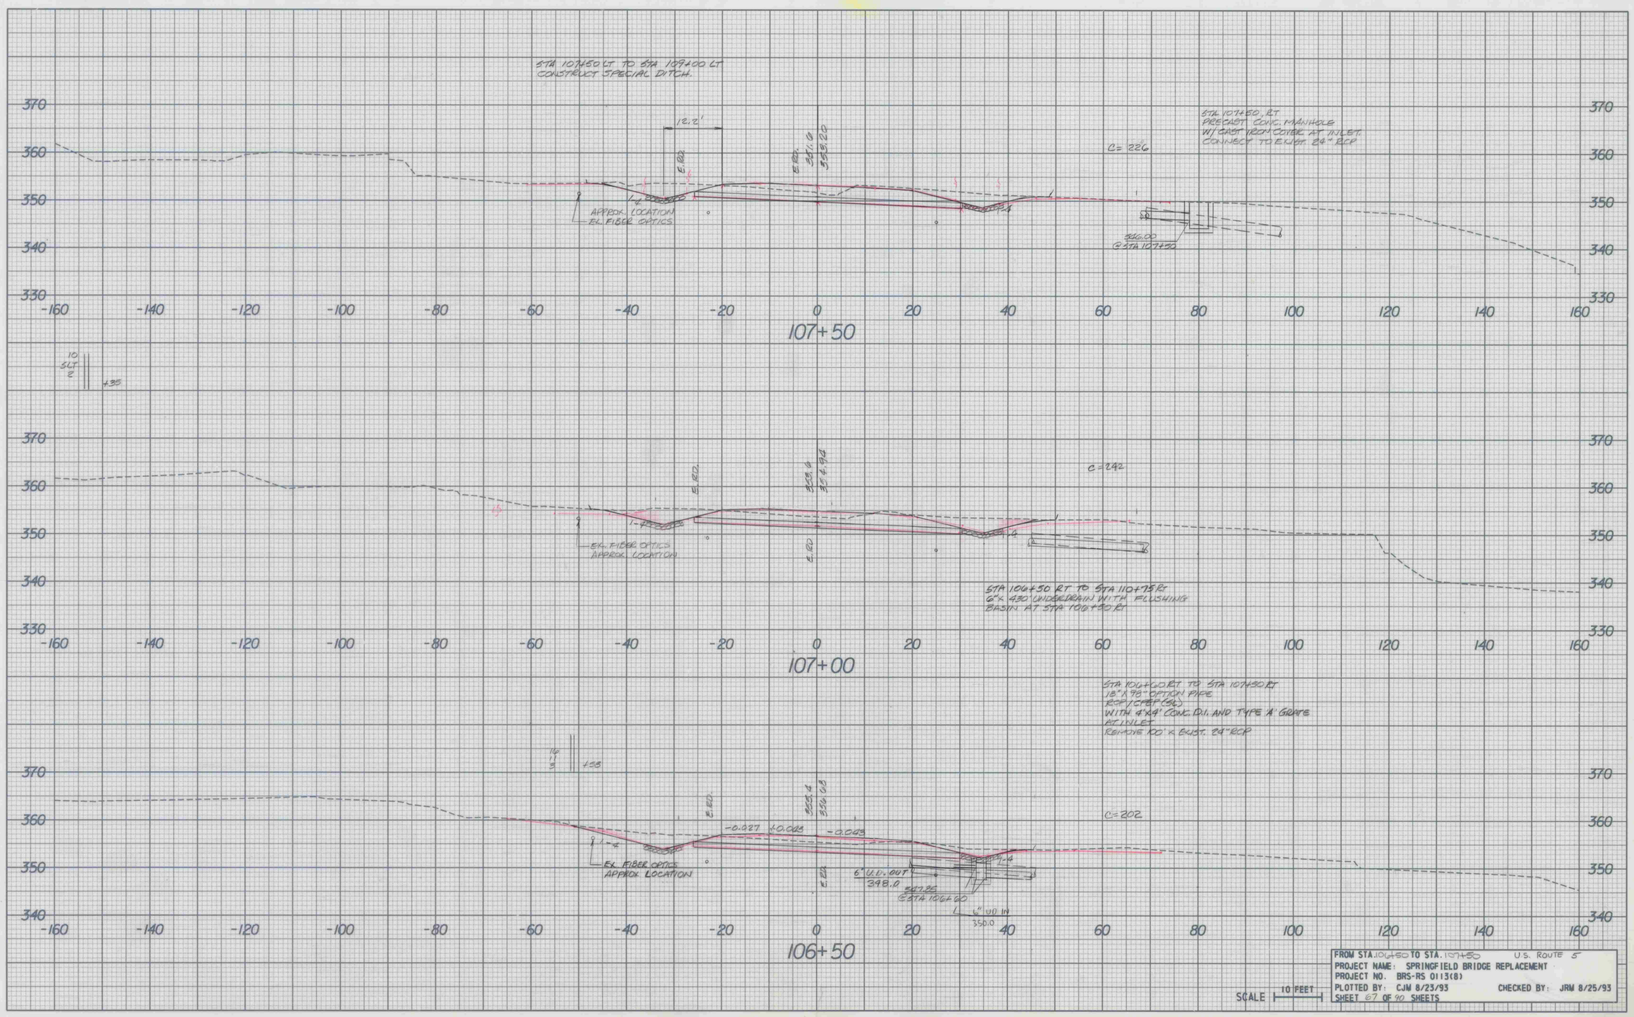
STA 107+50 LT TO STA 107+00 LT
CONSTRUCT SPECIAL DITCH.
12.2'
E.P.D.
APPROX. LOCATION
EX. FIBER OPTICS
C= 226
STA 107+50 RT
PRECAST CONC. MANHOLE
W/ CAST IRON COVER AT INLET.
CONNECT TO EXIST. 24" RCP.
326.00
@ STA 107+50
107+50
EX. FIBER OPTICS
APPROX. LOCATION
C=242
STA 106+50 RT TO STA 110+75 RT
6" X 30' UNDERDRAIN WITH FLUSHING
BASIN AT STA 110+75 RT.
107+00
STA 106+50 RT TO STA 107+50 RT
18" X 95' OTTON PIPE
RCP / CMP (SL)
WITH 8'X4' CONC. D.I. AND TYPE A GRATE
AT INLET
REMOVE 100' X EXIST. 24" RCP
C=202
-0.027
+0.005
-0.005
EX. FIBER OPTICS
APPROX. LOCATION
6" U.D. OUT
348.0
@ STA 106+50
350.0
106+50
FROM STA. 106+50 TO STA. 107+50
U.S. ROUTE 5
PROJECT NAME: SPRINGFIELD BRIDGE REPLACEMENT
PROJECT NO. BRS-RS 0113(8)
PLOTTED BY: CJN 8/23/93
CHECKED BY: JRM 8/25/93
SHEET 67 OF 90 SHEETS
SCALE 10 FEET