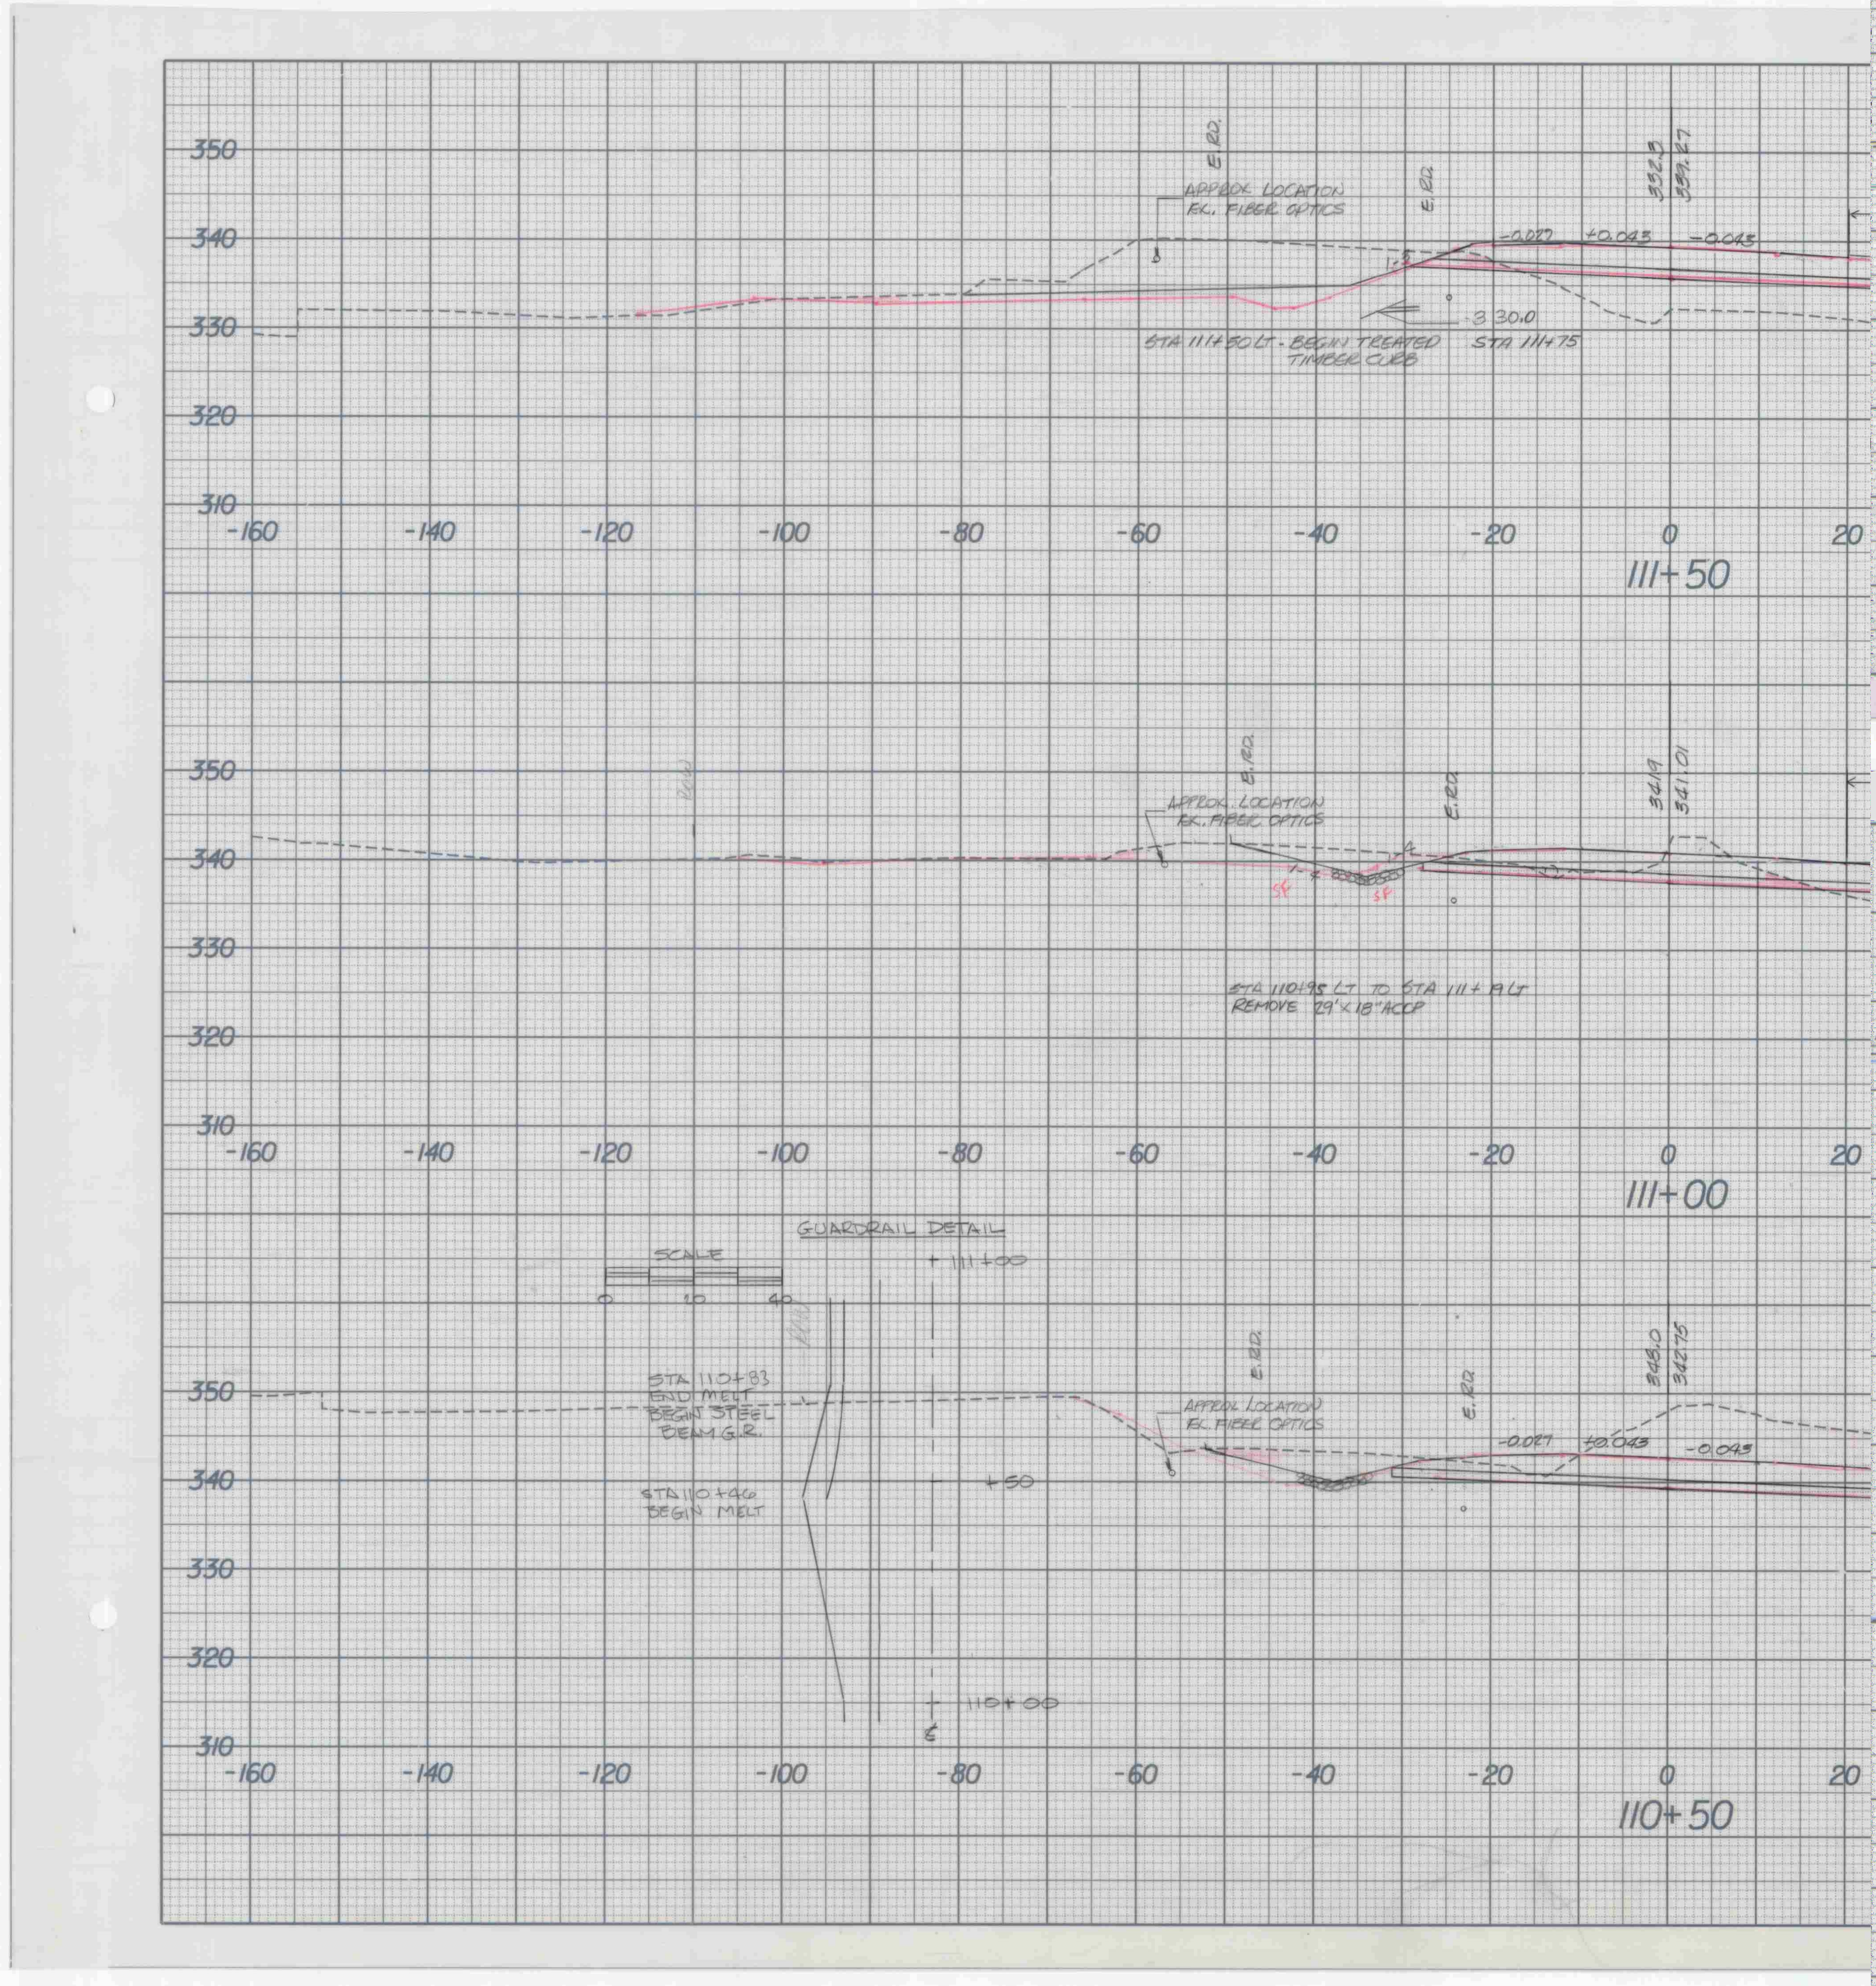
350
340
330
320
310
-160
-140
-120
-100
-80
-60
-40
-20
0
20
E. RD.
APPROX. LOCATION
EX. FIBER OPTICS
E. RD.
332.3
339.27
-0.027
+0.043
-0.043
1:5
3 30.0
STA 111+50 LT - BEGIN TREATED
TIMBER CURB
STA 111+75
111+50
E. RD.
APPROX. LOCATION
EX. FIBER OPTICS
E. RD.
341.9
341.01
1:4
SF
SF
STA 110+95 LT TO STA 111+19 LT
REMOVE 29' x 18" ACCP
111+00
GUARDRAIL DETAIL
SCALE
0
20
40
111+00
STA 110+83
END MELT
BEGIN STEEL
BEAM G.R.
+50
STA 110+46
BEGIN MELT
110+00
E. RD.
APPROX. LOCATION
EX. FIBER OPTICS
E. RD.
346.0
342.75
-0.027
+0.043
-0.043
110+50

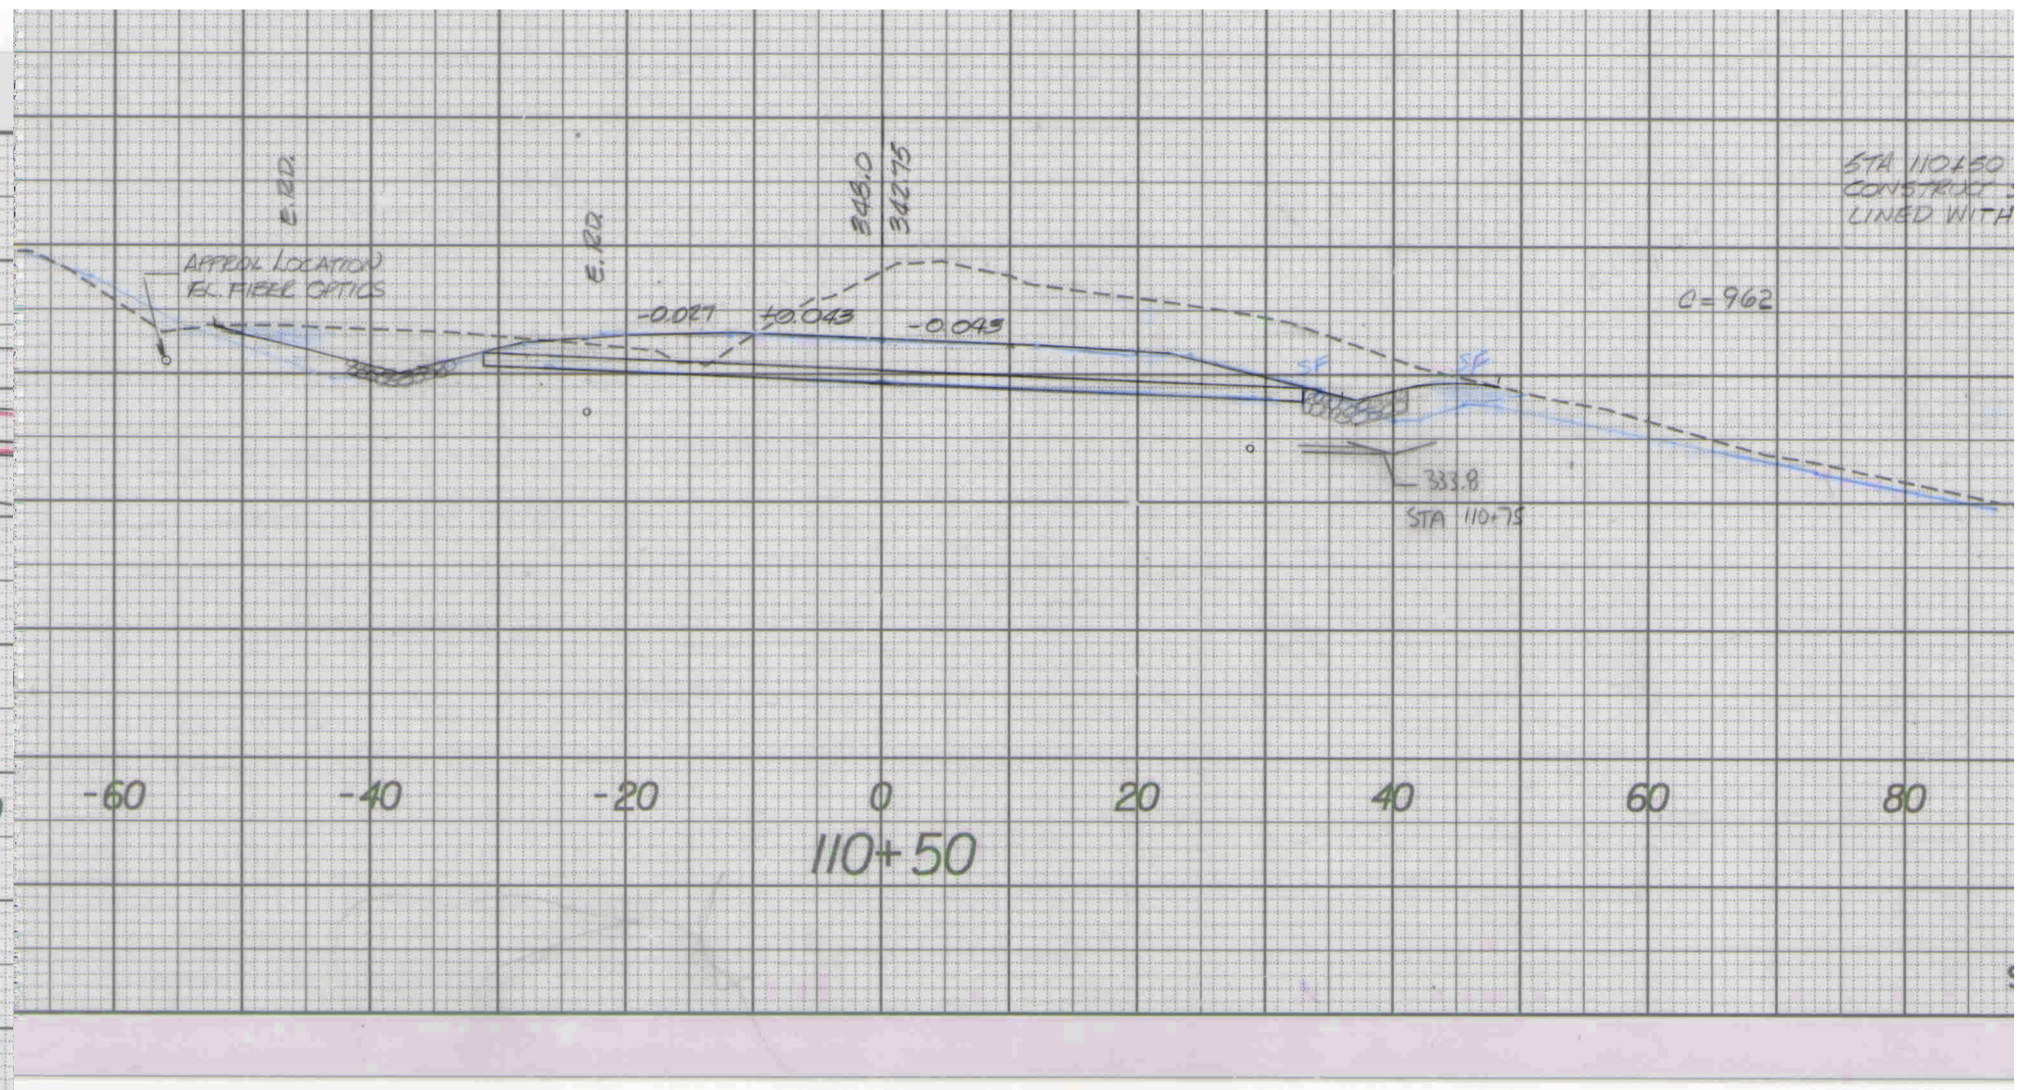
E. RD.
APPROX. LOCATION
EX. FIBER OPTICS
E. RD.
346.0
342.75
-0.027
+0.043
-0.043
SF
SF
333.8
STA 110+75
C = 962
STA 110+50
CONSTRUCT
LINED WITH
-60
-40
-20
0
20
40
60
80
110+50

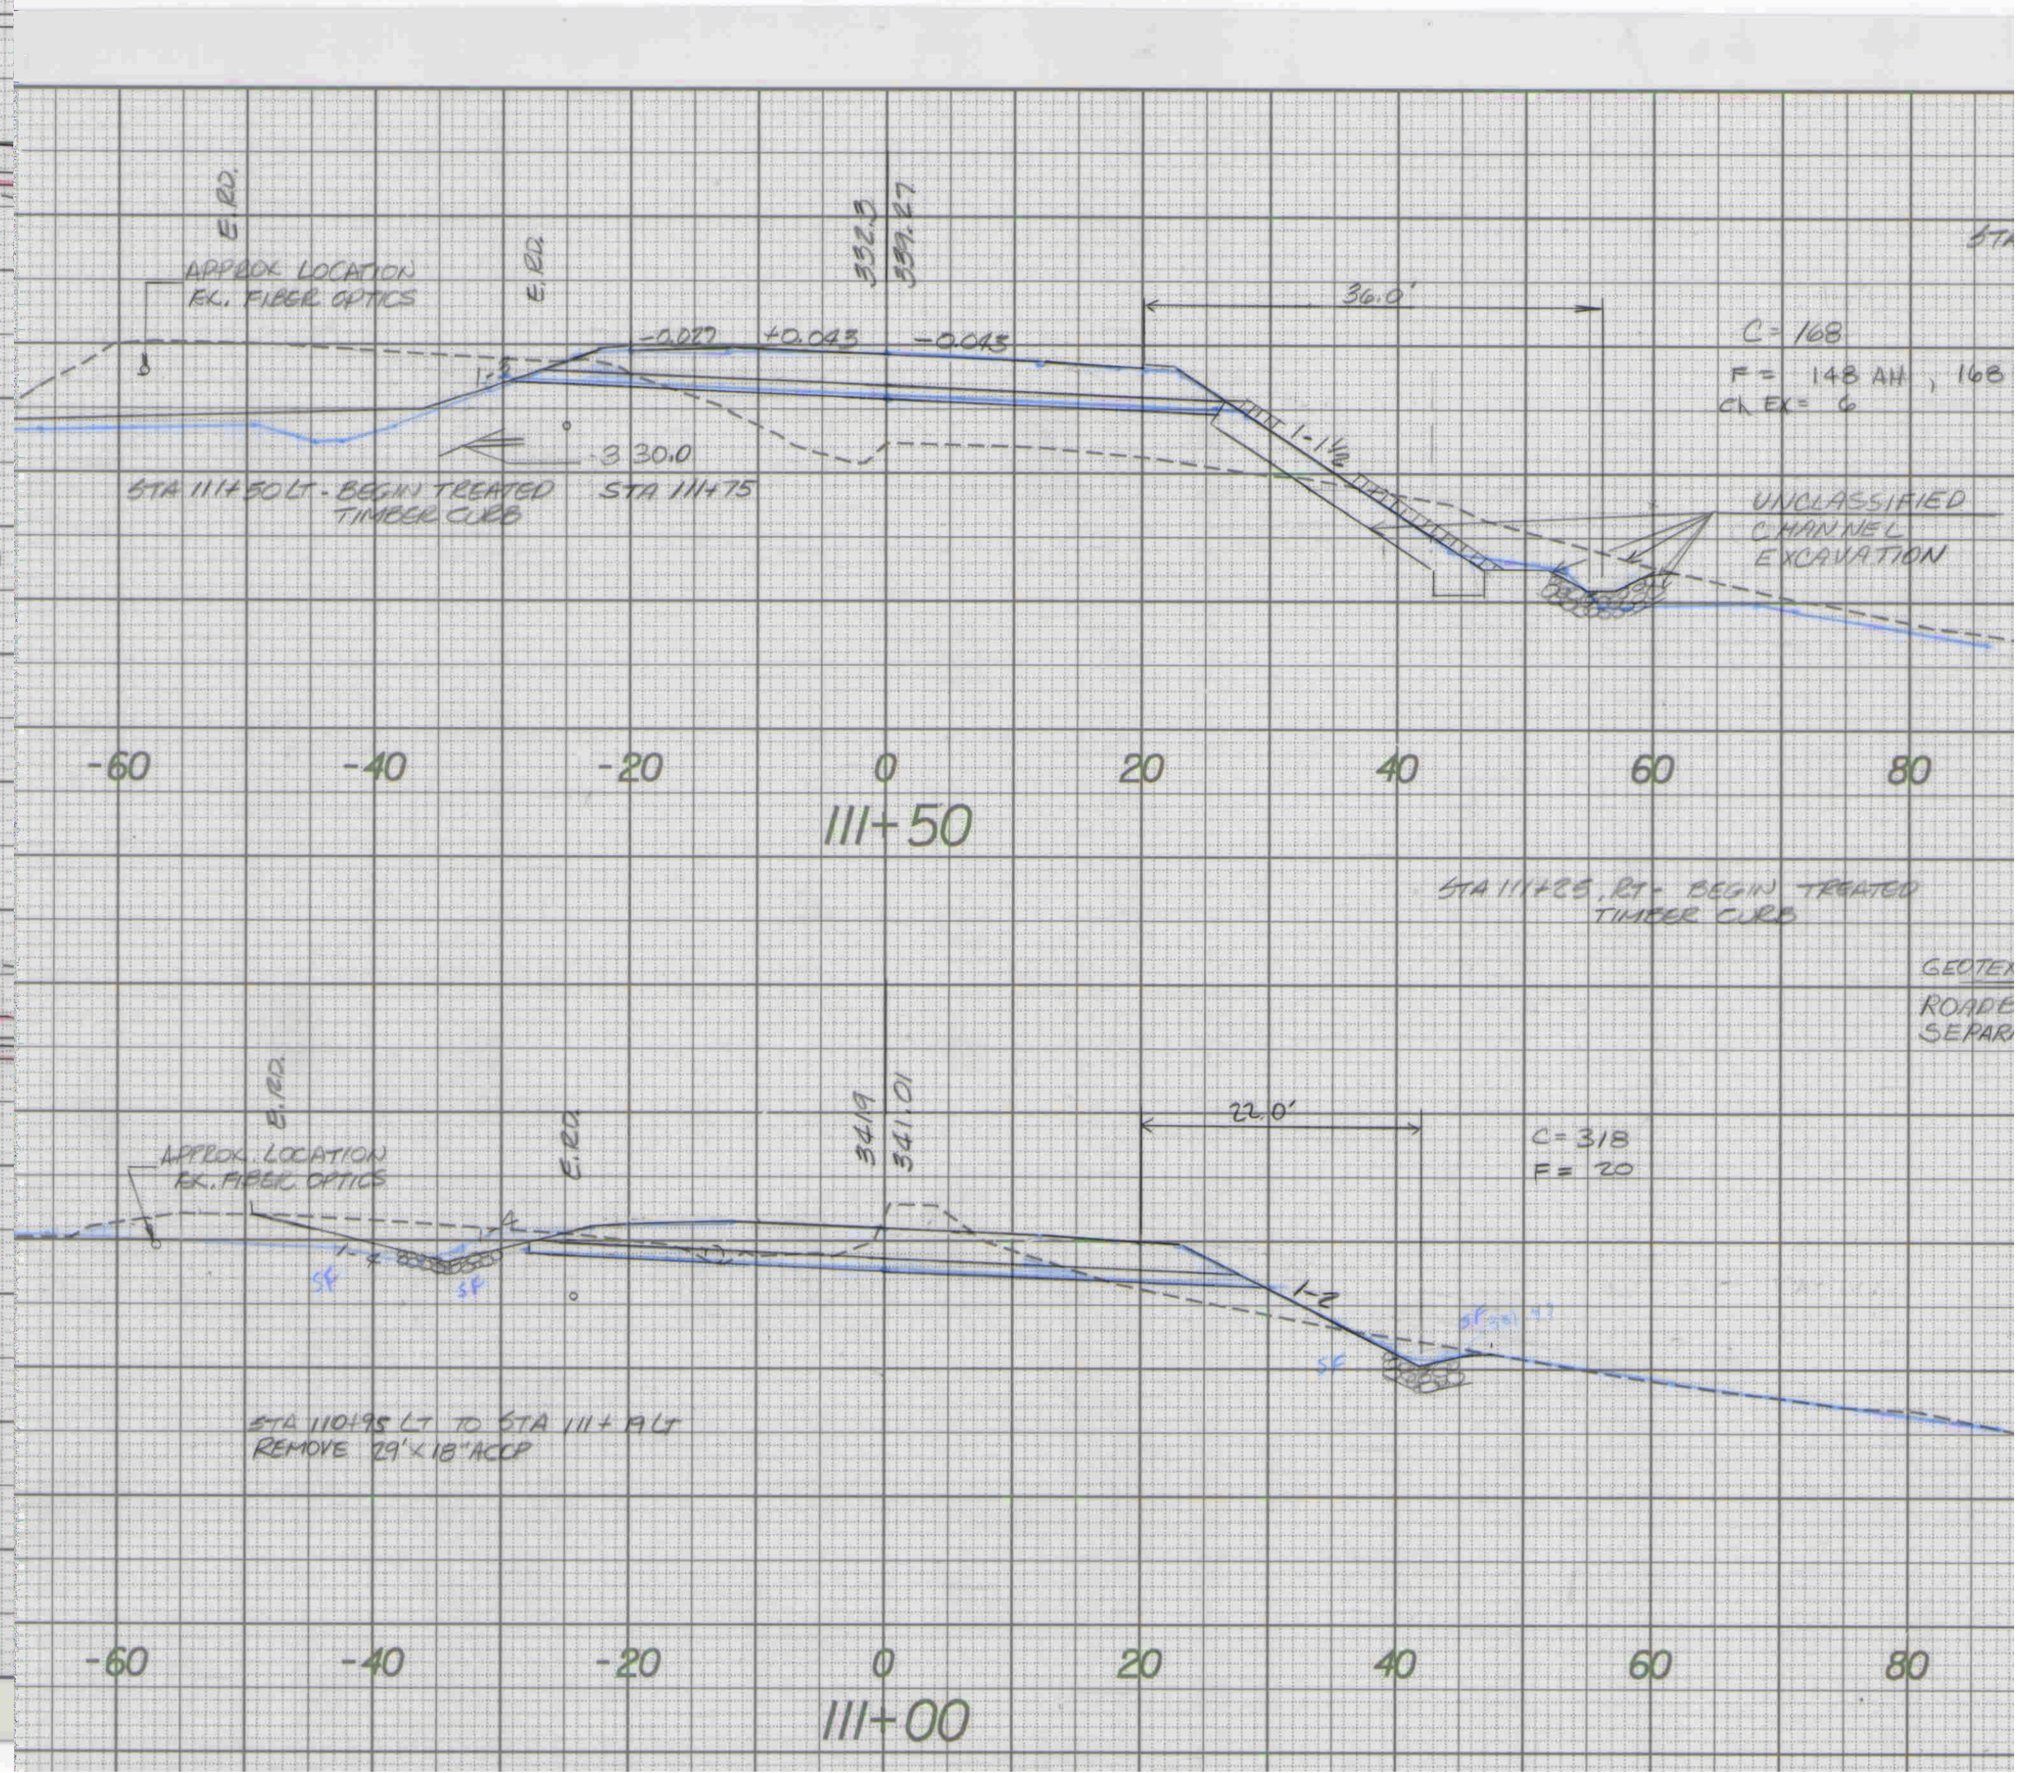
E. RD.
APPROX. LOCATION
EX. FIBER OPTICS
E. RD.
332.3
339.27
-0.027
+0.043
-0.043
1:5
36.0'
C = 168
F = 148 AH , 168
Ch EX = 6
1-1½
3 30.0
STA 111+50 LT - BEGIN TREATED
TIMBER CURB
STA 111+75
UNCLASSIFIED
CHANNEL
EXCAVATION
-60
-40
-20
0
20
40
60
80
111+50
STA 111+85, RT - BEGIN TREATED
TIMBER CURB
GEOTEX
ROADE
SEPAR
E. RD.
APPROX. LOCATION
EX. FIBER OPTICS
E. RD.
341.9
341.01
22.0'
C = 318
F = 20
1:4
1-2
SF
SF
SF
STA 110+95 LT TO STA 111+19 LT
REMOVE 29' x 18" ACCP
-60
-40
-20
0
20
40
60
80
111+00