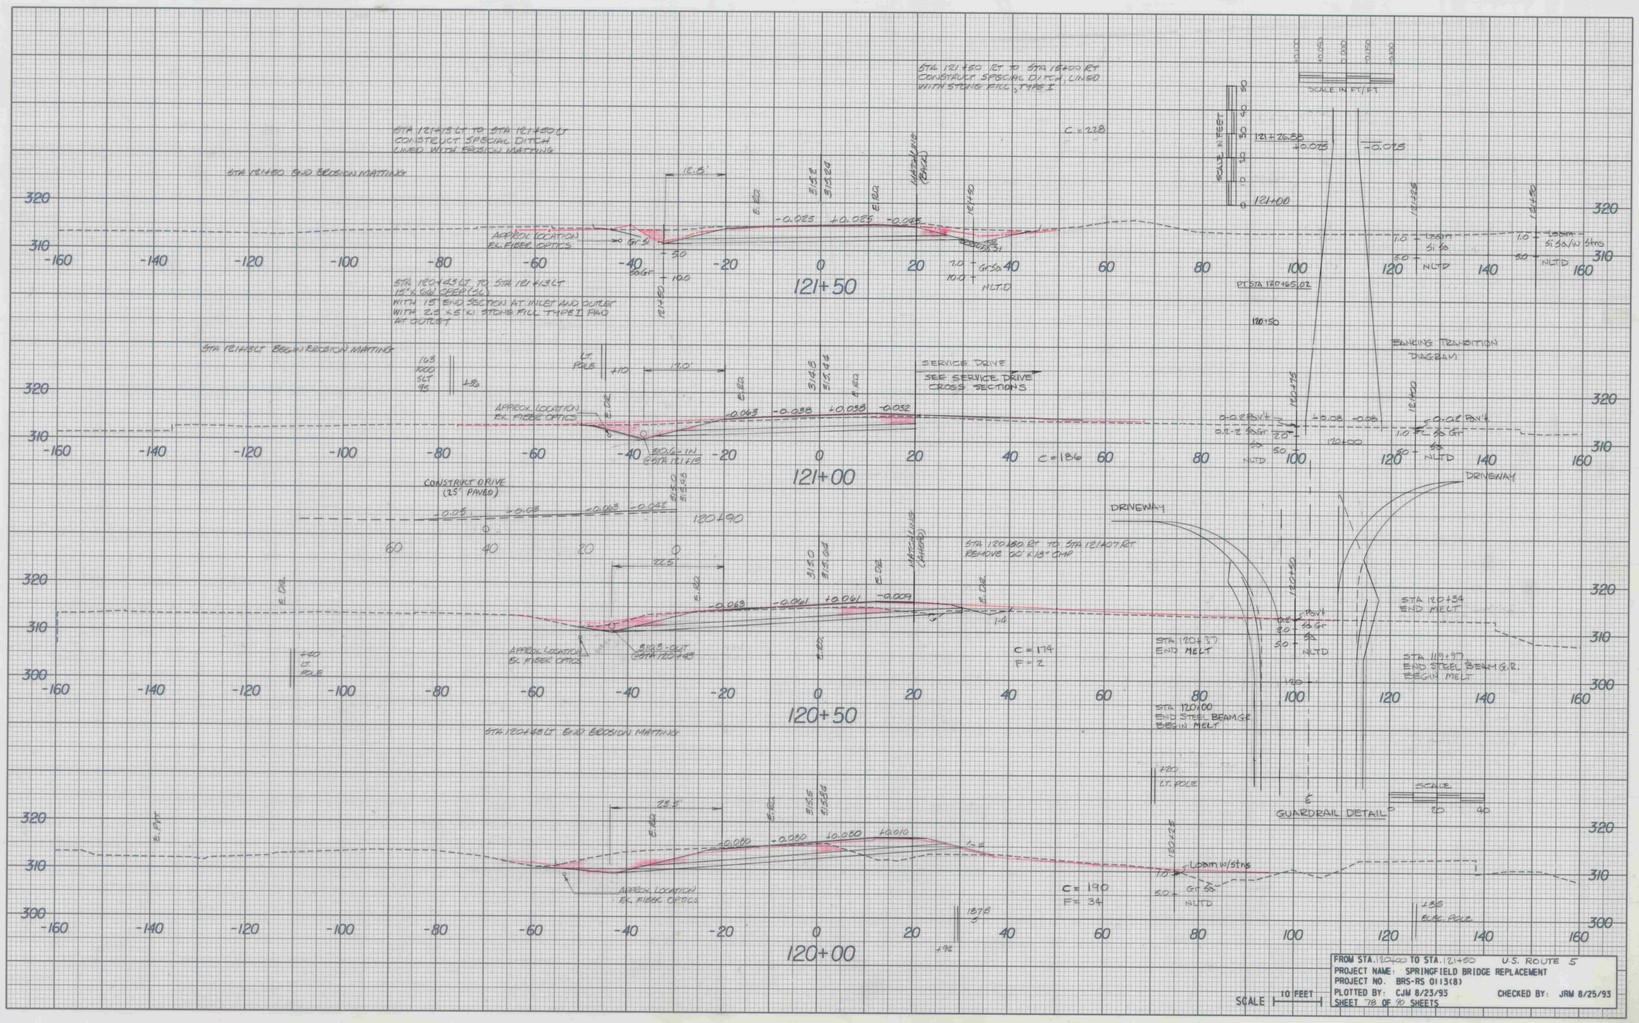

FROM STA. 120+00 TO STA. 121+50 U.S. ROUTE 5
PROJECT NAME: SPRINGFIELD BRIDGE REPLACEMENT
PROJECT NO. BRS-RS 0113(8)
PLOTTED BY: CJM 8/23/93 CHECKED BY: JRM 8/25/93
SHEET 78 OF 90 SHEETS