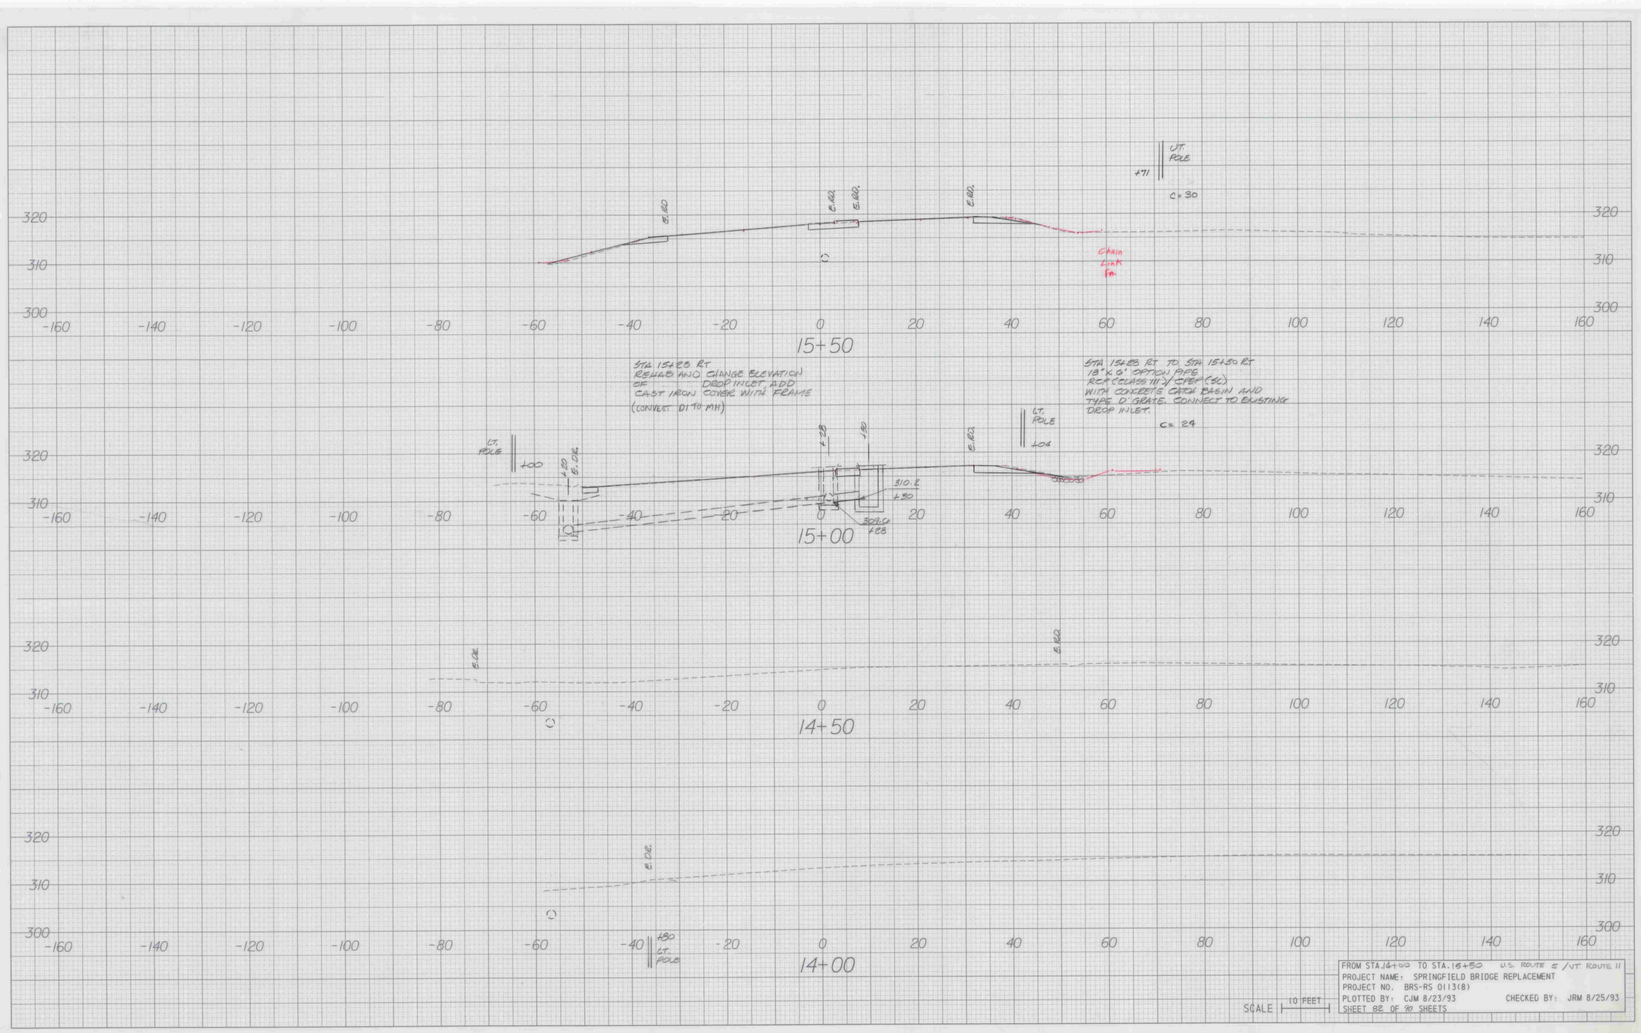



FROM STA.14+00 TO STA.16+50 U.S. ROUTE 5 / VT ROUTE 11
PROJECT NAME: SPRINGFIELD BRIDGE REPLACEMENT
PROJECT NO. BRS-RS 0113(8)
PLOTTED BY: CJM 8/23/93 CHECKED BY: JRM 8/25/93
SHEET 82 OF 90 SHEETS

SCALE 10 FEET