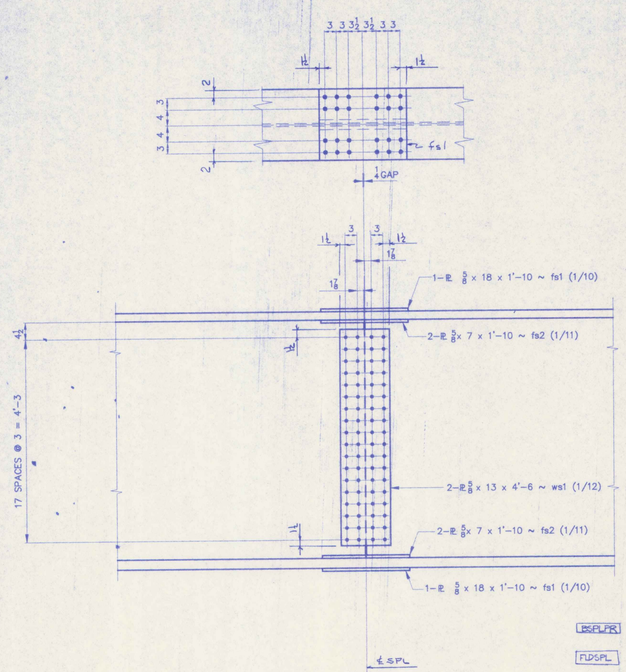

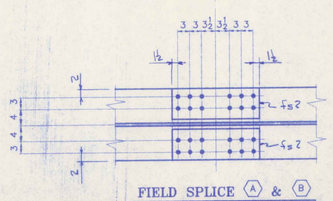

FIELD SPLICE Ⓐ & Ⓑ

(14 REQUIRED)

PAINT SYSTEM SHALL BE AMERON

PRIMER: 7HS GREEN 3-4 MILS

INTERMEDIATE: 385 BR-4 SAND 4-6 MILS

TOP: 450HS DARK BROWN 2-3 MILS (695-2

NP3 DENOTES SURFACES WITH NO PAINT WITH 3" OF OPEN HOLES.

NP DENOTES NO PAINT

LP DENOTES LIGHT RUST PREVENTIVE COAT ONLY (.5 – 1.5 MILS)

NOTES

1. ALL HOLE
2. ALL MATE

☑ No Exception Taken ☐ Make Corrections Noted
☐ Revise and Resubmit ☐ Not Acceptable

Reviewed only for general conformance with the design concept of the project and general compliance with the information given in the contract documents. The contractor is responsible for confirming and correlating all quantities and dimensions and performing his work in a satisfactory manner.

McFARLAND-JOHNSON ENGINEERS, INC.

Date 12/12/96 BY SAB

ITEM NO.	506.55
TITLE:	
APPROVED:	
PRINT DIST.	
5	10-19-96
ORIG	12-3-96
5	11-18-96
5	12-3-96
CHECKED	10/96
DRAWN	9/96