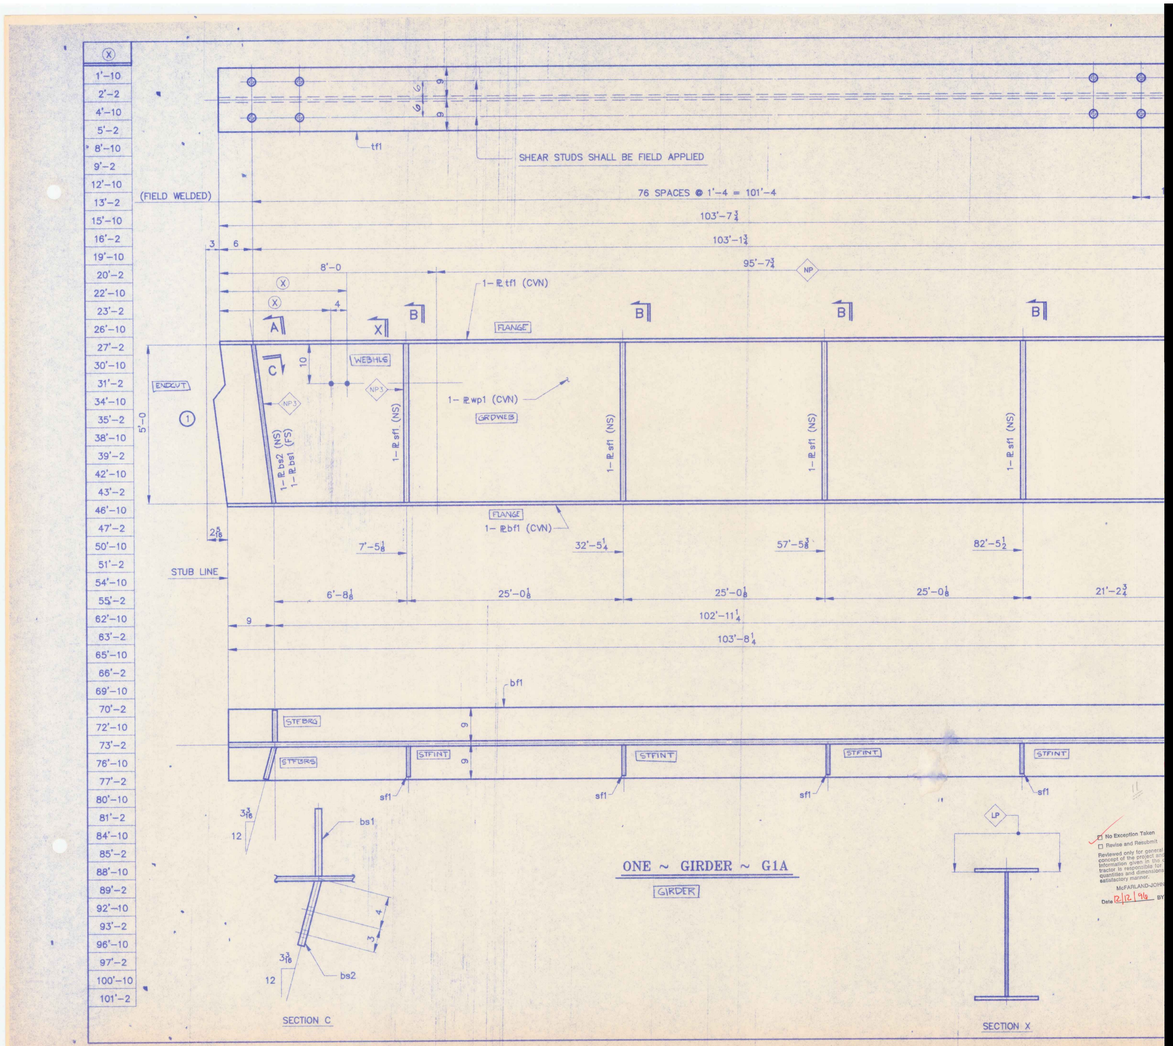

(X)
1'-10
2'-2
4'-10
5'-2
8'-10
9'-2
12'-10
13'-2
15'-10
16'-2
19'-10
20'-2
22'-10
23'-2
26'-10
27'-2
30'-10
31'-2
34'-10
35'-2
38'-10
39'-2
42'-10
43'-2
46'-10
47'-2
50'-10
51'-2
54'-10
55'-2
62'-10
63'-2
65'-10
66'-2
69'-10
70'-2
72'-10
73'-2
76'-10
77'-2
80'-10
81'-2
84'-10
85'-2
88'-10
89'-2
92'-10
93'-2
96'-10
97'-2
100'-10
101'-2
tf1
SHEAR STUDS SHALL BE FIELD APPLIED
(FIELD WELDED)
76 SPACES @ 1'-4 = 101'-4
103'-7 3/4
103'-1 1/2
95'-7 3/4
NP
8'-0
4
1-PL tf1 (CVN)
FLANGE
WEBHLG
ENDCUT
1-PL wp1 (CVN)
GRDWEB
1-PL bsf1 (SS)
1-PL bsf1 (NS)
1-PL sf1 (NS)
FLANGE
1-PL bf1 (CVN)
32'-5 1/4
57'-5 3/8
82'-5 1/2
7'-5 1/8
STUB LINE
6'-8 1/8
25'-0 1/8
25'-0 1/8
25'-0 1/8
21'-2 3/4
102'-11 1/4
103'-8 1/4
bf1
STFBRG
STFDRG
STFINT
sf1
bs1
bs2
SECTION C
ONE ~ GIRDER ~ G1A
GIRDER
LP
SECTION X
No Exception Taken
Revise and Resubmit
Reviewed only for general conformance of the project information given in the contract documents. Responsible for quantities and dimensions in a satisfactory manner.
McFARLAND-JOHNSTON
Date 12/2/96 BY