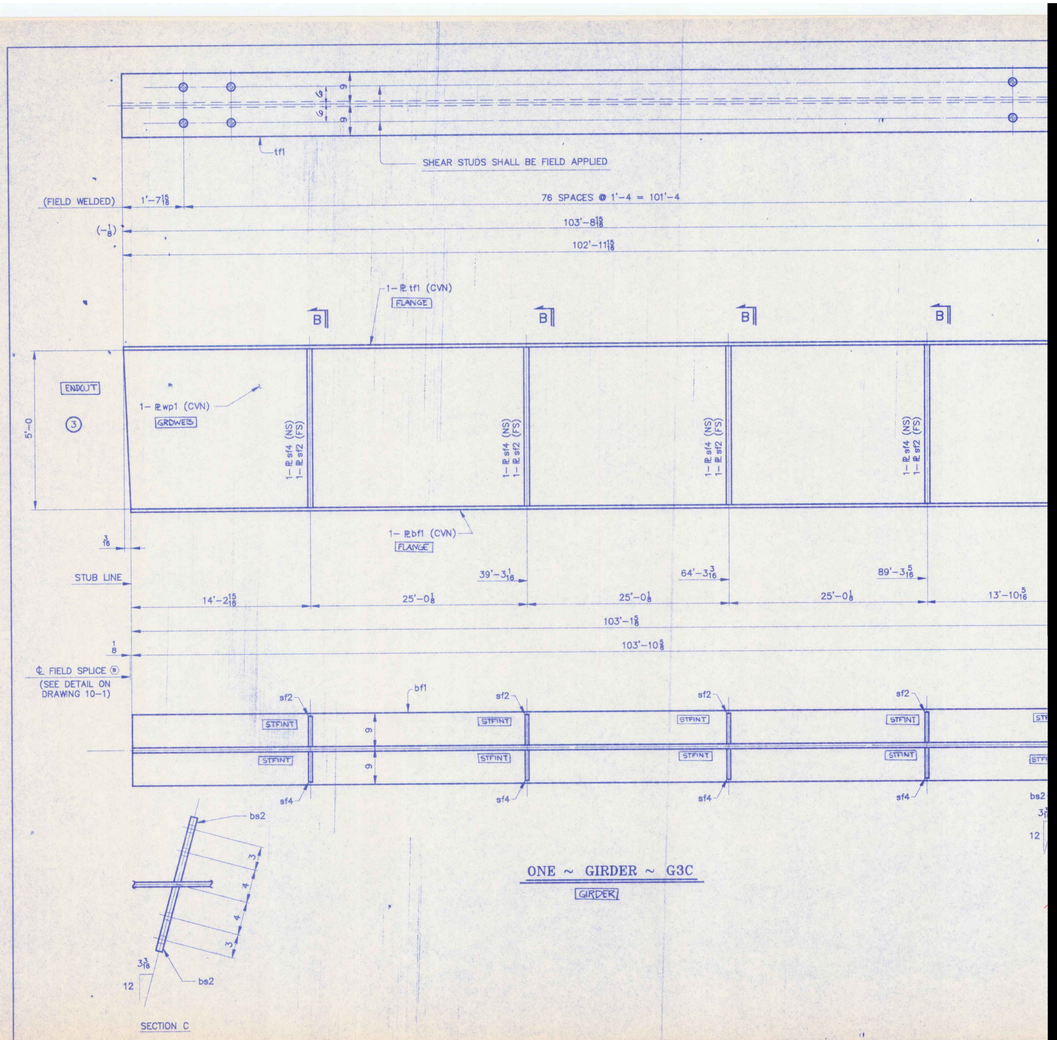

ONE ~ GIRDER ~ G3C

GIRDER