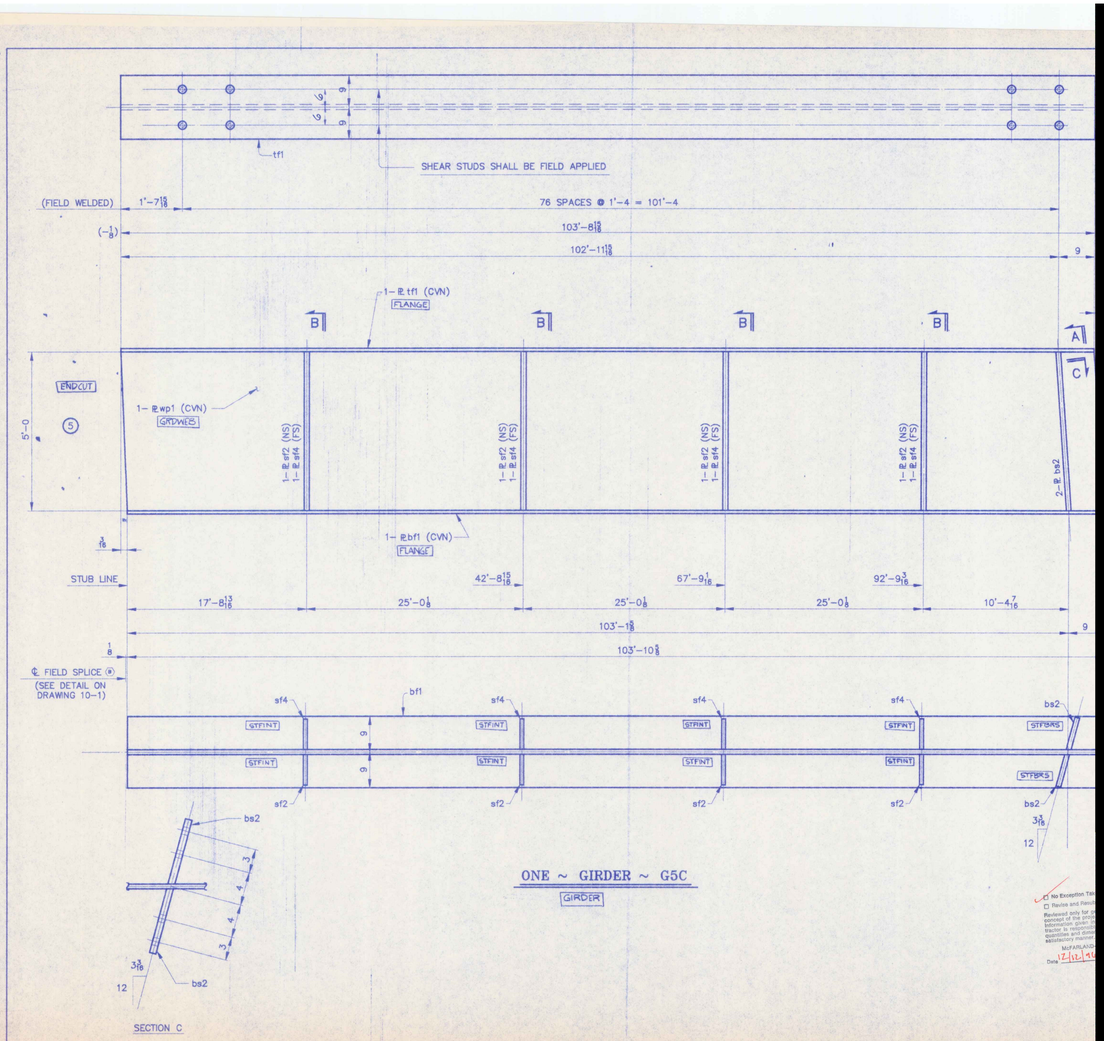

ONE ~ GIRDER ~ G5C

GIRDER

No Exception Tak

Revise and Resub

Reviewed only for g
concept of the proje
Review of shop
drawings to indicate
exceptions and deviat
satisfactory manner

MUFAN/LAKE

Date 12/11/96