WORK ORDER NO.	DRAWING NO.	REV.
15713	W1	

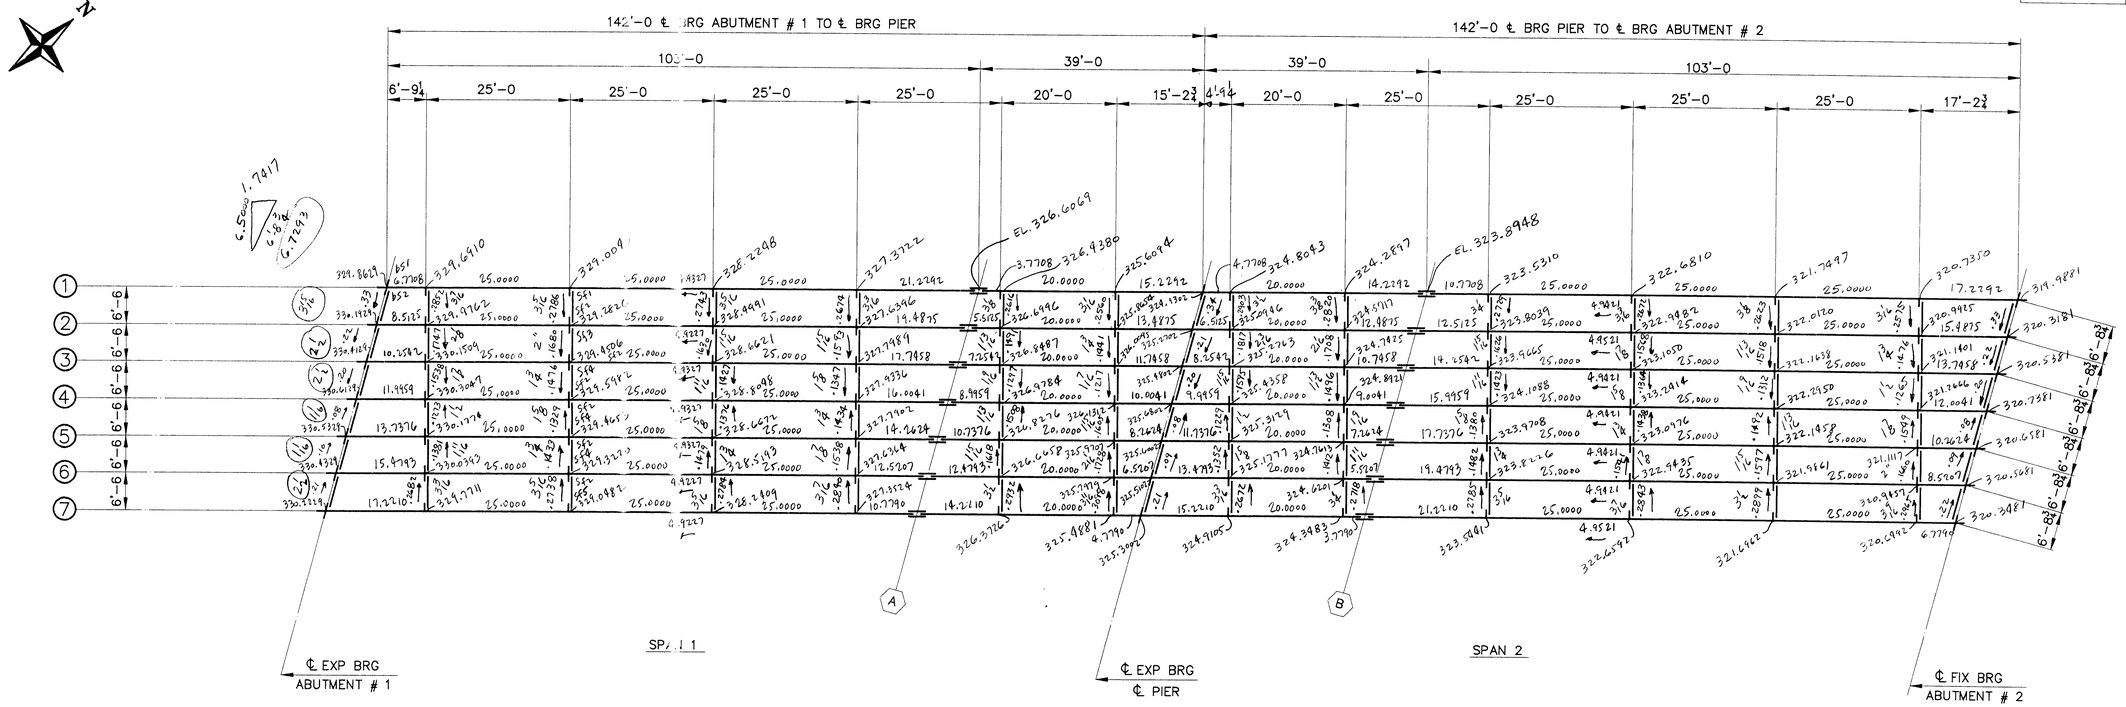

BRIDGE CALCULATIONS

ITEM NO. 506.55	BRIDGE NO. 44	PROJ. NO. BRS-RS 0113 (8)	
TITLE: BRIDGE CALCULATIONS			
APPROVED: NR		National Eastern Corporation, Plainville, Connecticut	
PRINT DIST.			
	NIR	APPR.	
ORIG	NIR	FAB.	
ORIG	4-3-97	VAT	
JOB: U.S. ROUTE 5 OVER BLACK RIVER, SPRINGFIELD, VERMONT			
CUSTOMER: WINTERSETT, INC.			
DESIGNER: VERMONT AGENCY OF TRANSPORTATION			
CHECKED	9/96	JH	WORK ORDER NO. 15713 / DRAWING NO. W1 / REV.
DRAWN	8/96	CSD	