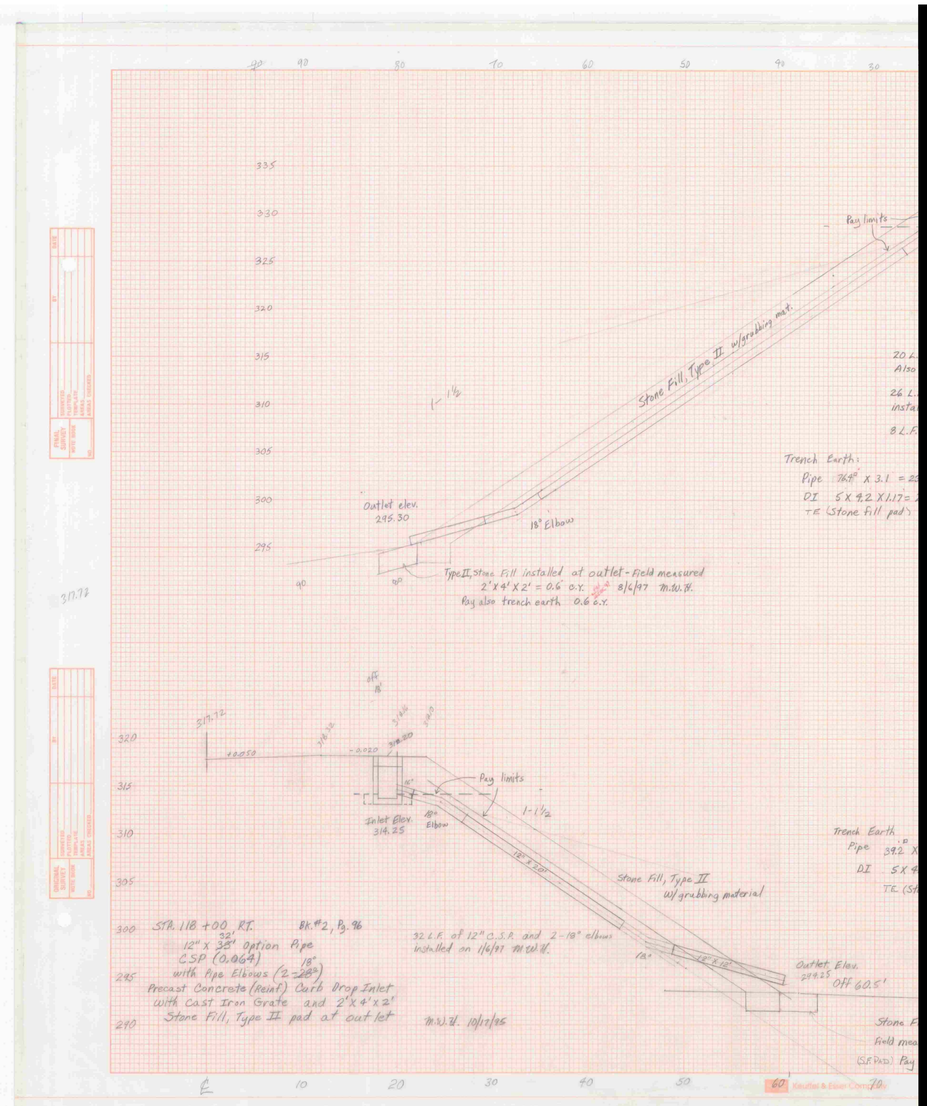

335
330
325
320
315
310
305
300
295
290
Pay limits
Stone Fill, Type II w/grubbing mat.
1-1½
Outlet elev. 295.30
18° Elbow
Type II Stone Fill installed at outlet - Field measured
2'x4'x2' = 0.6 c.y. 8/6/97 M.W.H.
Pay also trench earth 0.6 c.y.
Trench Earth:
Pipe 76.4 x 3.1 =
DI 5 x 9.2 x 1.17 =
TE (Stone fill pad)
Inlet Elev. 314.25
Stone Fill, Type II
w/grubbing material
Sta. 118+00 RT Bk. #2, Pg. 96
12" x 32' Option Pipe
CSP (0.064) 18"
with Pipe Elbows (2-28°)
Precast Concrete (Reinf.) Curb Drop Inlet
with Cast Iron Grate and 2'x4'x2'
Stone Fill, Type II pad at outlet
32 L.F. of 12" C.S.P. and 2-18° elbows
installed on 11/6/97 M.W.H.
M.W.H. 10/27/98
Outlet Elev. 289.25
Off 60.5'
Trench Earth
Pipe 39.2 x
DI 5 x
TE (St
Stone F
Field mea
(SLP PAD) Pay
0
10
20
30
40
50
60
70