 

Trench Earth
123.0 x 3.6 = 442.8 M³ ÷ 27 = 16.4 cyk
Bored a hole into the existing D.I.
for the 18" O.S.P. outlet 6/16/87 M.W.H.