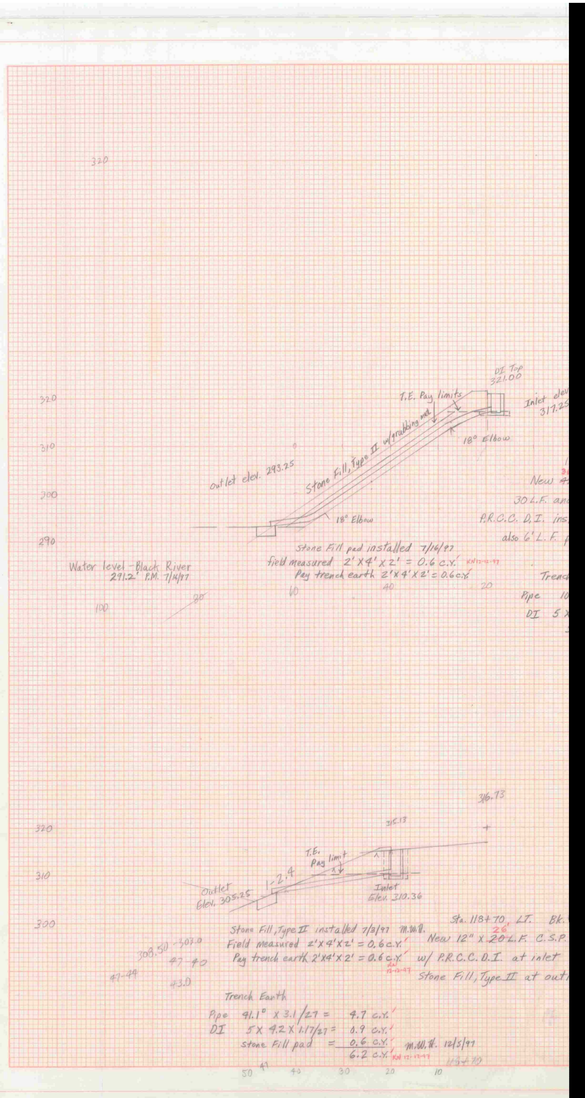
320
310
300
290
Water level - Black River
291.2' E.M. 7/14/97
100
90
80
10
40
20
Stone Fill pad installed 7/14/97
field measured 2'X4'X2' = 0.6 c.y.
Pay trench earth 2'X4'X2' = 0.6 c.y.
outlet elev. 293.75
Stone Fill, Type II w/ trashrack
18° Elbow
T.E. Pay limits
DI Top 321.00
Inlet
317.25
18° Elbow
New
30 L.F. an
P.R.C.C. D.I. ins
also 6' L.F. p
Trench
Pipe 1
DI 5 X
320
310
300
Outlet
Elev. 305.25
T.E.
Pay limit
Inlet
Elev. 310.36
306.73
Sta. 1184+70, LT. Bk.
New 12" x 20' L.F. C.S.P.
w/ P.R.C.C. D.I. at inlet
Stone Fill, Type II at outl
Stone Fill, Type II installed 7/14/97 M.W.H.
Field measured 2'X4'X2' = 0.6 c.y.
Pay trench earth 2'X4'X2' = 0.6 c.y.
305.50
303.0
#7-#0
#7-#9
#3.0
Trench Earth
Pipe 91.1° X 3.1/27 = 4.7 c.y.
DI 5 X 4.2 X 1.7/27 = 1.9 c.y.
stone Fill pad = 0.6 c.y.
6.2 c.y.
M.W.H. 12/5/97
50
40
30
20
10