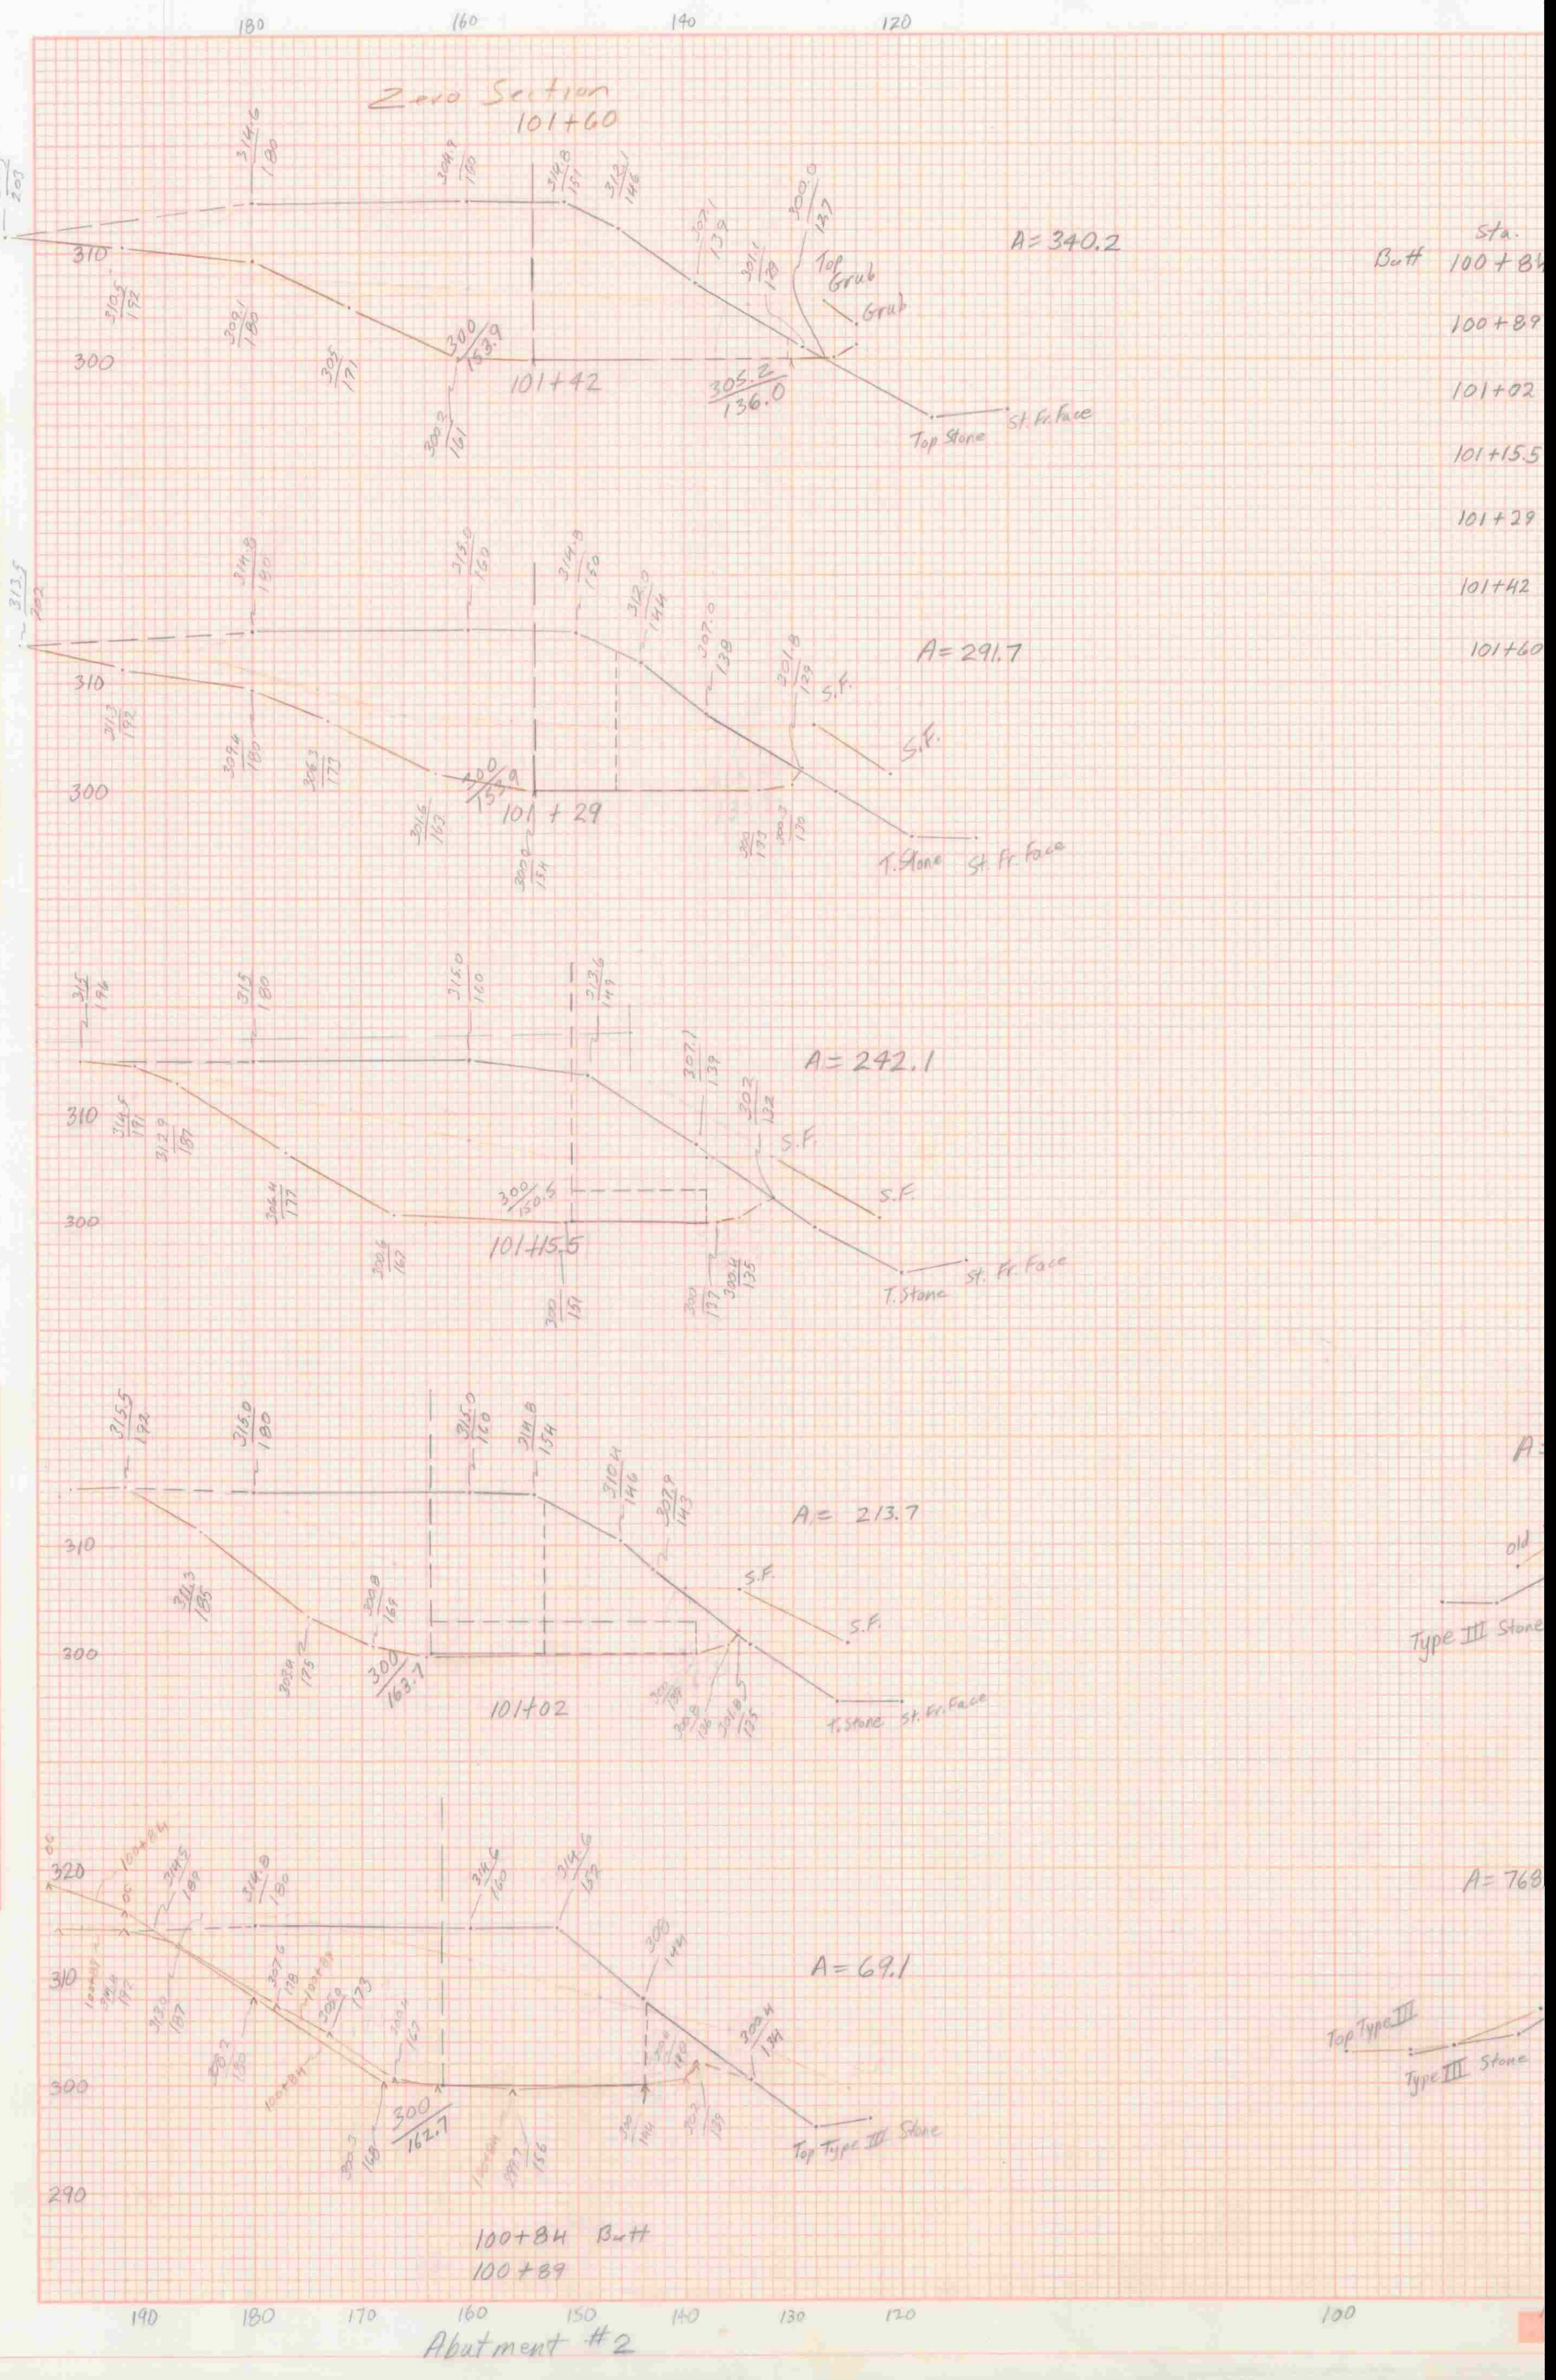
Zero Section
101+60
A=340.2
101+42
305.2
136.0
Top Grub
Grub
Top Stone
St. Fr. Face
A=291.7
101+29
S.F.
T. Stone
St. Fr. Face
A=242.1
101+15.5
A= 213.7
101+02
A=69.1
Top Type III Stone
100+84 Butt
100+89
Sta.
Butt 100+84
100+89
101+02
101+15.5
101+29
101+42
101+60
A=768
Top Type III
Type III Stone
320
310
300
290
190
180
170
160
150
140
130
120
100
Abutment #2
FINAL SURVEY
NOTE BOOK
SURVEYED
PLOTTED
TEMPLATE
AREAS
AREAS CHECKED
ORIGINAL SURVEY
BY
DATE
NO.

[redacted]