FINAL SURVEY
NOTE BOOK
NO.
SURVEYED
PLOTTED
TEMPLATE
AREAS
AREAS CHECKED
BY
DATE

ORIGINAL SURVEY
NOTE BOOK
NO.
SURVEYED
PLOTTED
TEMPLATE
AREAS
AREAS CHECKED
BY
DATE

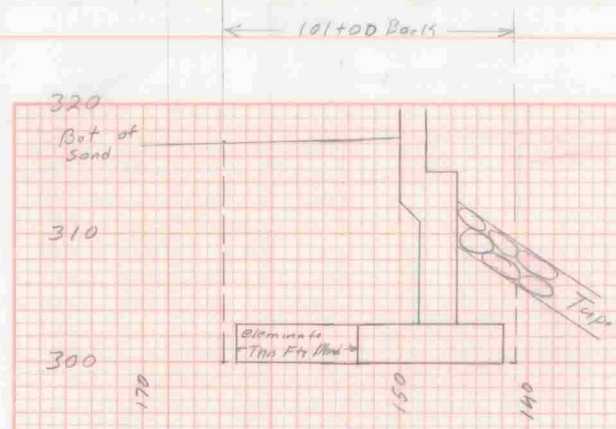
101+00 Back
320
Bot of Sand
310
Type III
300
Eleminate This Ftg Ahead
170
150
140

101+00

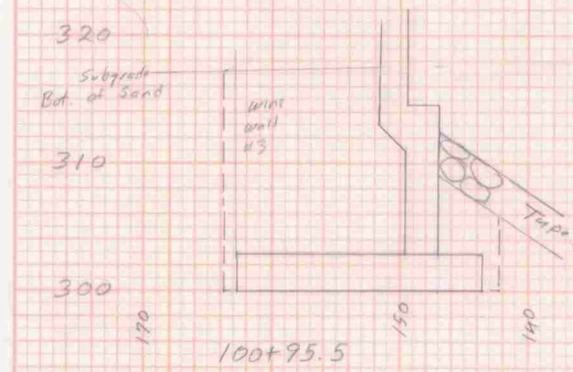
320
Subgrade
Bot. of Sand
Wing wall #3
310
Type III
300
170
150
140

100+95.5

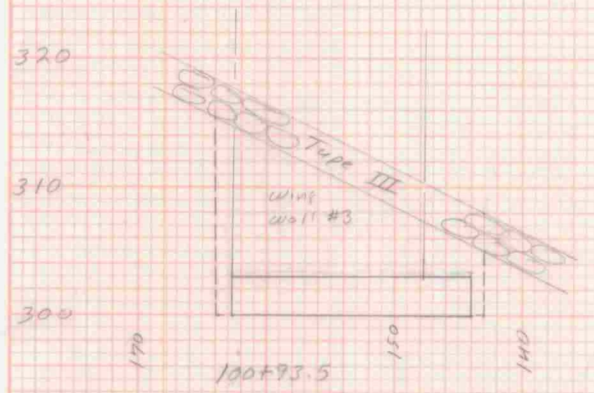
320
Type III
310
Wing wall #3
300
170
150
140

100+93.5

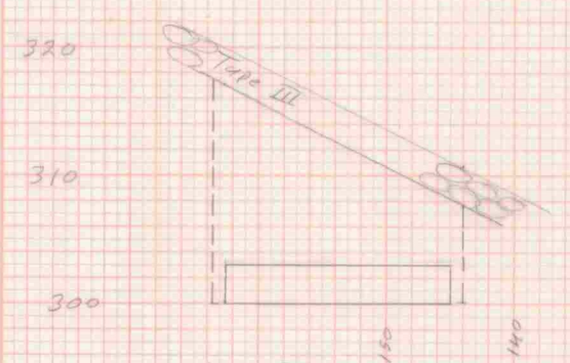
320
Type III
310
300
170
150
140

100+90

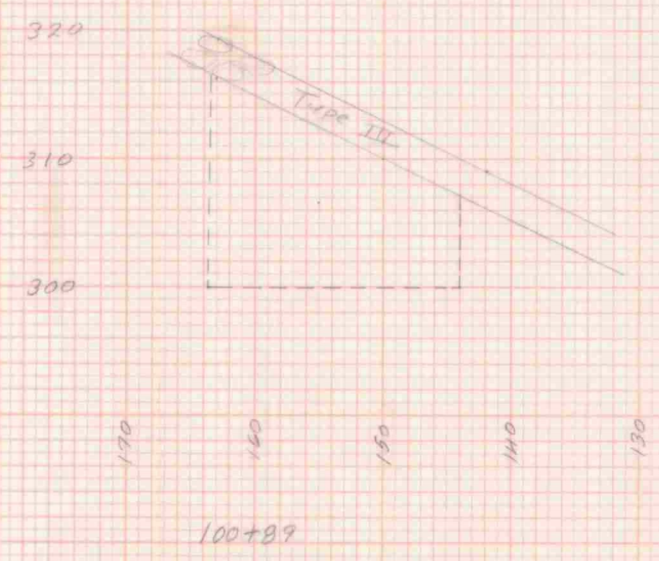
320
Type III
310
300
170
160
150
140
130

100+89

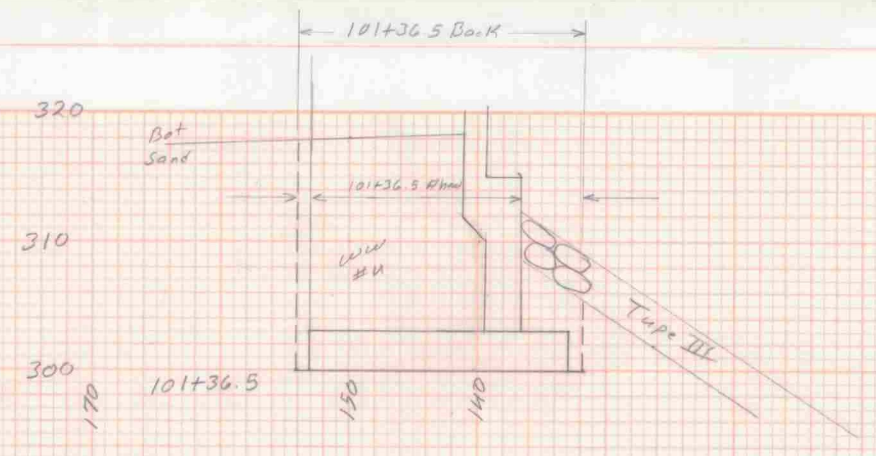
101+36.5 Back
320
Bot Sand
101+36.5 Ahead
310
WW #4
Type III
300
170
150
140

101+36.5

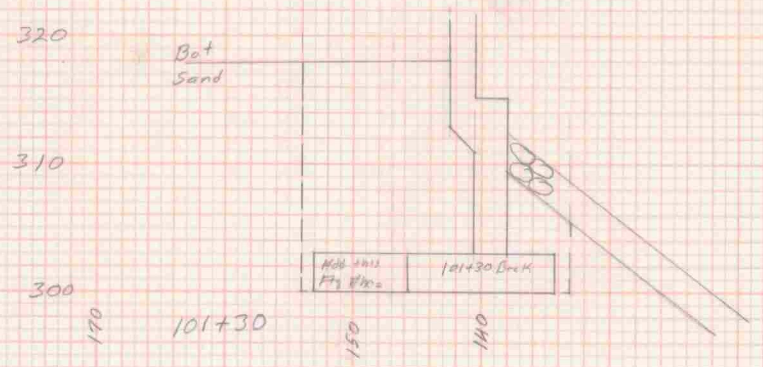
320
Bot Sand
310
300
Add this Ftg Ahead
101+30 Back
170
150
140

101+30

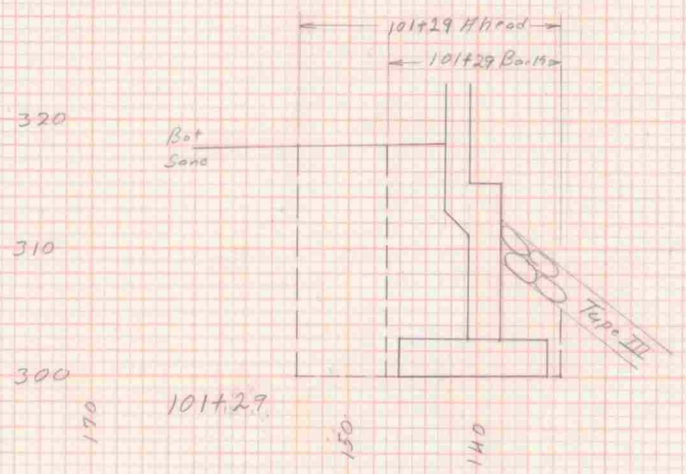
101+29 Ahead
101+29 Back
320
Bot Sand
310
Type III
300
170
150
140

101+29

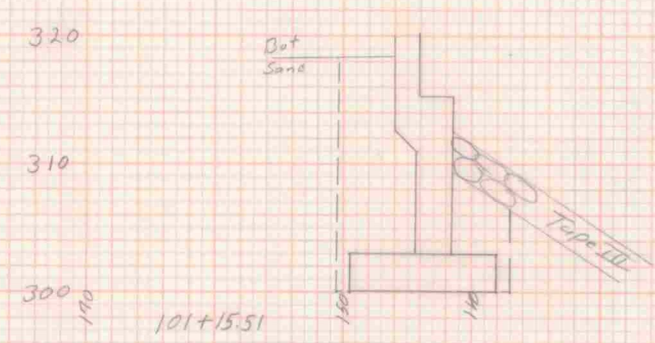
320
Bot Sand
310
Type III
300
170
150
140

101+15.51

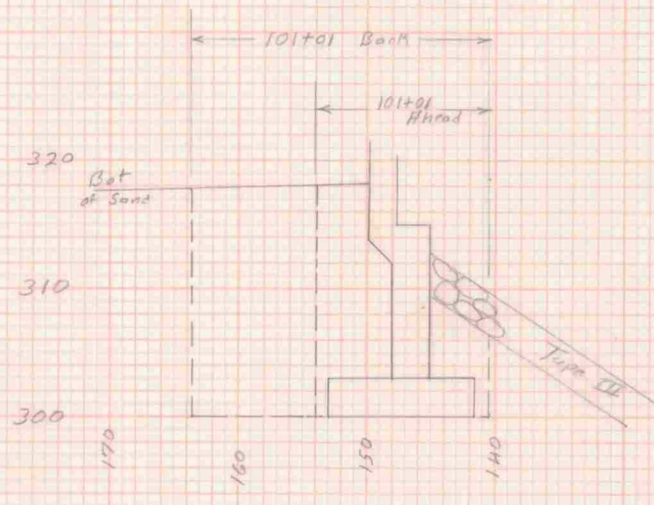
101+01 Bank
101+01 Ahead
320
Bot of Sand
310
Type III
300
170
160
150
140

101+01