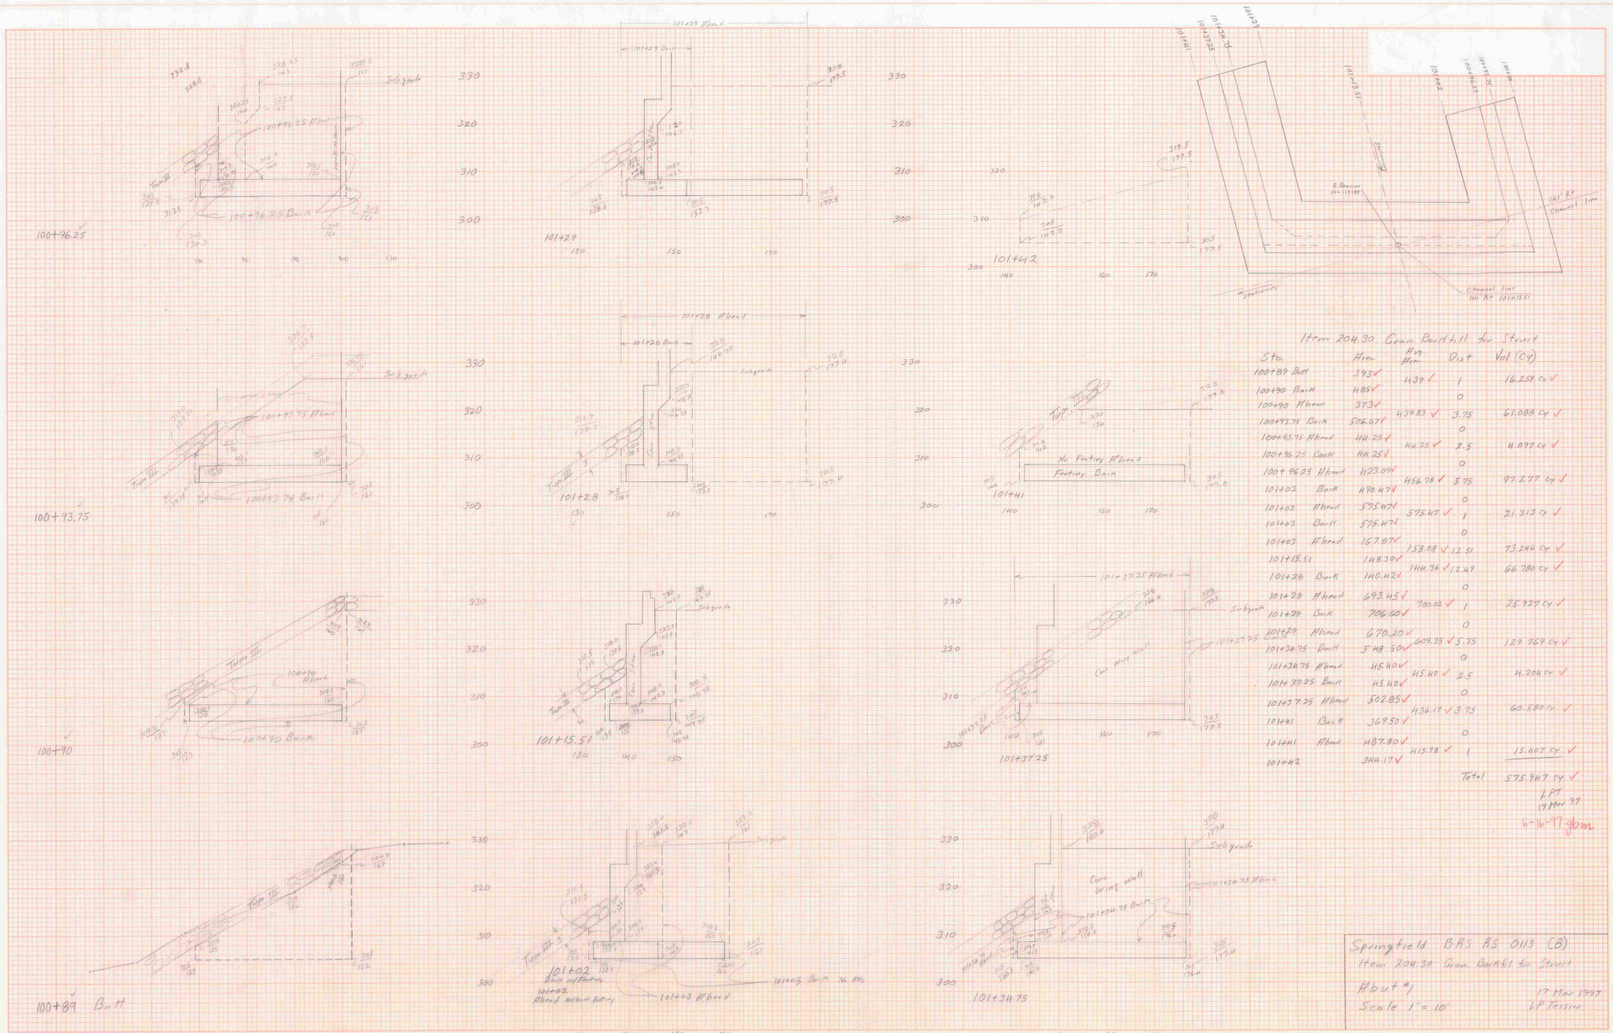

Item 204.30 Grav Backfill for Struct

Sta	Hte	Avg Hte	Dist	Vol (CY)
100+89 Bent	393 ✓	439 ✓	1	16.259 cy ✓
100+90 Back	485 ✓		0	
100+90 Ahead	373 ✓			
100+93.75 Back	506.67 ✓	439.83 ✓	3.75	61.888 cy ✓
100+93.75 Ahead	411.25 ✓		0	
100+96.25 Back	411.25 ✓	411.25 ✓	2.5	41.077 cy ✓
100+96.25 Ahead	423.00 ✓		0	
101+02 Back	470.47 ✓	456.78 ✓	5.75	97.277 cy ✓
101+02 Ahead	575.47 ✓		0	
101+03 Back	575.47 ✓	575.47 ✓	1	21.313 cy ✓
101+03 Ahead	627.87 ✓		0	
101+15.51	648.30 ✓	638.08 ✓	12.51	73.246 cy ✓
101+28 Back	640.42 ✓	644.36 ✓	12.49	66.780 cy ✓
101+28 Ahead	693.45 ✓		0	
101+29 Back	706.60 ✓	700.02 ✓	1	25.929 cy ✓
101+29 Ahead	670.20 ✓		0	
101+34.75 Back	548.50 ✓	609.35 ✓	5.75	129.769 cy ✓
101+34.75 Ahead	415.40 ✓		0	
101+37.25 Back	415.40 ✓	415.40 ✓	2.5	41.204 cy ✓
101+37.25 Ahead	502.85 ✓		0	
101+41 Back	567.50 ✓	436.17 ✓	3.75	60.580 cy ✓
101+41 Ahead	487.80 ✓		0	
101+42	344.17 ✓	415.78 ✓	1	15.407 cy ✓
			Total	575.947 cy ✓

LP
17 Mar 97

6-16-97 jbm

Springfield BRS RS 0113 (8)
Item 204.30 Grav Backfill for Struct
Abut #1
Scale 1" = 10'
17 Mar 1997
LP Tessier

Keuffel & Esser Company PLATE 3, CROSS SECTION 467056 Made in U.S.A.