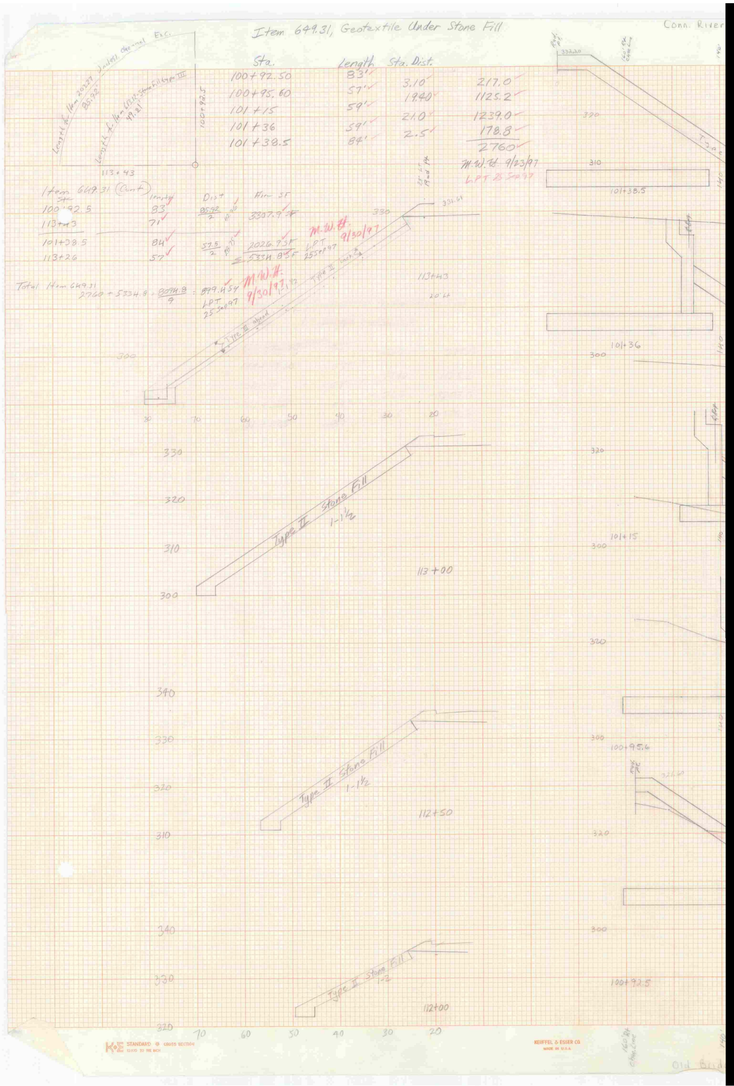
Item 649.31, Geotextile Under Stone Fill
Sta.
Length
Sta. Dist.
100+92.50
83'
3.10'
217.0'
100+95.60
57'
19.40'
1125.2'
101+15
58'
21.0'
1239.0'
101+36
54'
2.5'
178.8'
101+38.5
84'
2760'
113+43
Item 649.31 (Cont.)
Trinity
Dist.
Min. SF
100+92.5
83'
71'
113+43
101+38.5
84'
57'
113+26
Total Item 649.31
Type II Stone Fill
1:1½
113+00
112+50
112+00
101+36
101+15
100+92.5
KEUFFEL & ESSER CO.
STANDARD ® GRAPH SECTION