Metric

ROADWAY LAYOUT SHEET 3

CURVE #2 DATA
Δ = 12°15' 36" LT
R = 254.00 m
T = 27.279 m
L = 54.350 m
E = 1.461m
BANK = 0.053 m/m

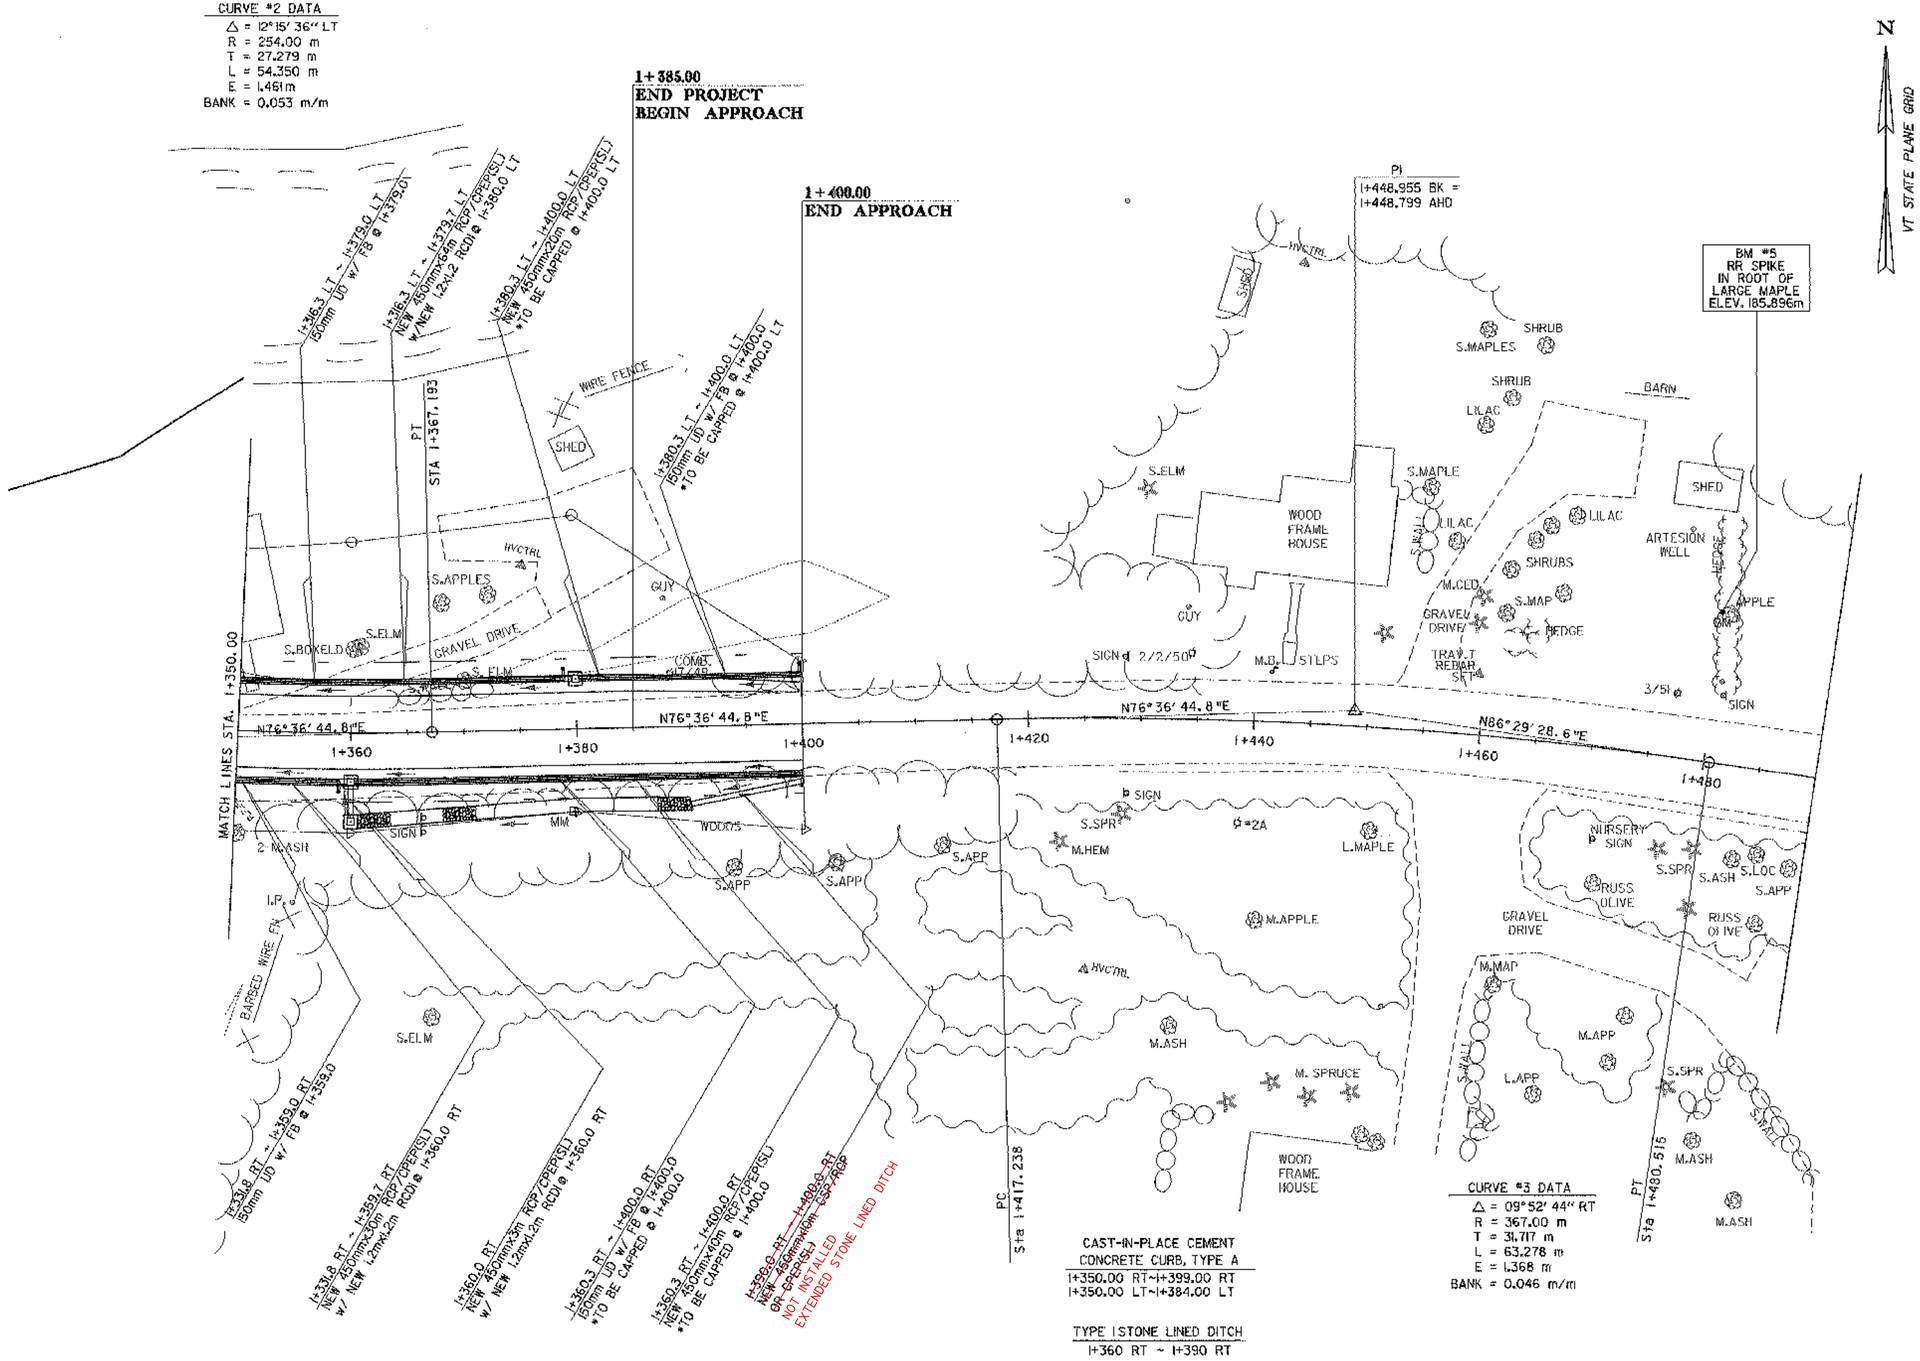

CURVE #3 DATA
Δ = 09°52' 44" RT
R = 367.00 m
T = 31.717 m
L = 63.278 m
E = 1.368 m
BANK = 0.046 m/m

CAST-IN-PLACE CEMENT
CONCRETE CURB, TYPE A
1+350.00 RT~1+399.00 RT
1+350.00 LT~1+384.00 LT

TYPE I STONE LINED DITCH
1+360 RT ~ 1+390 RT

0 10 20 30
SCALE IN METERS

DATUM
VERTICAL NAVD 88
HORIZONTAL NAD83 (92)

PROJECT: BRISTOL	PROJECT NO.: BRF 021-1(13)
DESIGN FILE NAME: /str2/78f188/df188bdr.dgn	
IPARM FILE NAME: df18813.i	PLOT DATE: 28-NOV-2006
SURVEYED BY: L. ORVIS	SURVEY DATE: 9-97
SQUAD LEADER: A. PORTALUPI	DRAWN BY: STR2
LAYOUT SHEET 3	SHEET: 19 OF 67