METRIC

METRIC

1. ALL DIMENSIONS ARE IN MILLIMETERS UNLESS OTHERWISE NOTED.
2. ALL WEIGHTS ARE IN KILOGRAMS.

FED. ROAD DIV. NO.	STATE	FED. AID PROJ. NO.
	VT	

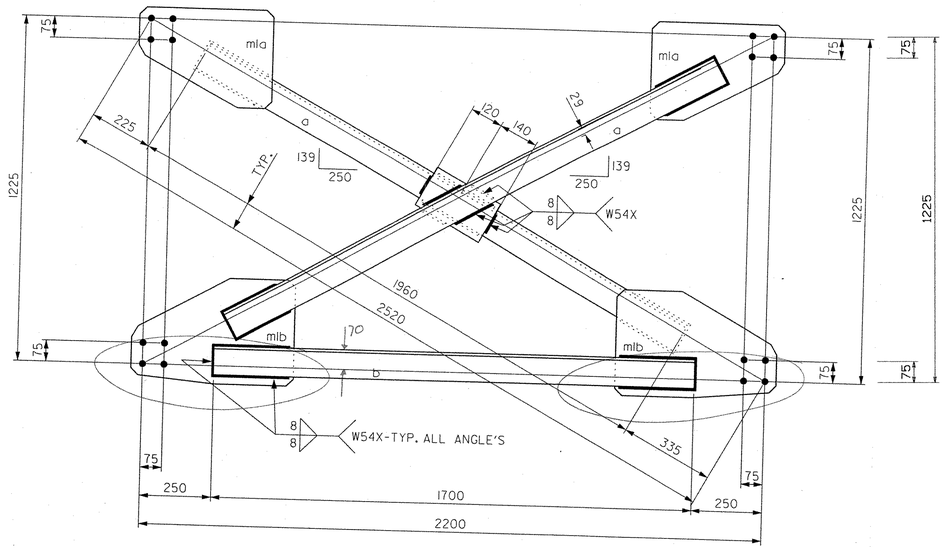

INTERMEDIATE CROSSFRAMES MK.~ CF1

c:\vend\beam.dgn Dec. 07, 1999 11:55:57

BILL OF MATERIAL

NO.	MARK	DESCRIPTION	LENGTH	REMARKS	ITEM	SHIP. WEIGHT EA.
24	CF1	CROSSFRAMES				174 kg
48	a	L102 x 102 x 9.5	1960	(L4 x 4 x 3/8)	377	
24	b	L102 x 102 x 9.5	1700	(L4 x 4 x 3/8)	377	
48	m1a	PL 350 x 14	470		378	
48	m1b	PL 350 x 14	570		378	
24	m1c	PL 155 x 14	260		378	

RECEIVED
CK'D BY RGW OK'D BY AP
NOV 16 1999
RESUBMIT Y APPROVED DATE 12/6/99 AS NOTED

SHOP NOTE

HOLES: 24ø
BOLTS: NONE
PAINT: NONE
FOR GENERAL SHOP NOTES, SEE DWG. GN1.

NO.	REVISION	BY	DATE
1			
2			
3			

HIGH STEEL STRUCTURES, INC.
1770 Hempstead Road
Lancaster, PA 17605-0008
Phone 717/299-5211
A Division of High Industries, Inc.

CROSSFRAME CF1
VT. 116 OVER NEW HAVEN RIVER
VT. 116 STA. 1+255.00 TO STA. 1+299.00
TOWN OF BRISTOL, BRIDGE NO. 10
STATE OF VERMONT
AGENCY OF TRANSPORTATION

STATE CONTRACT OR REF. NO. PROJECT NO. ER 021-1(13) 069
CONTRACTOR BECK & BELLUCCI, INC.
IN CHARGE: ALLEN (IH) MADE BY: AGG CHK'D BY: PFH DATE: 11-8-99
CONTRACT NUMBER: VT-99109-1 DRAWING NUMBER: 2 OF 7

CODE: 63

PLOTTED: 18 NOV 1999
14:28:31
BY: ashue