



124+00

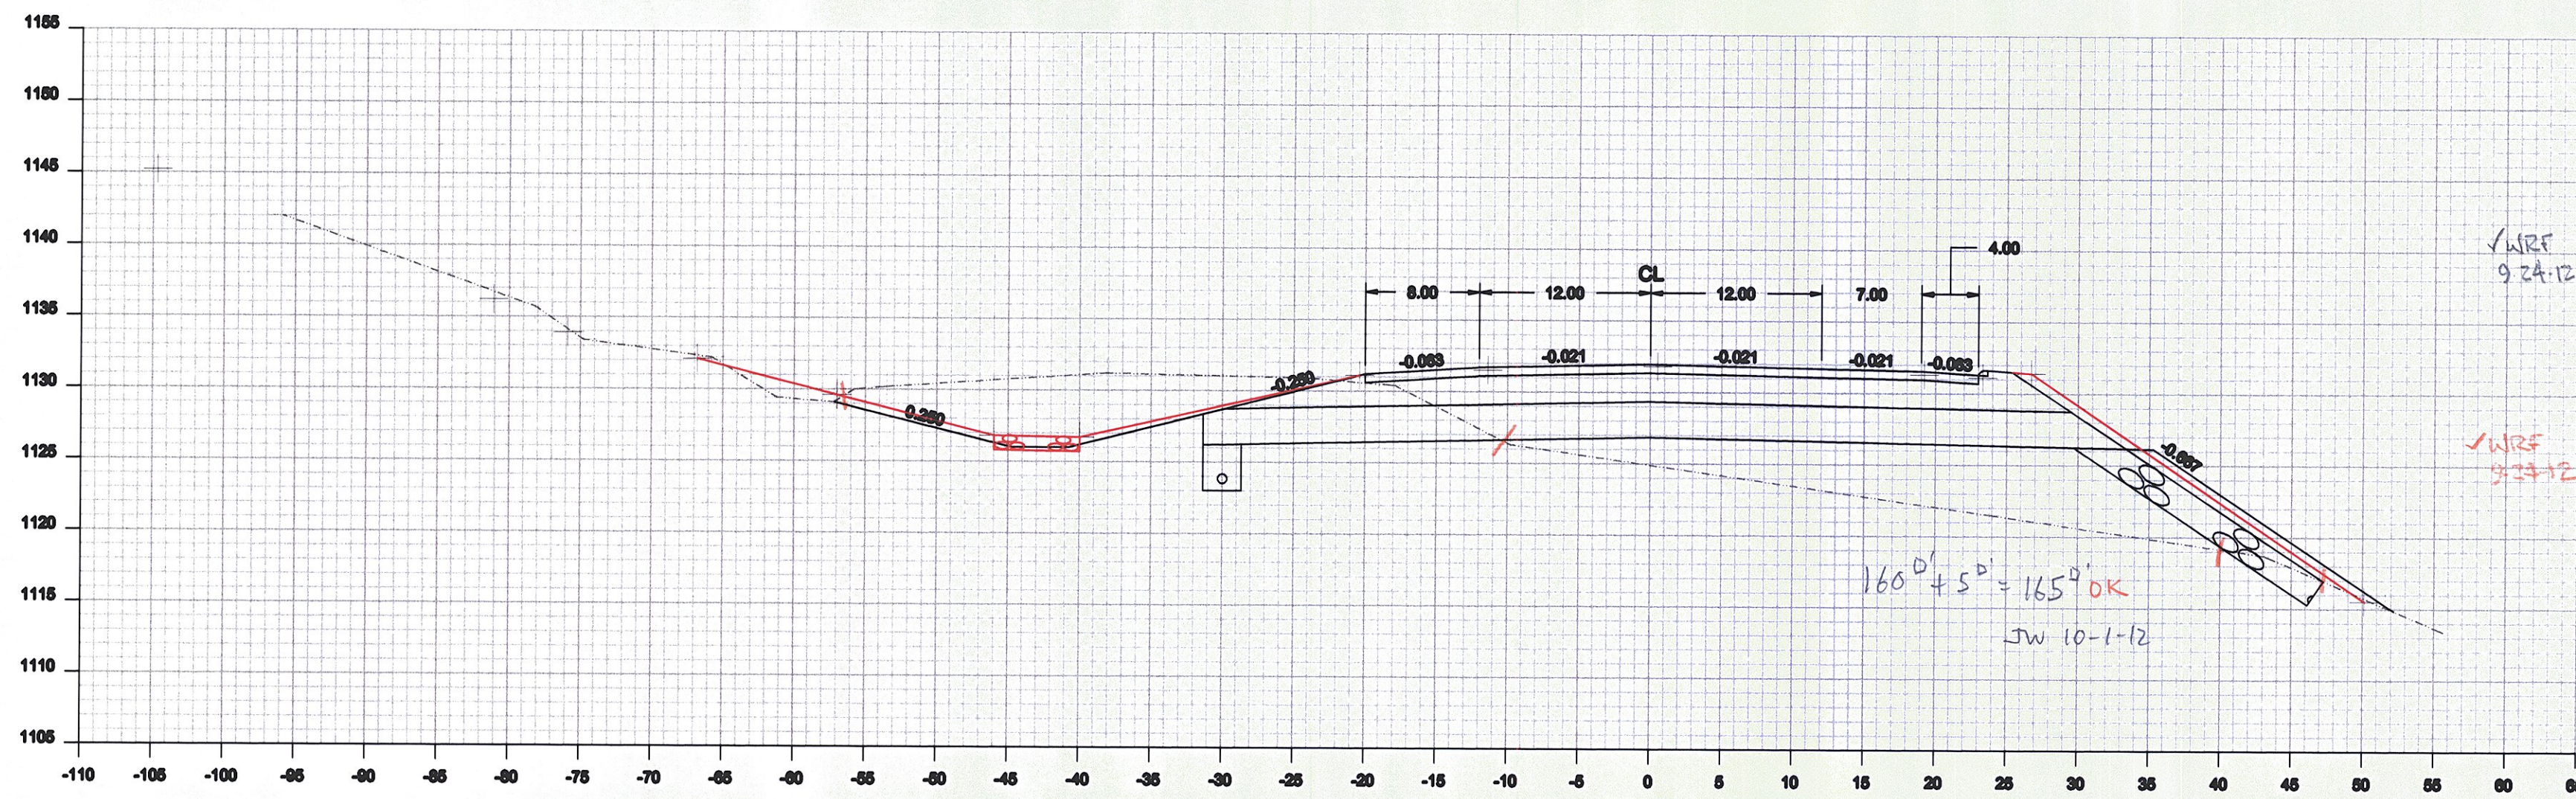

123+50

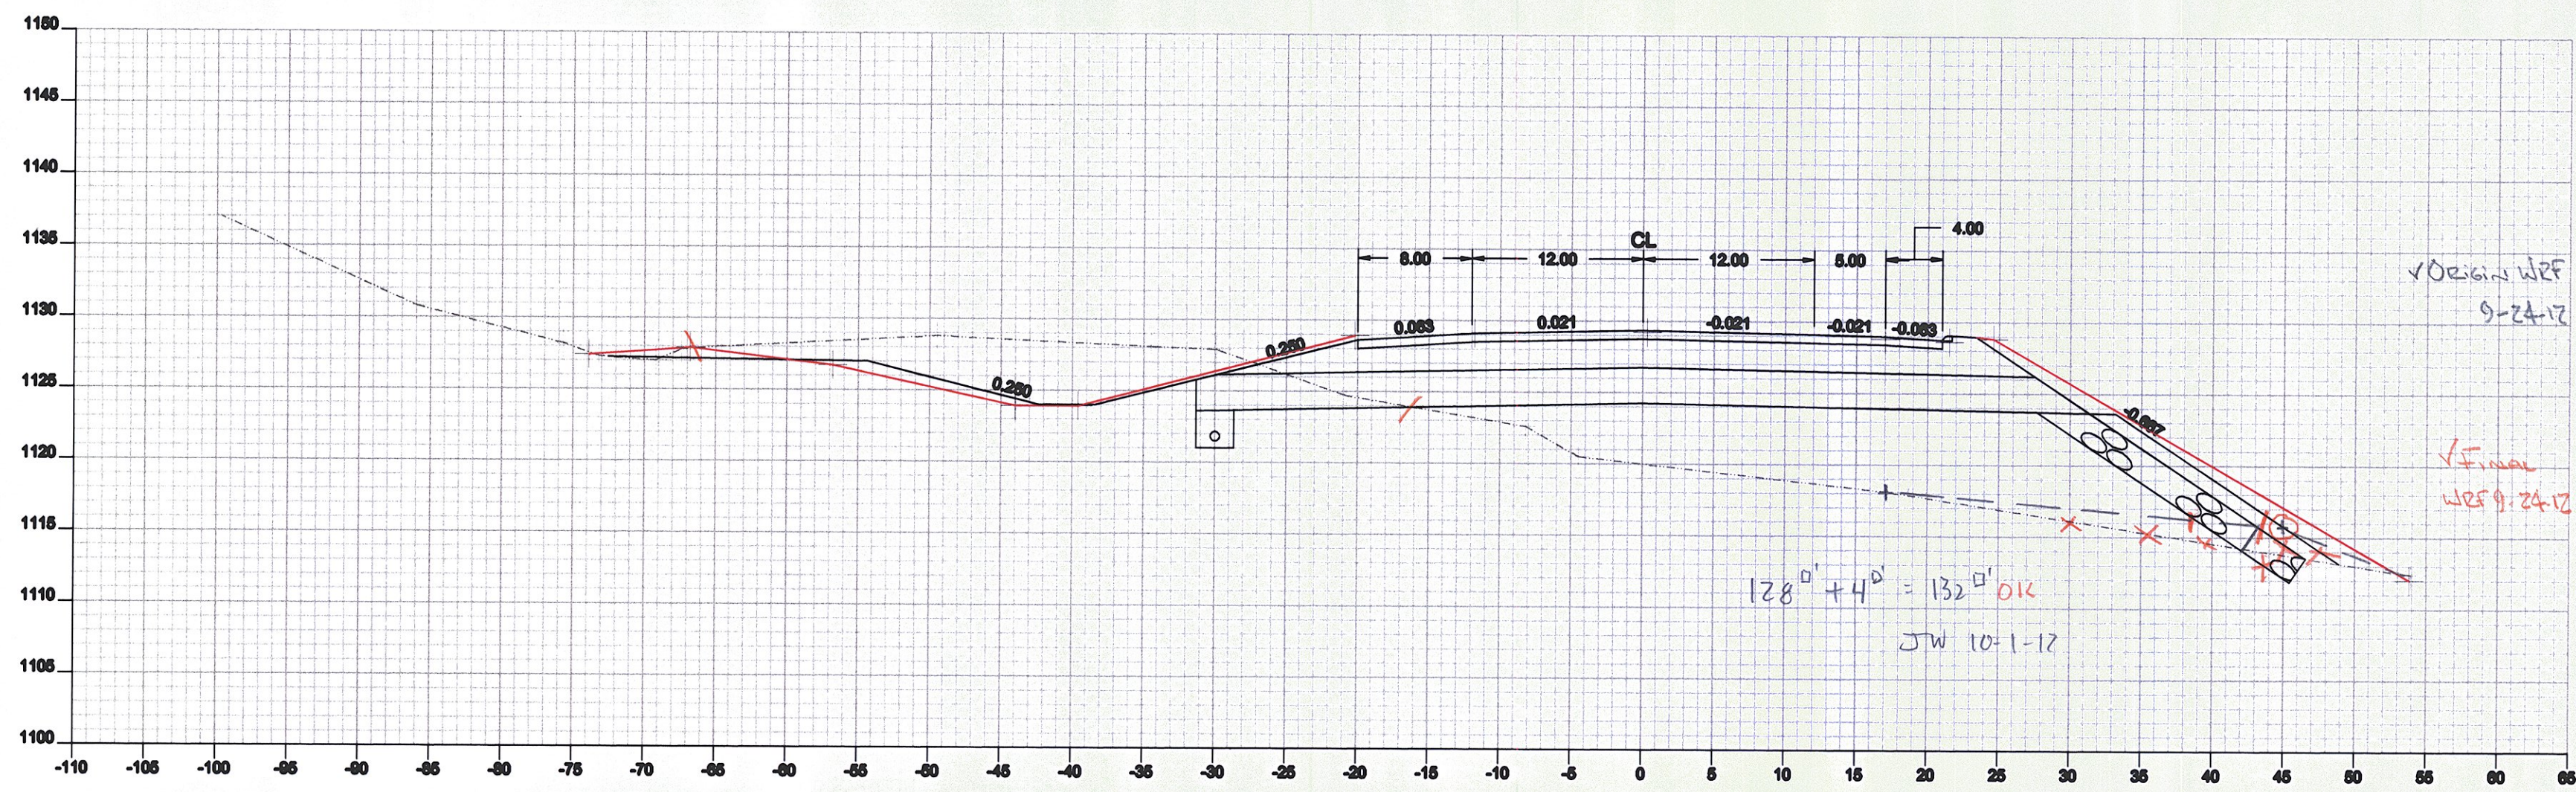

123+00

Drawing:	Section 123+00 - 124+00
Project:	Cabot Danville
Drawn By:	JMR
Date:	09-19-2012
Checked By:	
Date:	
Scale:	1:10
Sheet:	of