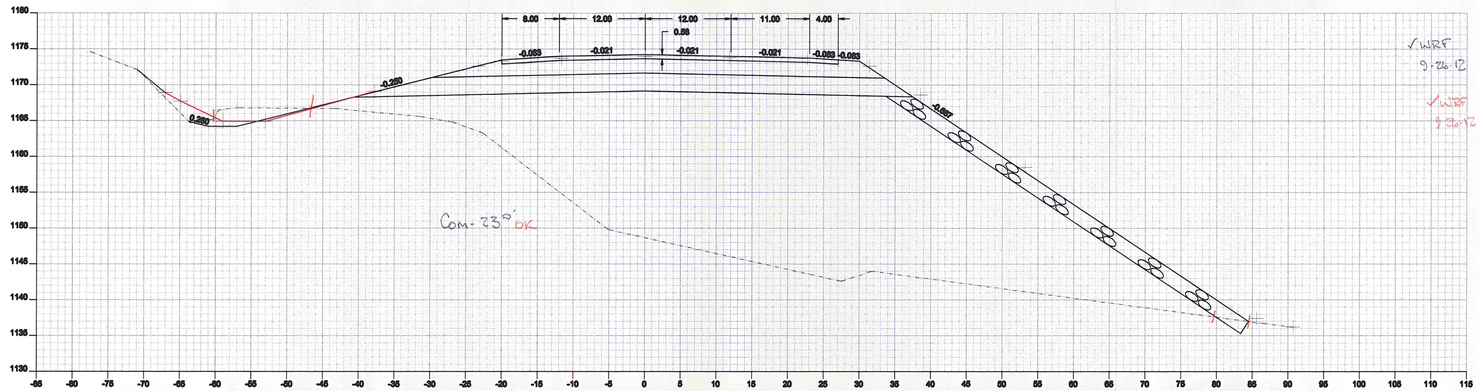

132+50

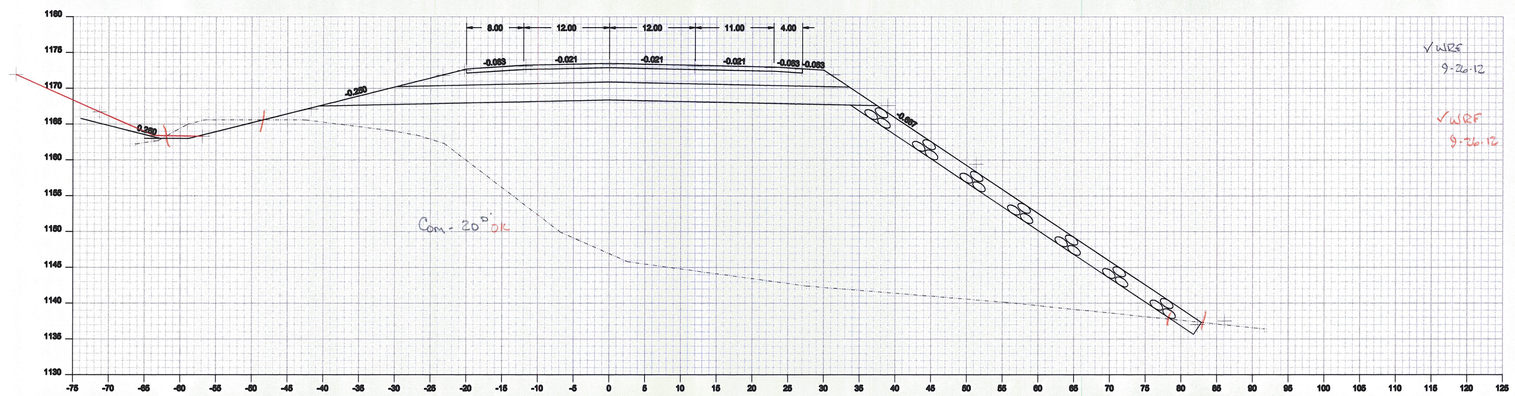

132+00

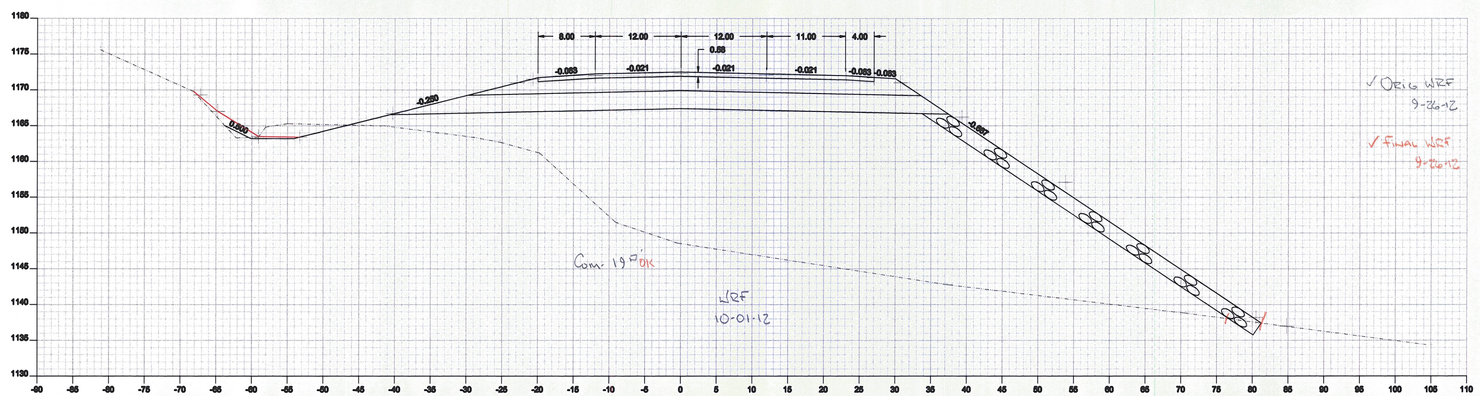

131+50

Drawing: Cross Section 131+50 to 132+50	
Project: Cabot Danville	
Drawn By: JMR	Checked By:
Date: 09-21-2012	Date:
Scale: 1 : 10	Sheet: of