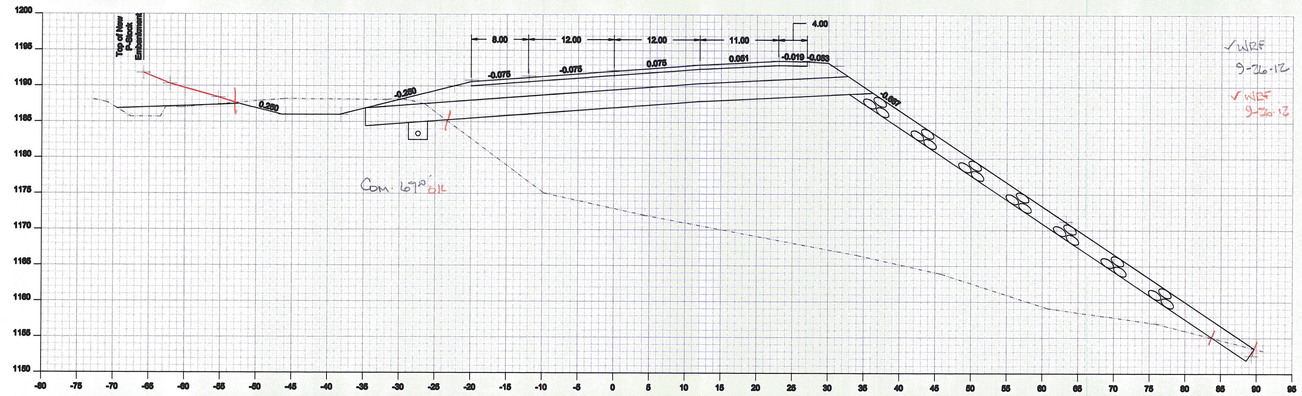

139+50

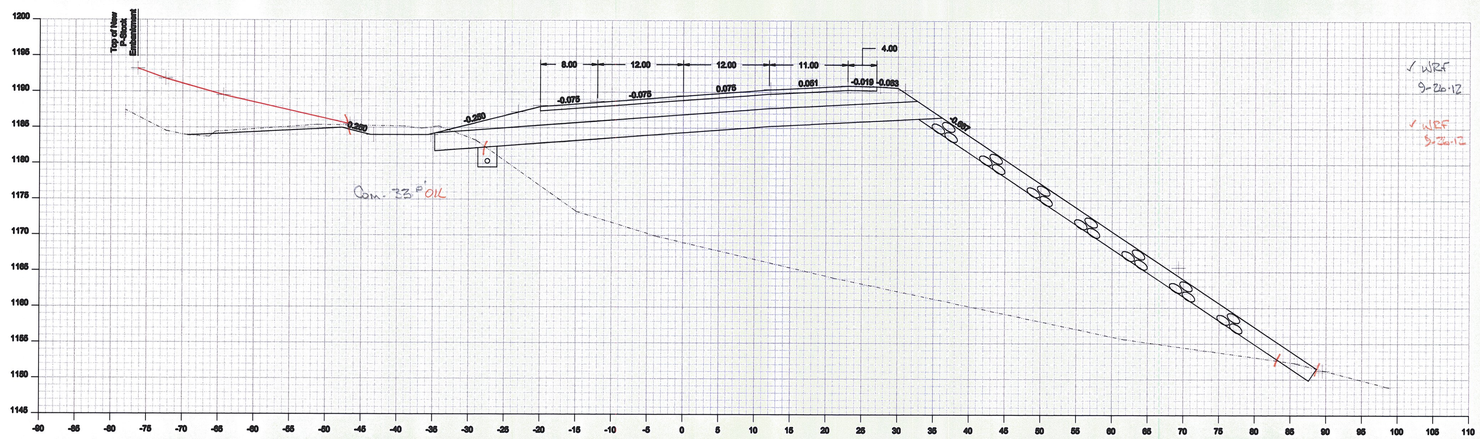

139+00

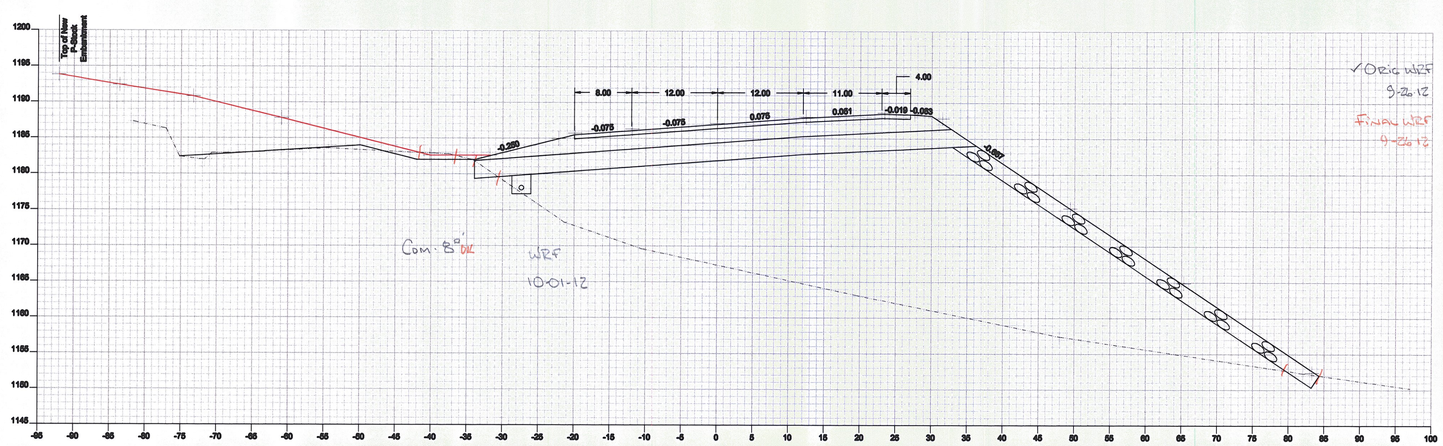

138+50

Drawing: Cross Section 138+50 to 139+50	
Project: Cabot Danville	
Drawn By: JMR	Checked By:
Date: 09-21-2012	Date:
Scale: 1 : 10	Sheet: of