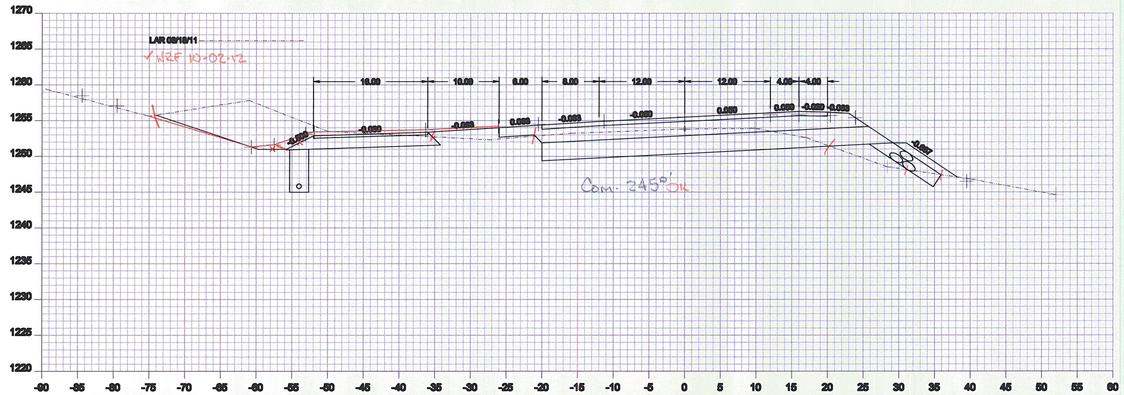

167+00

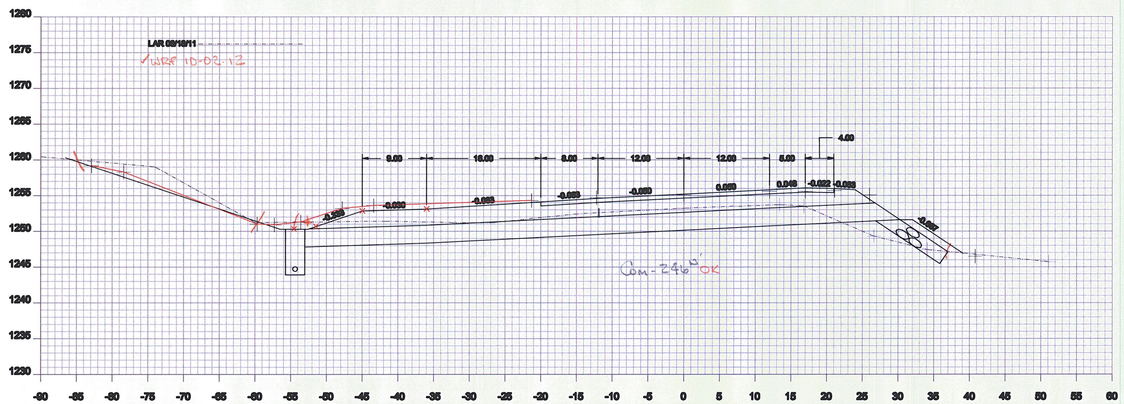

166+50

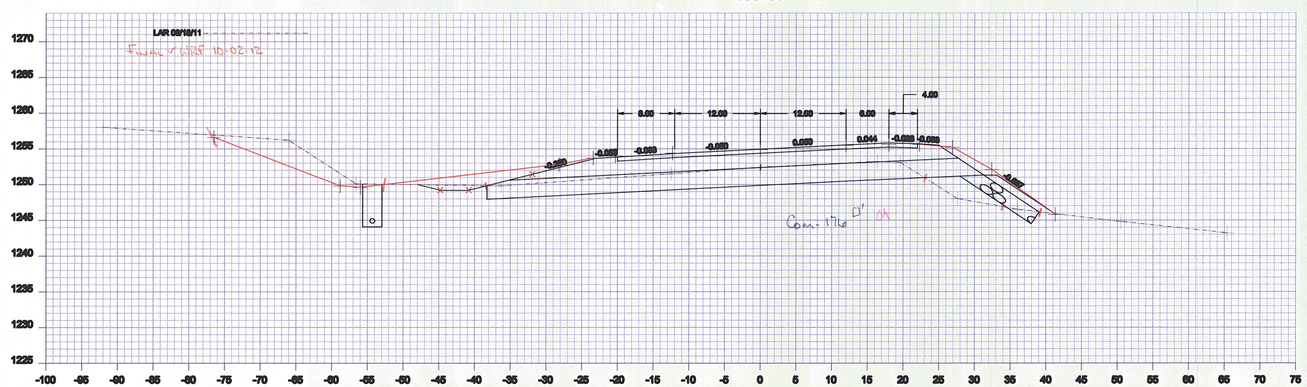

166+00

Drawing: Cross Section 166+00 - 167+00	
Project: Cabot Danville	
Drawn By: JMR	Checked By:
Date: 09-25-2012	Date:
Scale: 1 : 10	Sheet: of