PLATE 3-FULL CROSS SECTION-FULL LINE
HIGHWAY LEGEND VIA SHEET
VERMONT VERSATILE
PRINTED IN U.S.A.

ORIGINAL | VERIFIED | DESIGNED | DRAWN | REVISED | STRUCTURE | BRIDGE | SIGNAL | NO. | SCALE | BY | DATE | NOTE BOOK | PAGE | VERIFIED | DESIGNED | DRAWN | REVISED | STRUCTURE | BRIDGE | SIGNAL | NO. | SCALE | BY | DATE

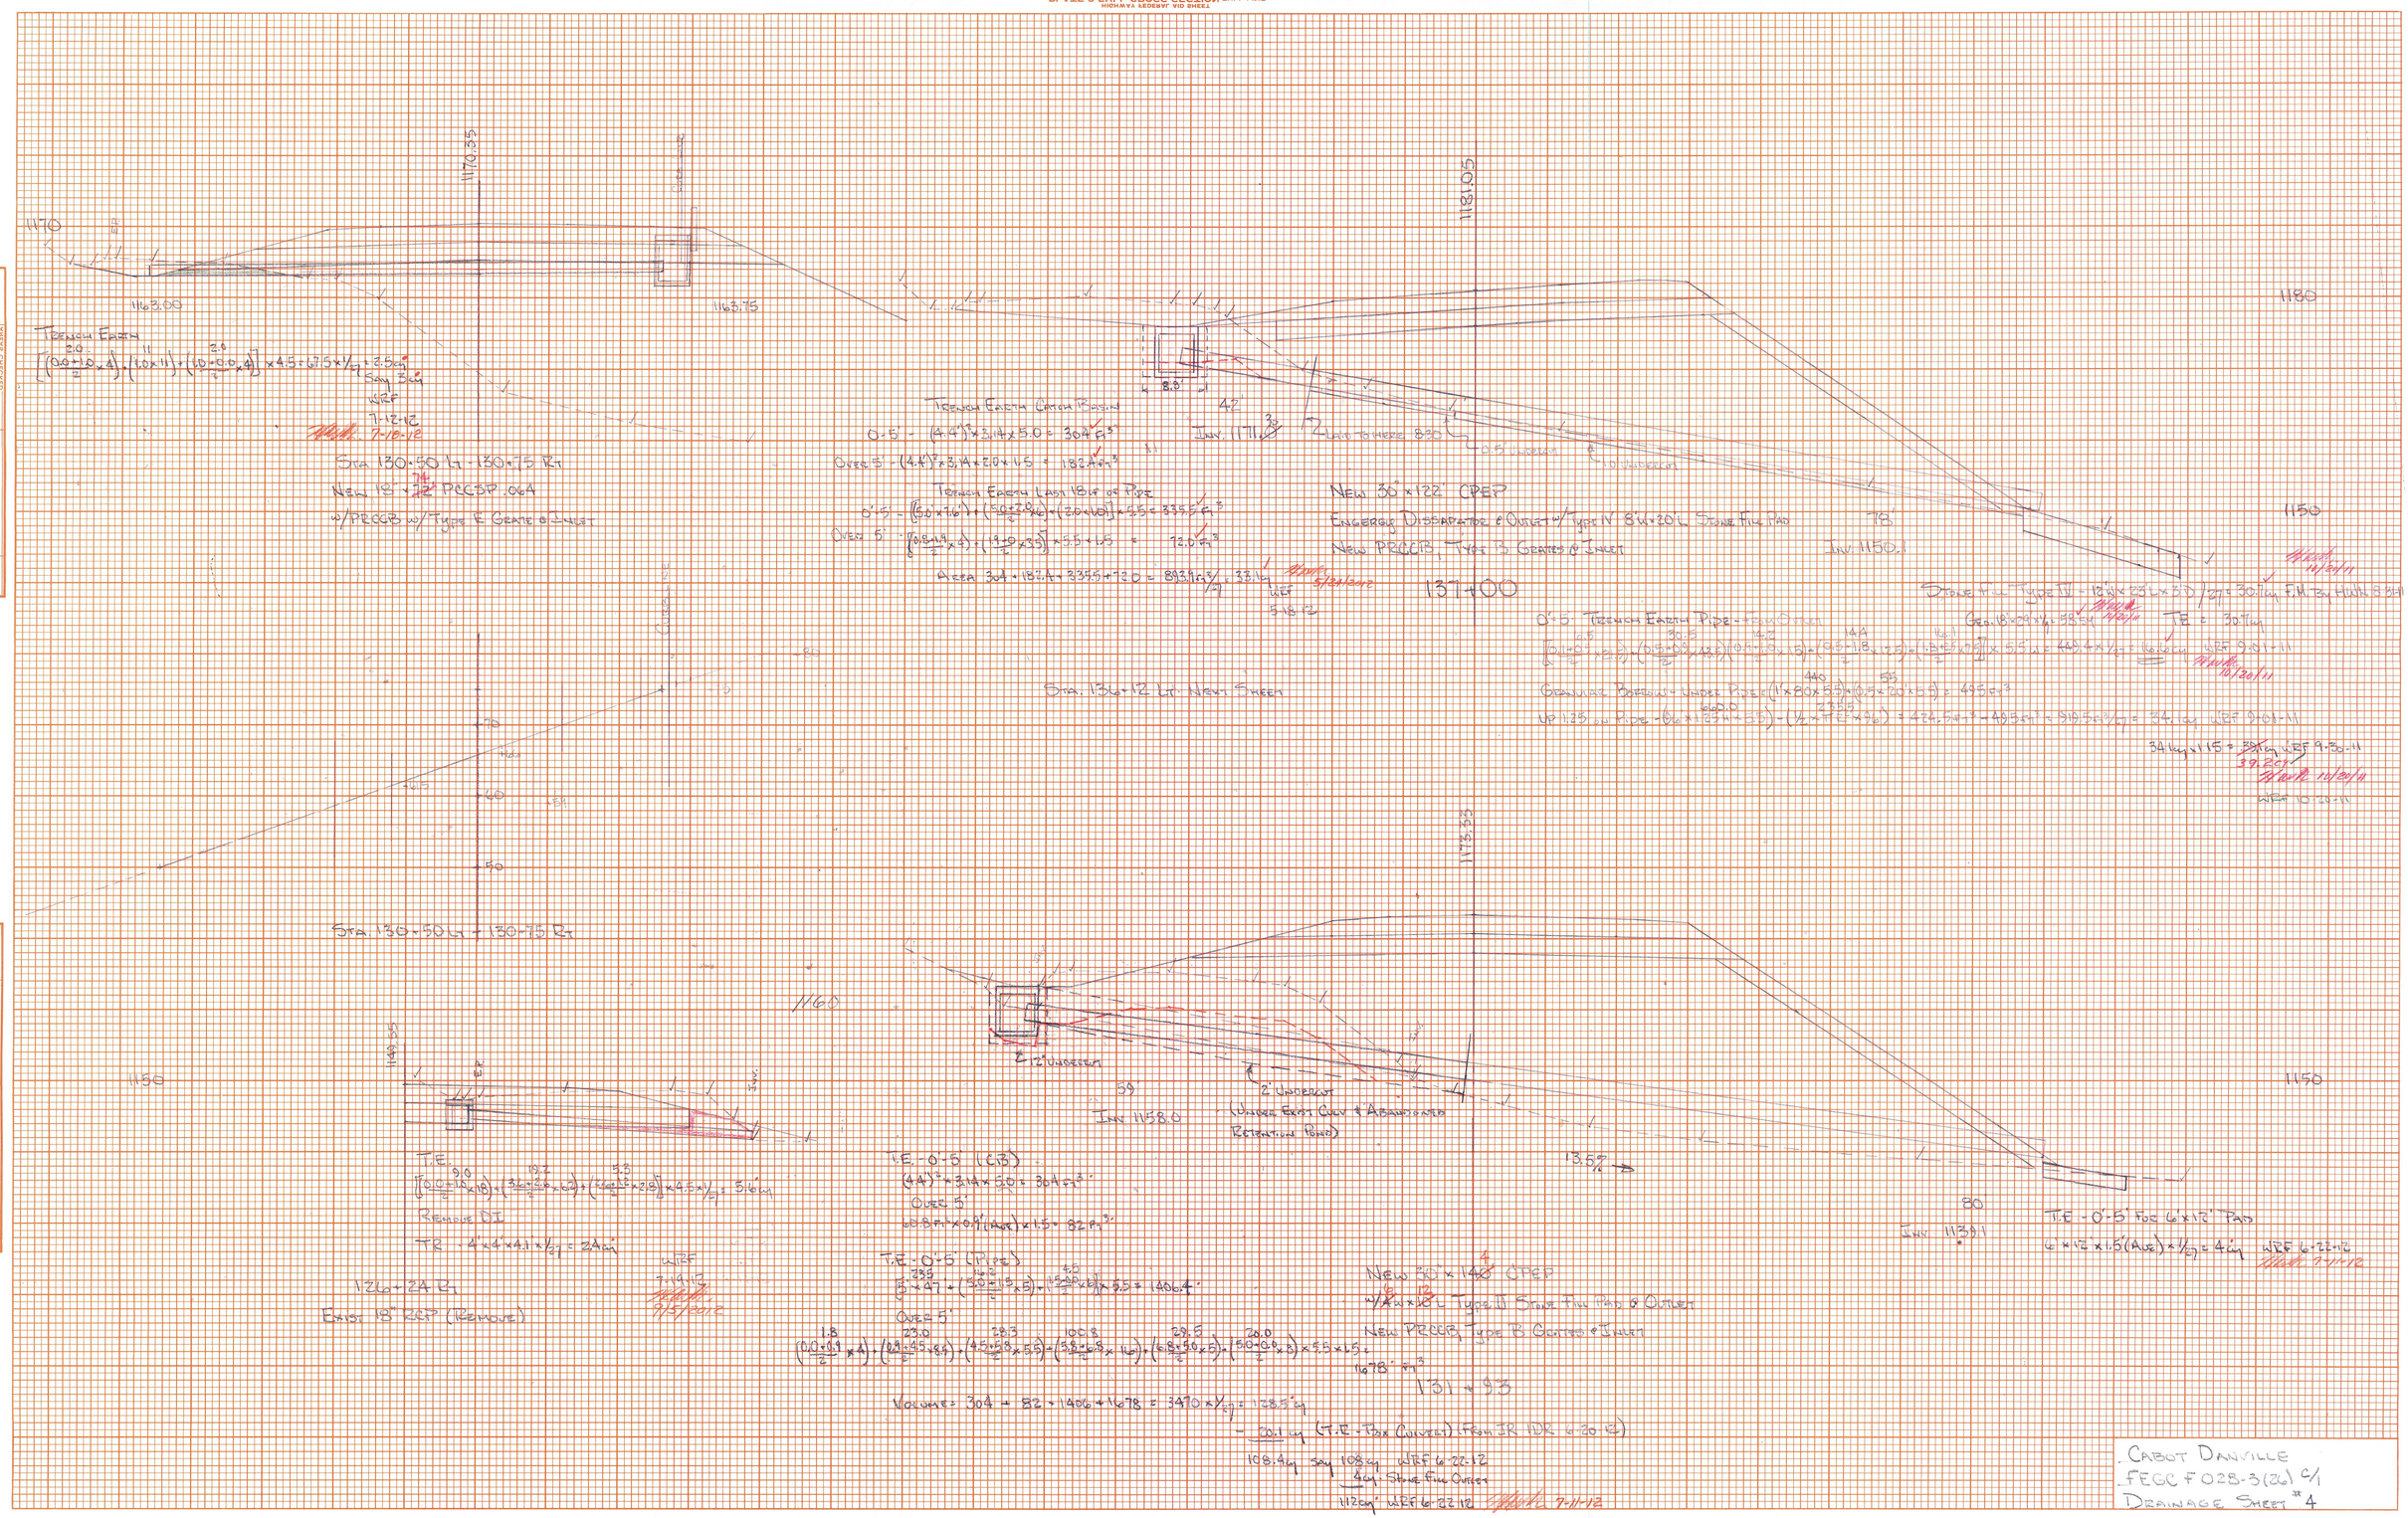

Cabot Danville
FEGC F 028-3(26) C/1
Drainage Sheet #4