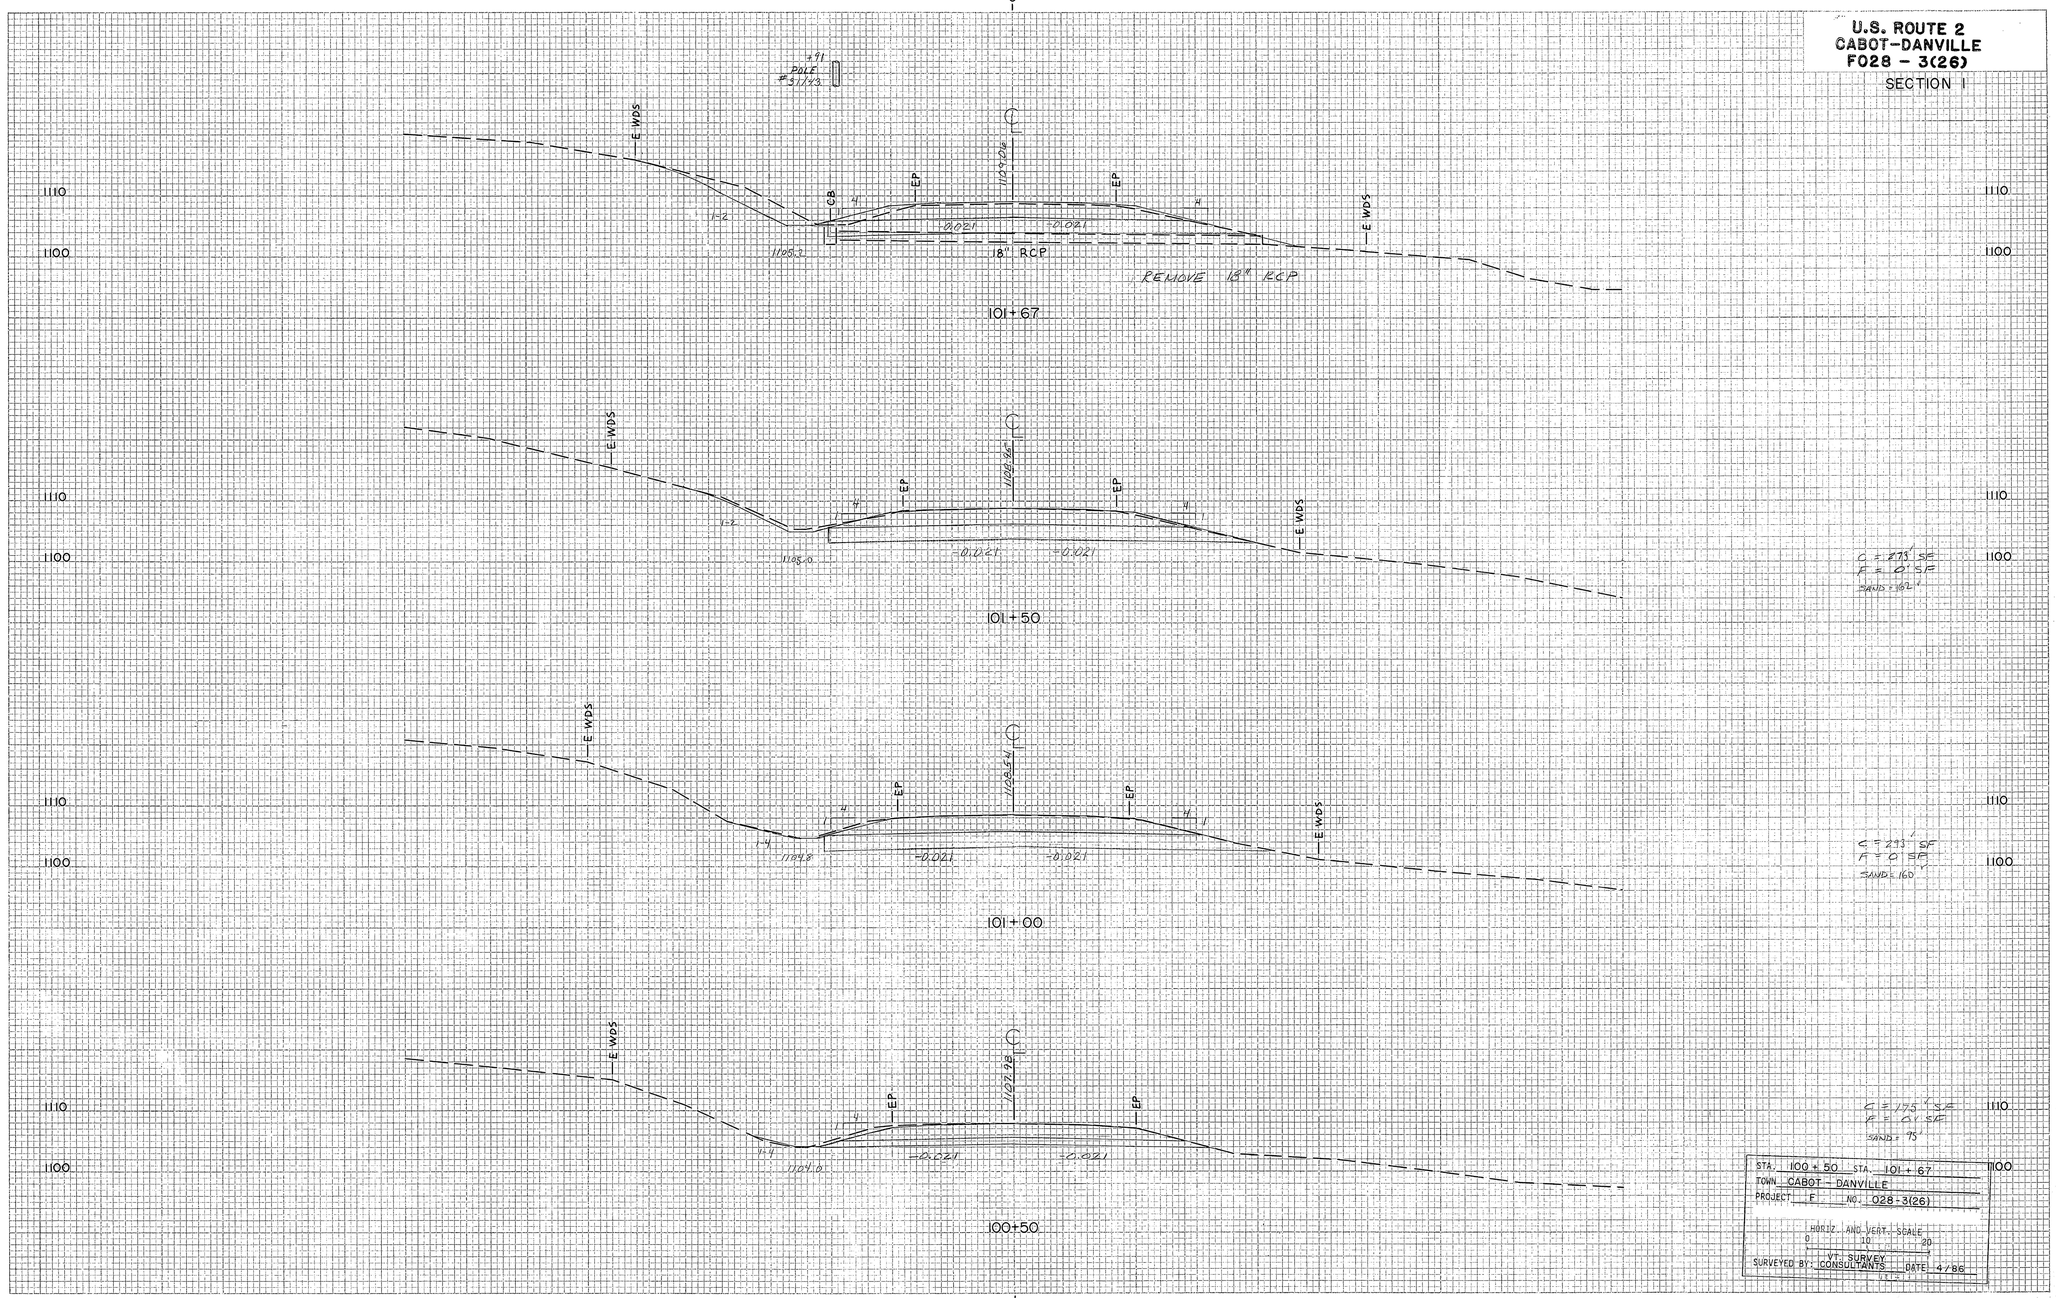


PROJECT NAME:	CABOT-DANVILLE
PROJECT NUMBER:	FEGC F 028-3(26) C/I

FILE NAME: 78d058xs.dgn	PLOT DATE: 06-OCT-2010
PROJECT LEADER: K. ROBIE	DRAWN BY: I. SHEA
DESIGNED BY: I. SHEA	CHECKED BY: S. MENARD
MAINLINE CROSS SECTIONS 2	SHEET 134 OF 250