


U.S. ROUTE 2
CABOT-DANVILLE
F028 - 3(26)

SECTION 1



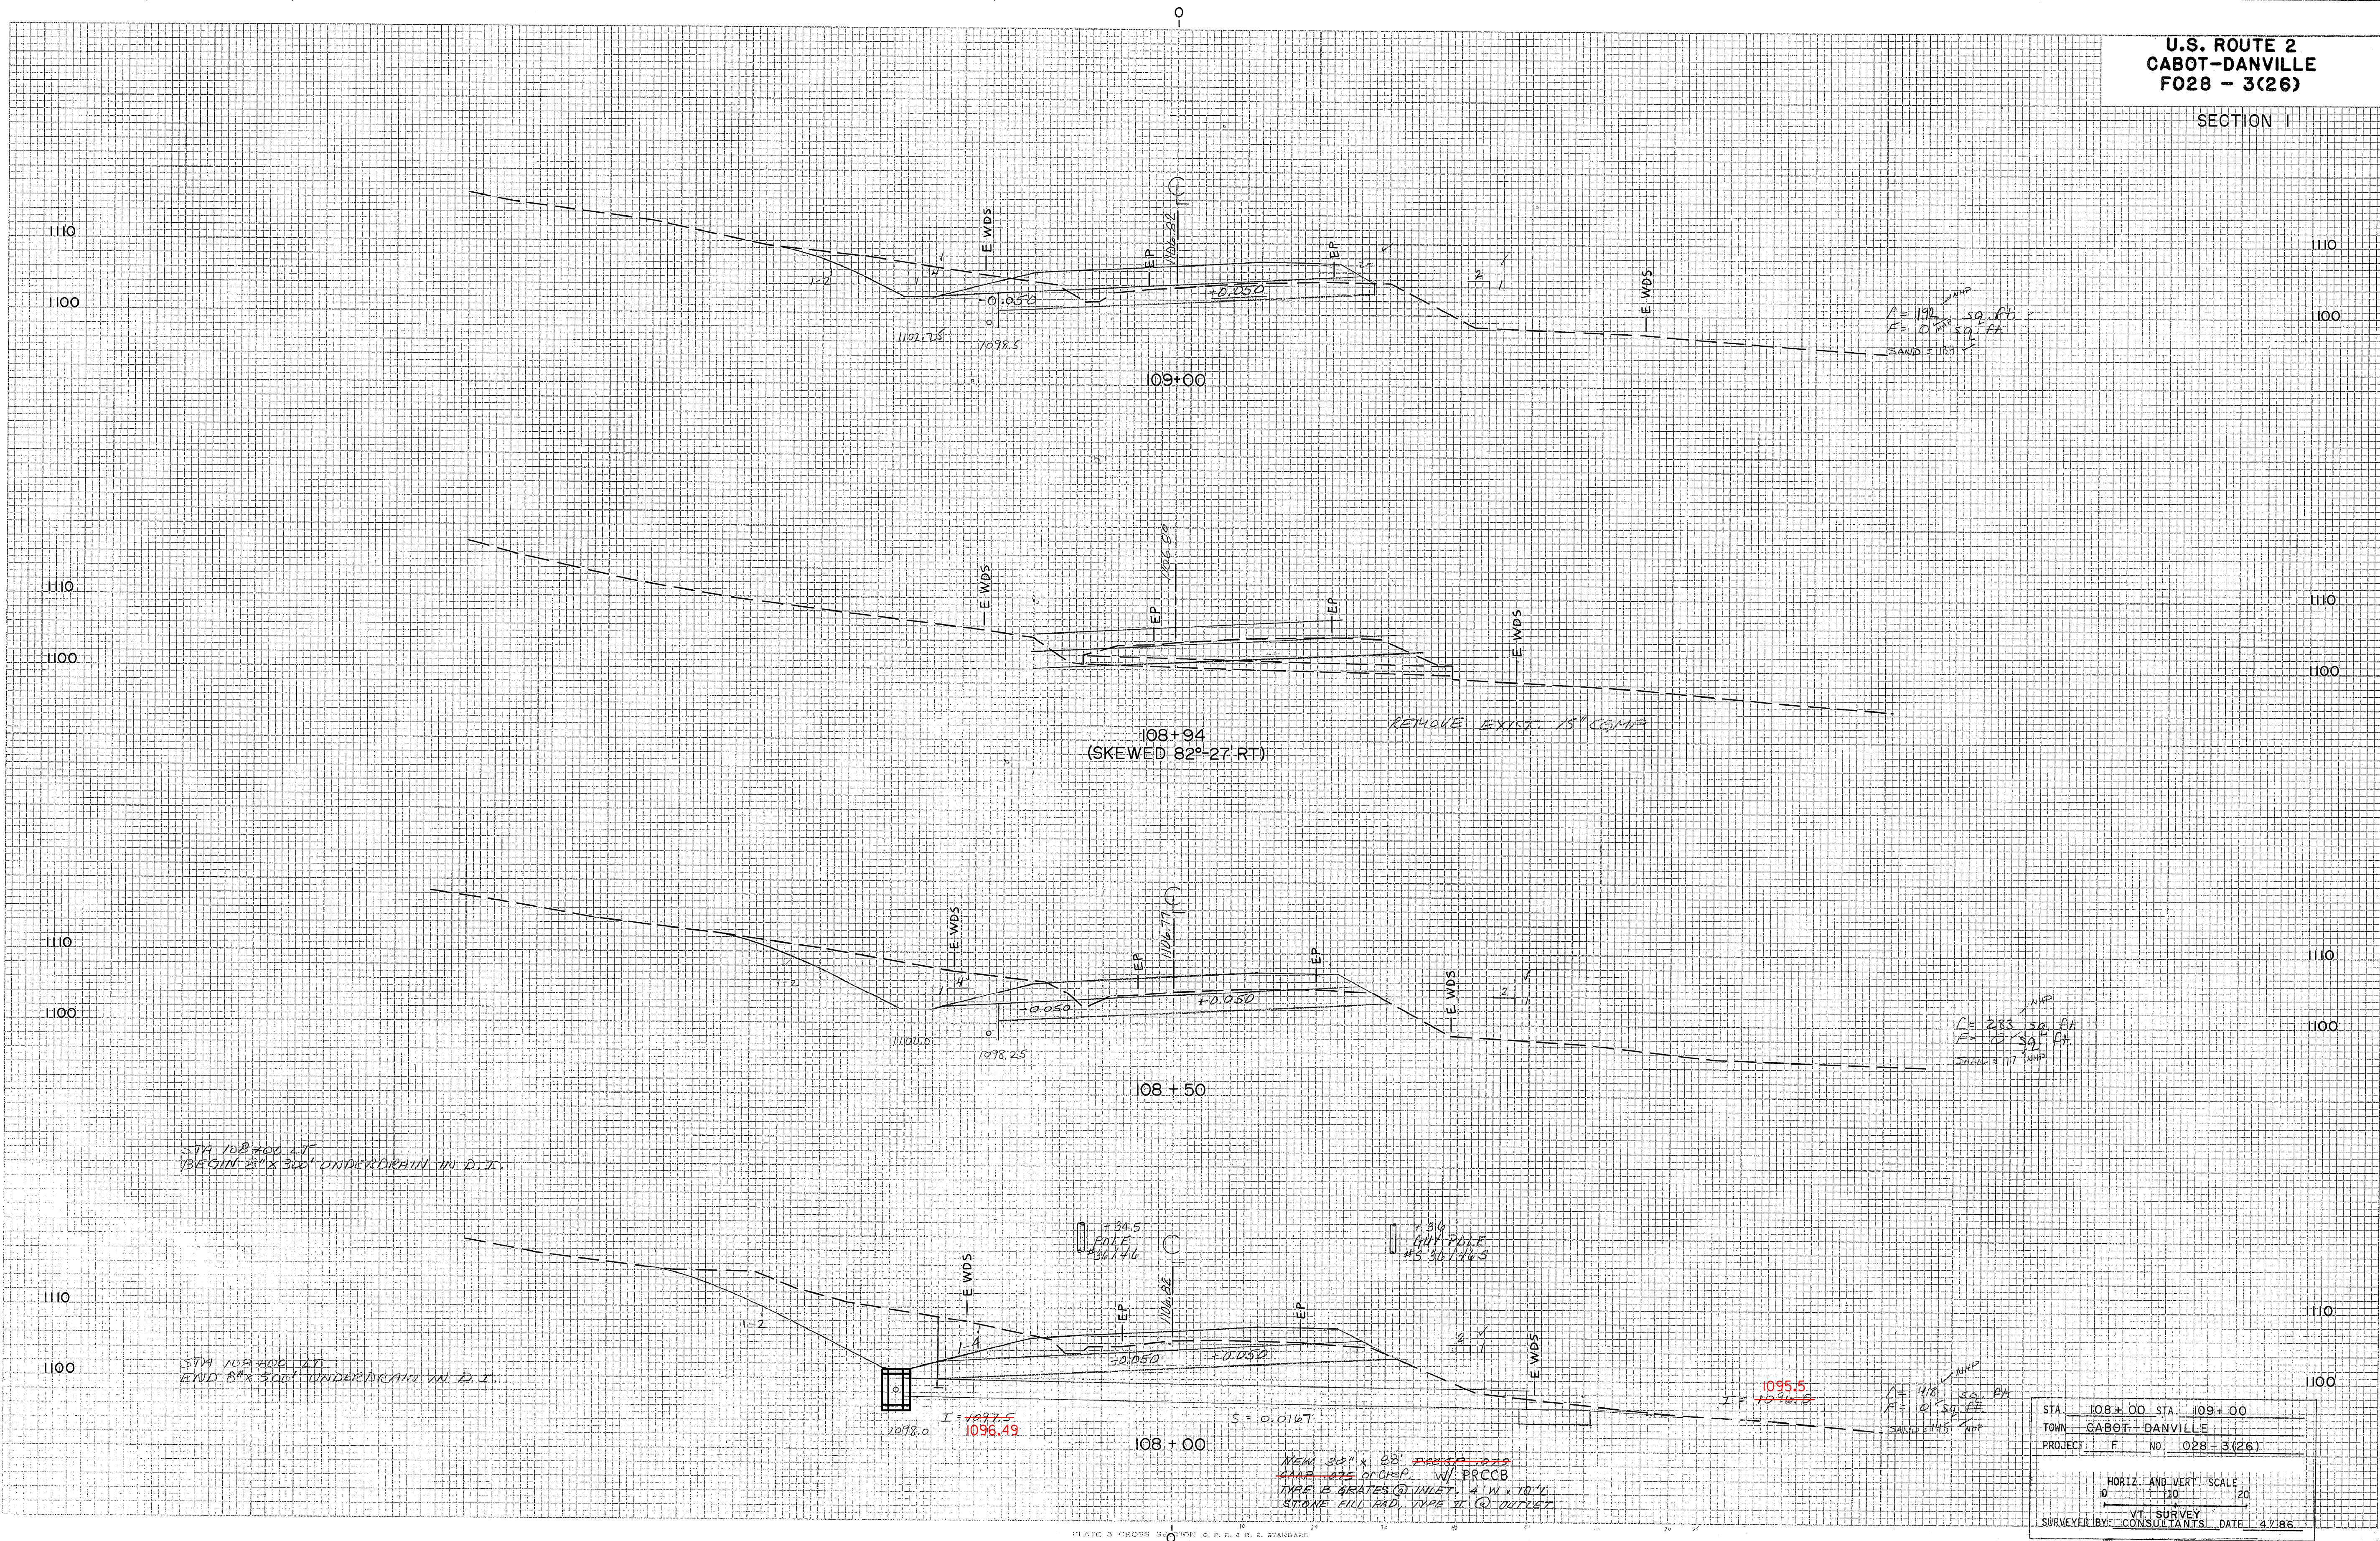

STA	108+00	STA	109+00
TOWN	CABOT-DANVILLE		
PROJECT	F No. 028-3(26)		
HORIZ. AND VERT. SCALE			
0 10 20			

PROJECT NAME: CABOT-DANVILLE
PROJECT NUMBER: FECC F 028-3(26) C/1
FILE NAME: 78d058xs.dgn
PROJECT LEADER: K. ROBBE
DESIGNED BY: I. SHEA
MAINLINE CROSS SECTIONS 7
PLOT DATE: 06-OCT-2010
DRAWN BY: I. SHEA
CHECKED BY: S. MENARD
SHEET 139 OF 250