


U.S. ROUTE 2
CABOT-DANVILLE
F028 - 3(26)

SECTION 1

PRIMAL SURVEY
NOTE BOOK
NO. 1110

VT SURVEY CONSULTANTS
BRYANT ASSOC.
DATE 4/86

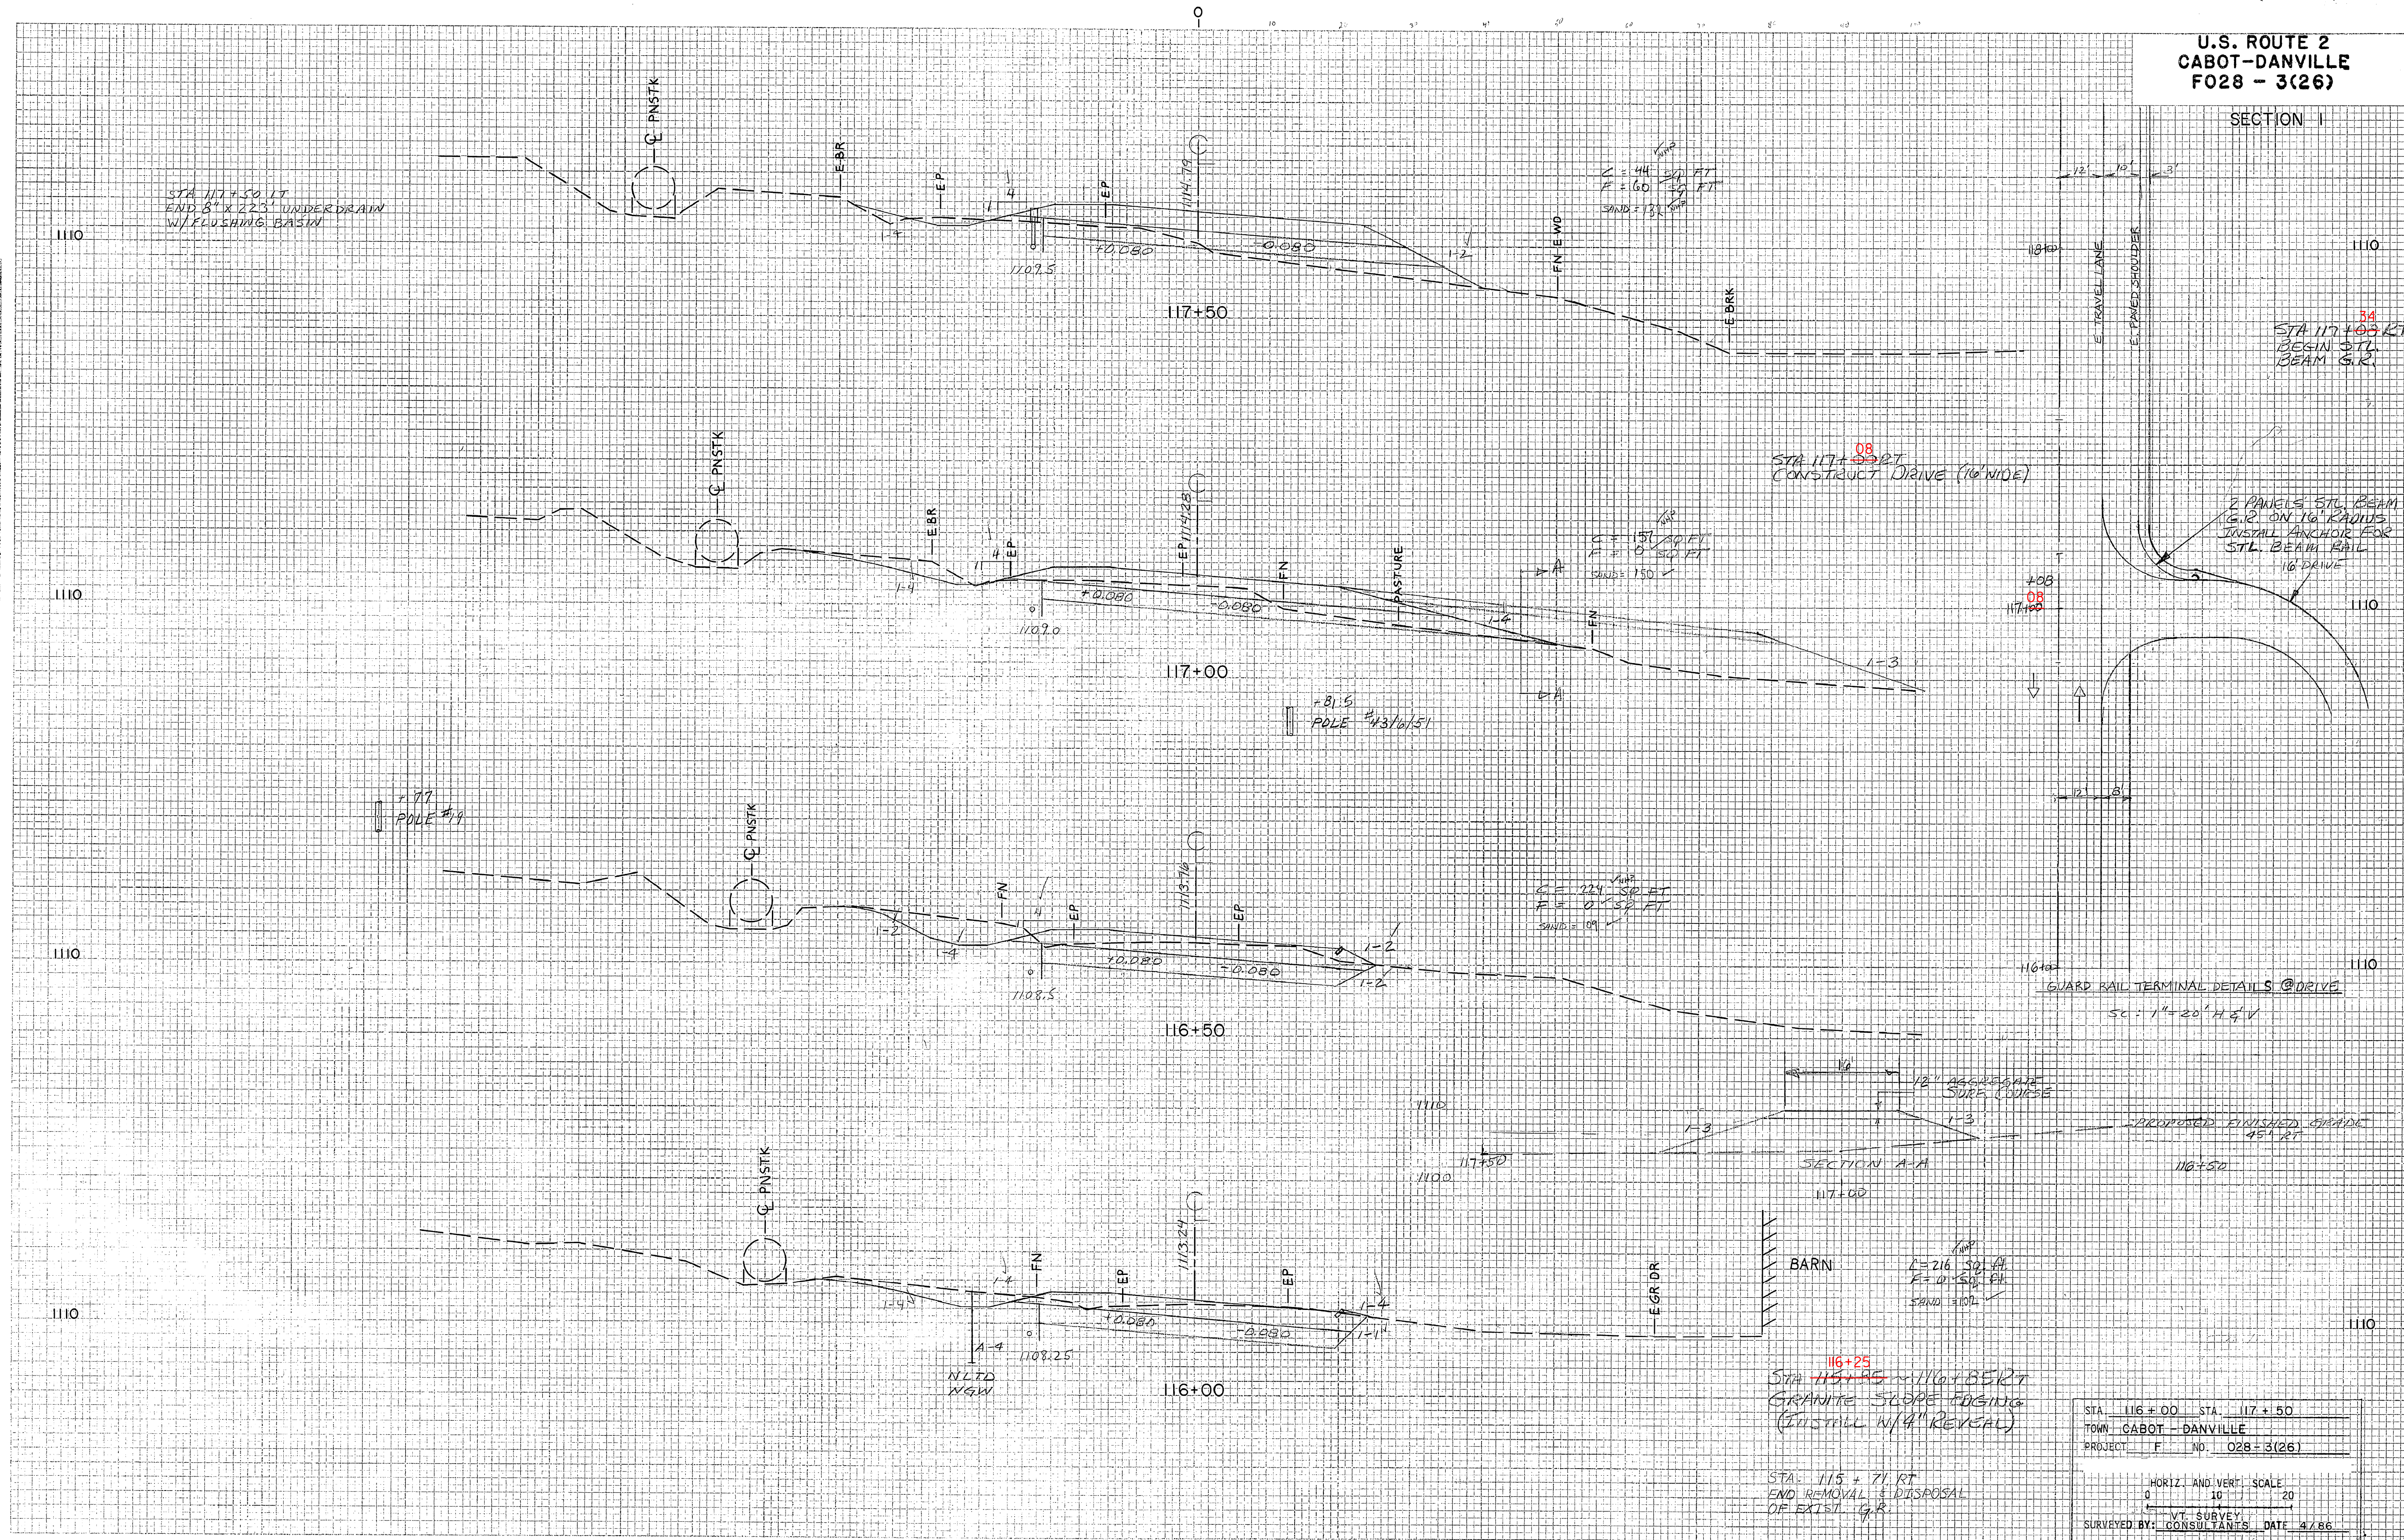

| | |
|-----------------------------------|-------------|
| STA. 116+00 | STA. 117+50 |
| TOWN CABOT-DANVILLE | |
| PROJECT F NO. 028-3(26) | |
| HORIZ. AND VERT. SCALE 0 10 20 | |
| VT. SURVEY CONSULTANTS DATE 4/86 | |

PROJECT NAME: CABOT-DANVILLE
PROJECT NUMBER: FECC F 028-3(26) C/1
FILE NAME: 78d058xs.dgn
PROJECT LEADER: K. ROBBE
DESIGNED BY: I. SHEA
MAINLINE CROSS SECTIONS 12
PLOT DATE: 06-OCT-2010
DRAWN BY: I. SHEA
CHECKED BY: S. MENARD
SHEET 144 OF 250