U.S. ROUTE 2
CABOT-DANVILLE
F028 - 3(26)
SECTION II

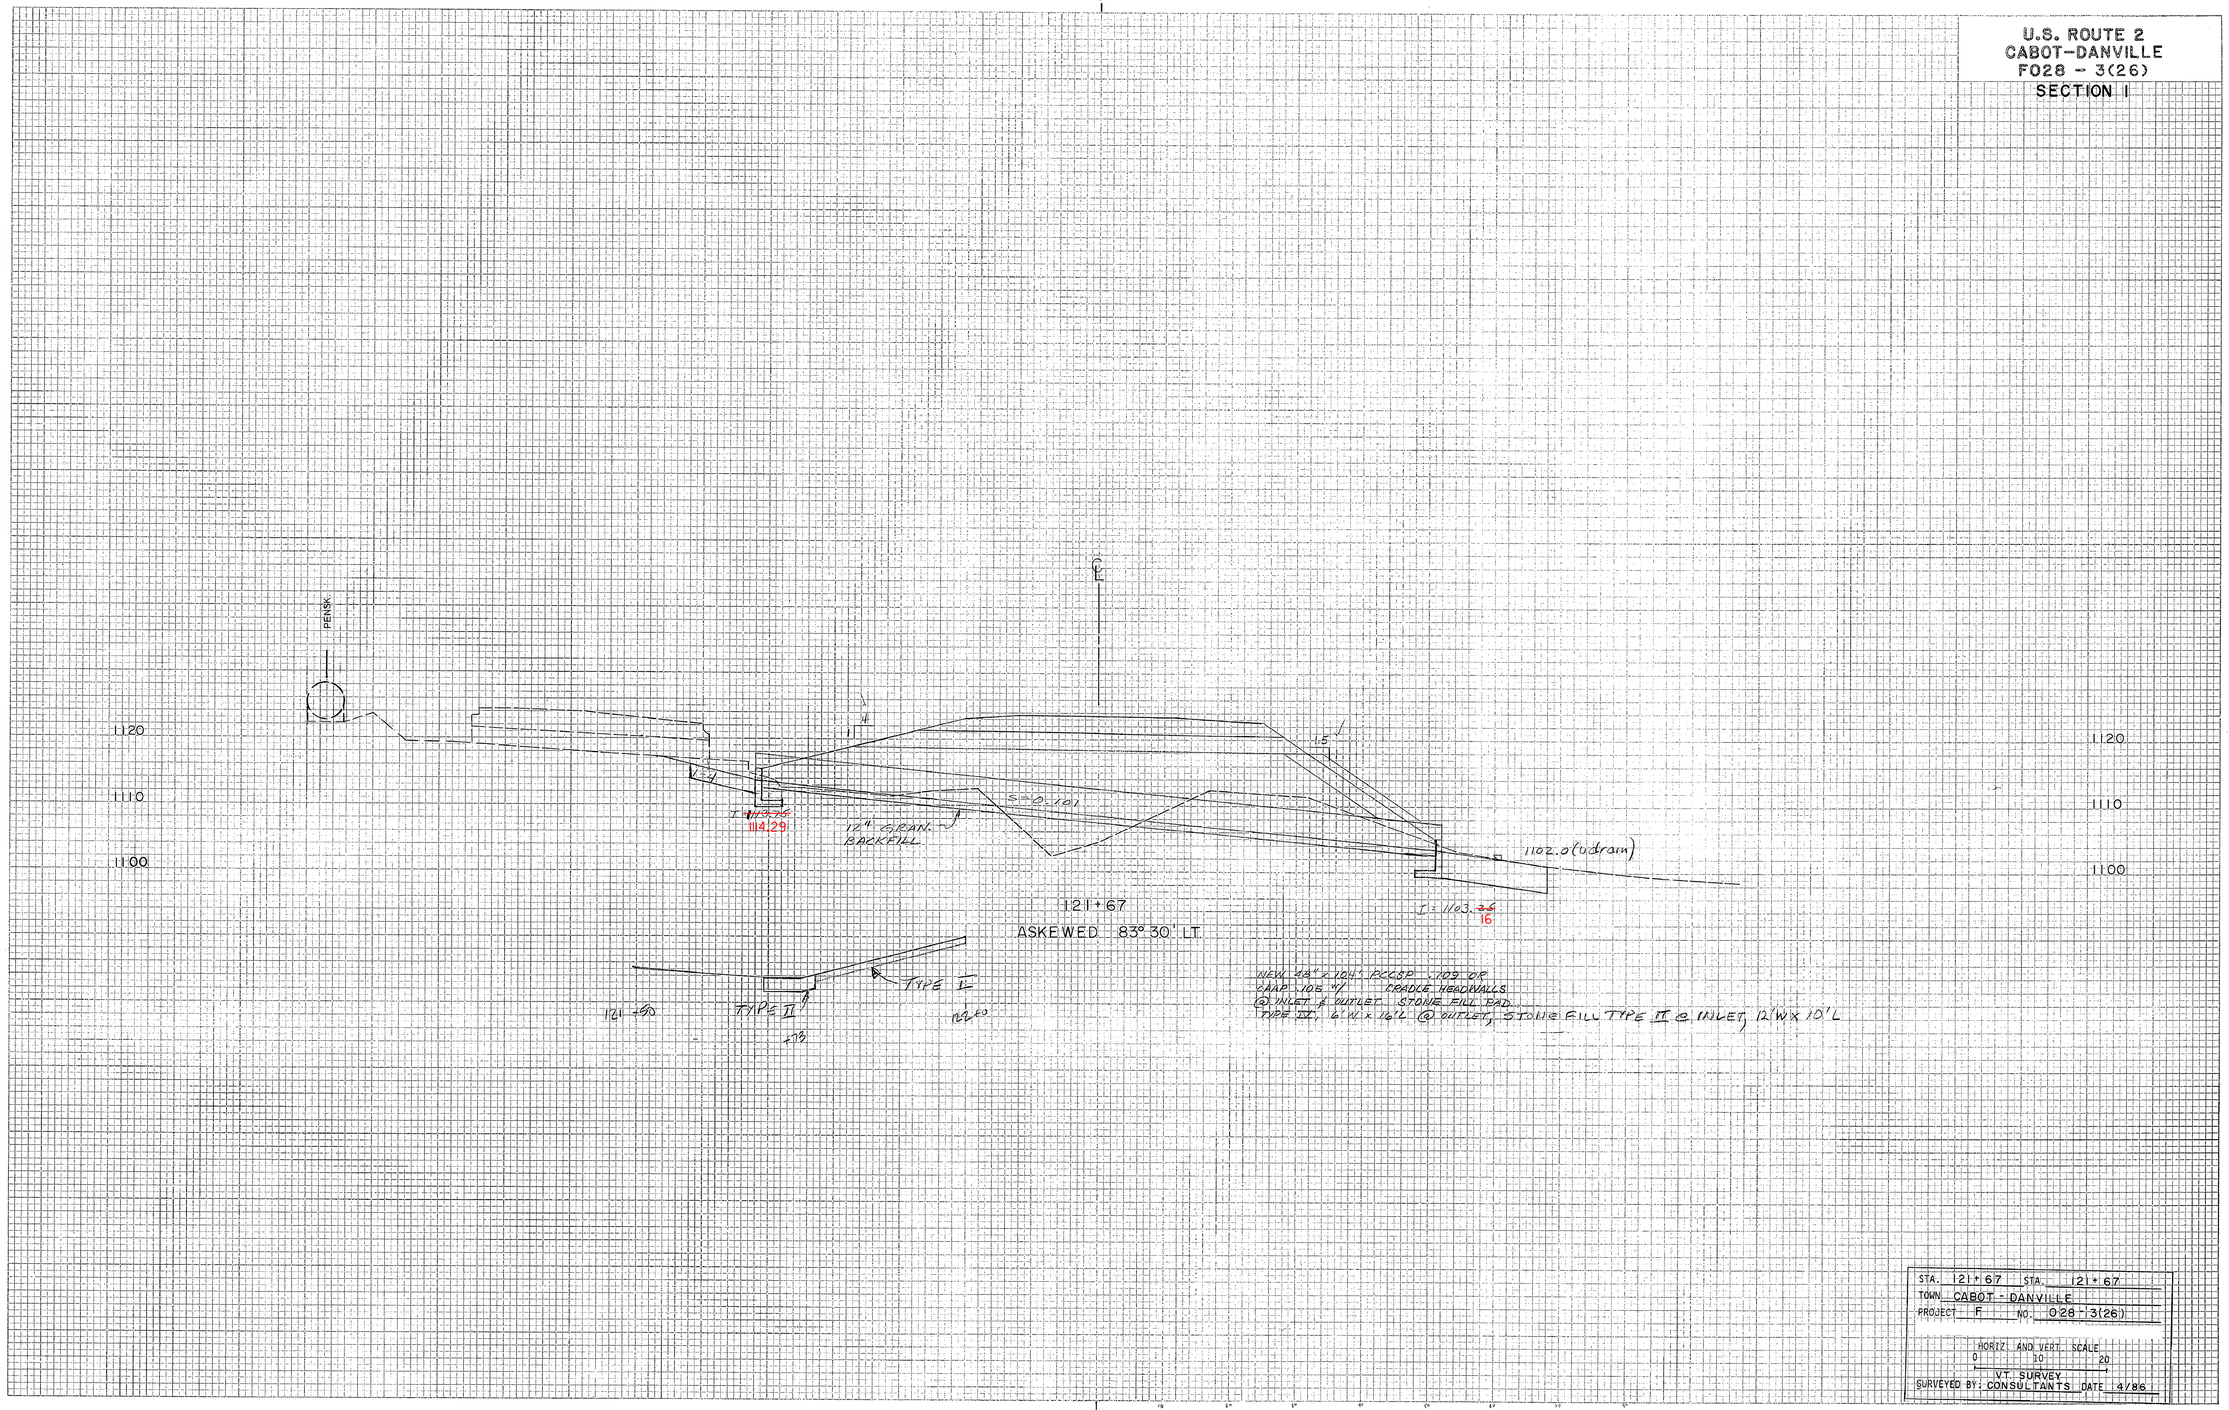

STA. 121+67	STA. 121+67
TOWN CABOT - DANVILLE	
PROJECT F	NO. 028 - 3(26)

HORIZ. AND VERT. SCALE
0 10 20
V.T. SURVEY
SURVEYED BY: CONSULTANTS DATE 4/86

PLATE 3 CROSS SECTION G. P. R. & P. & STANDARD DIVISION CORPORATION

PROJECT NAME:	CABOT-DANVILLE
PROJECT NUMBER:	FEGC F 028-3(26) C/I

FILE NAME: 78d058xs.dgn	PLOT DATE: 06-OCT-2010
PROJECT LEADER: K. ROBIE	DRAWN BY: I. SHEA
DESIGNED BY: I. SHEA	CHECKED BY: S. MENARD
MAINLINE CROSS SECTIONS 17	SHEET 149 OF 250